




Mattern & Craig
CONSULTING ENGINEERS
SUITE 401, 707 S. JEFFERSON STREET, ROANOKE, VIRGINIA 24001, (703) 345-9342

DESIGNED: CPT
CHECKED: SWH
APPROVED: SWH

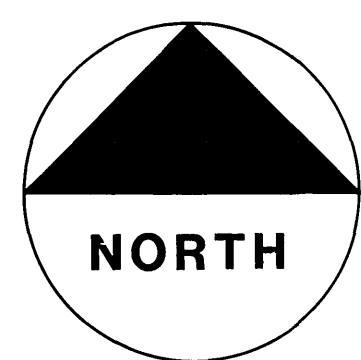

REVISION	DATE	DESCRIPTION	BY	APP.
1	9/16/93	RECORD DWG	SWH	

DATE
JULY 1983
COMM.
428

**WILLIAMSON ROAD STORM DRAIN-PHASE 1
CONTRACT II**
ROANOKE, VIRGINIA
INDEX MAP

SHEET
4