

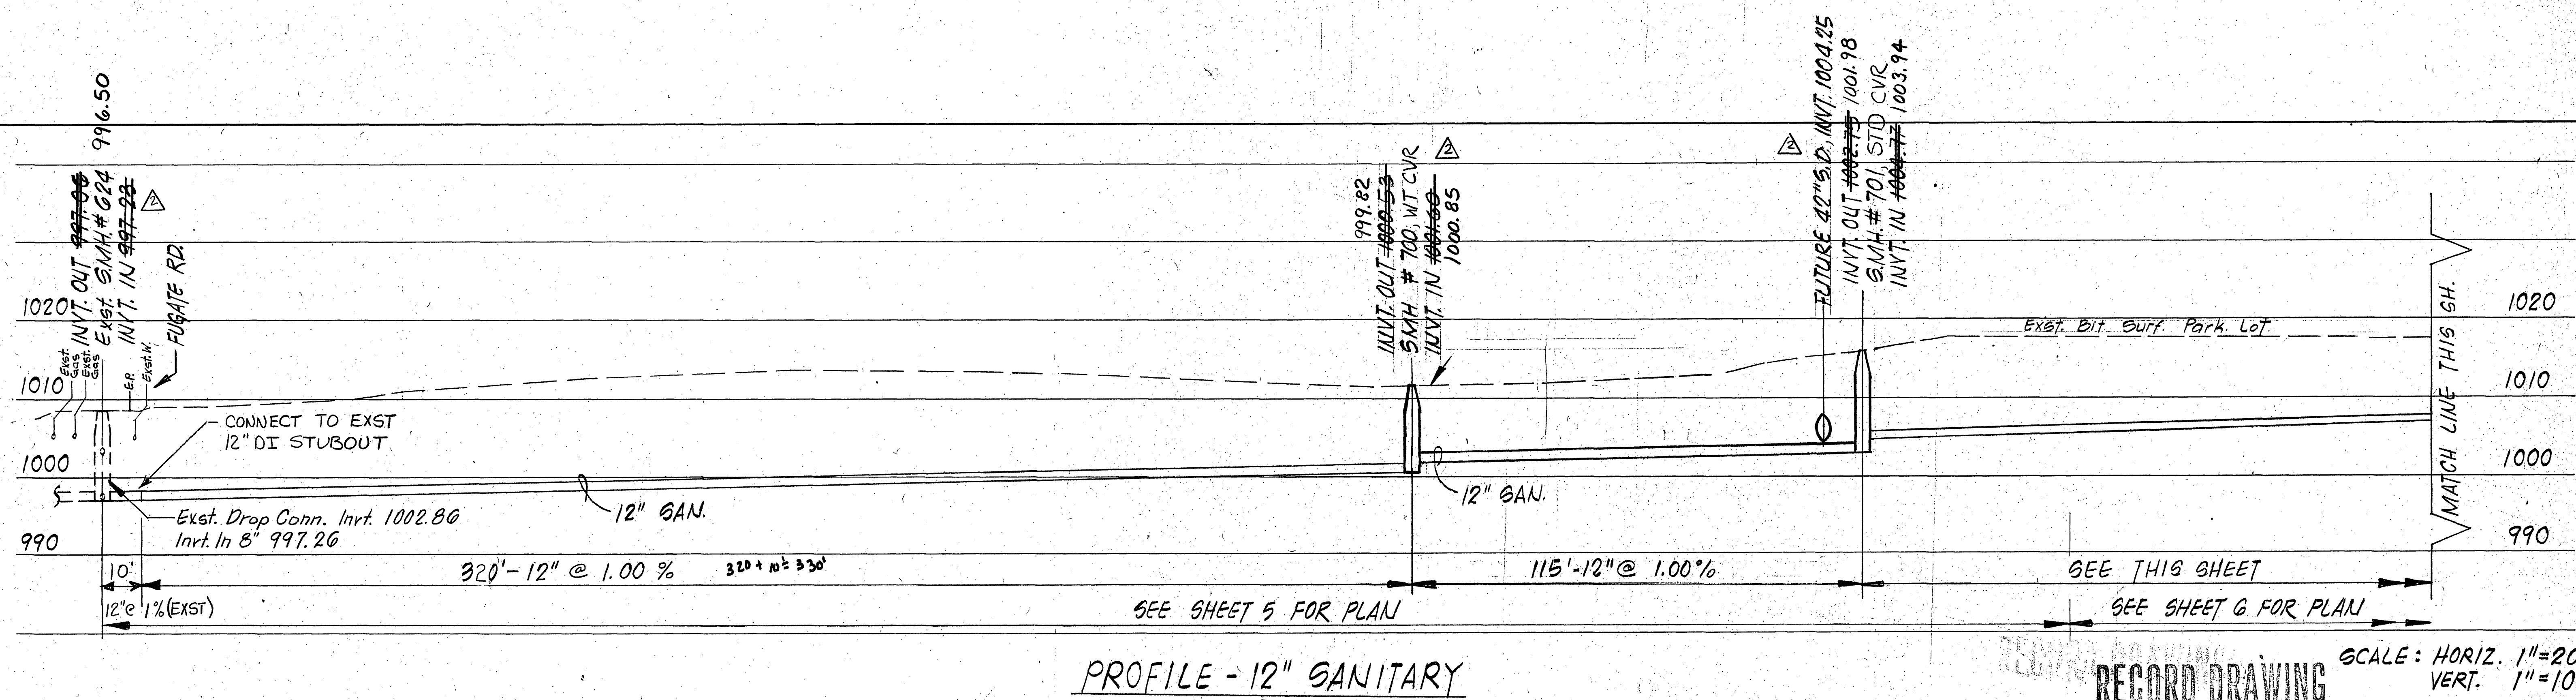


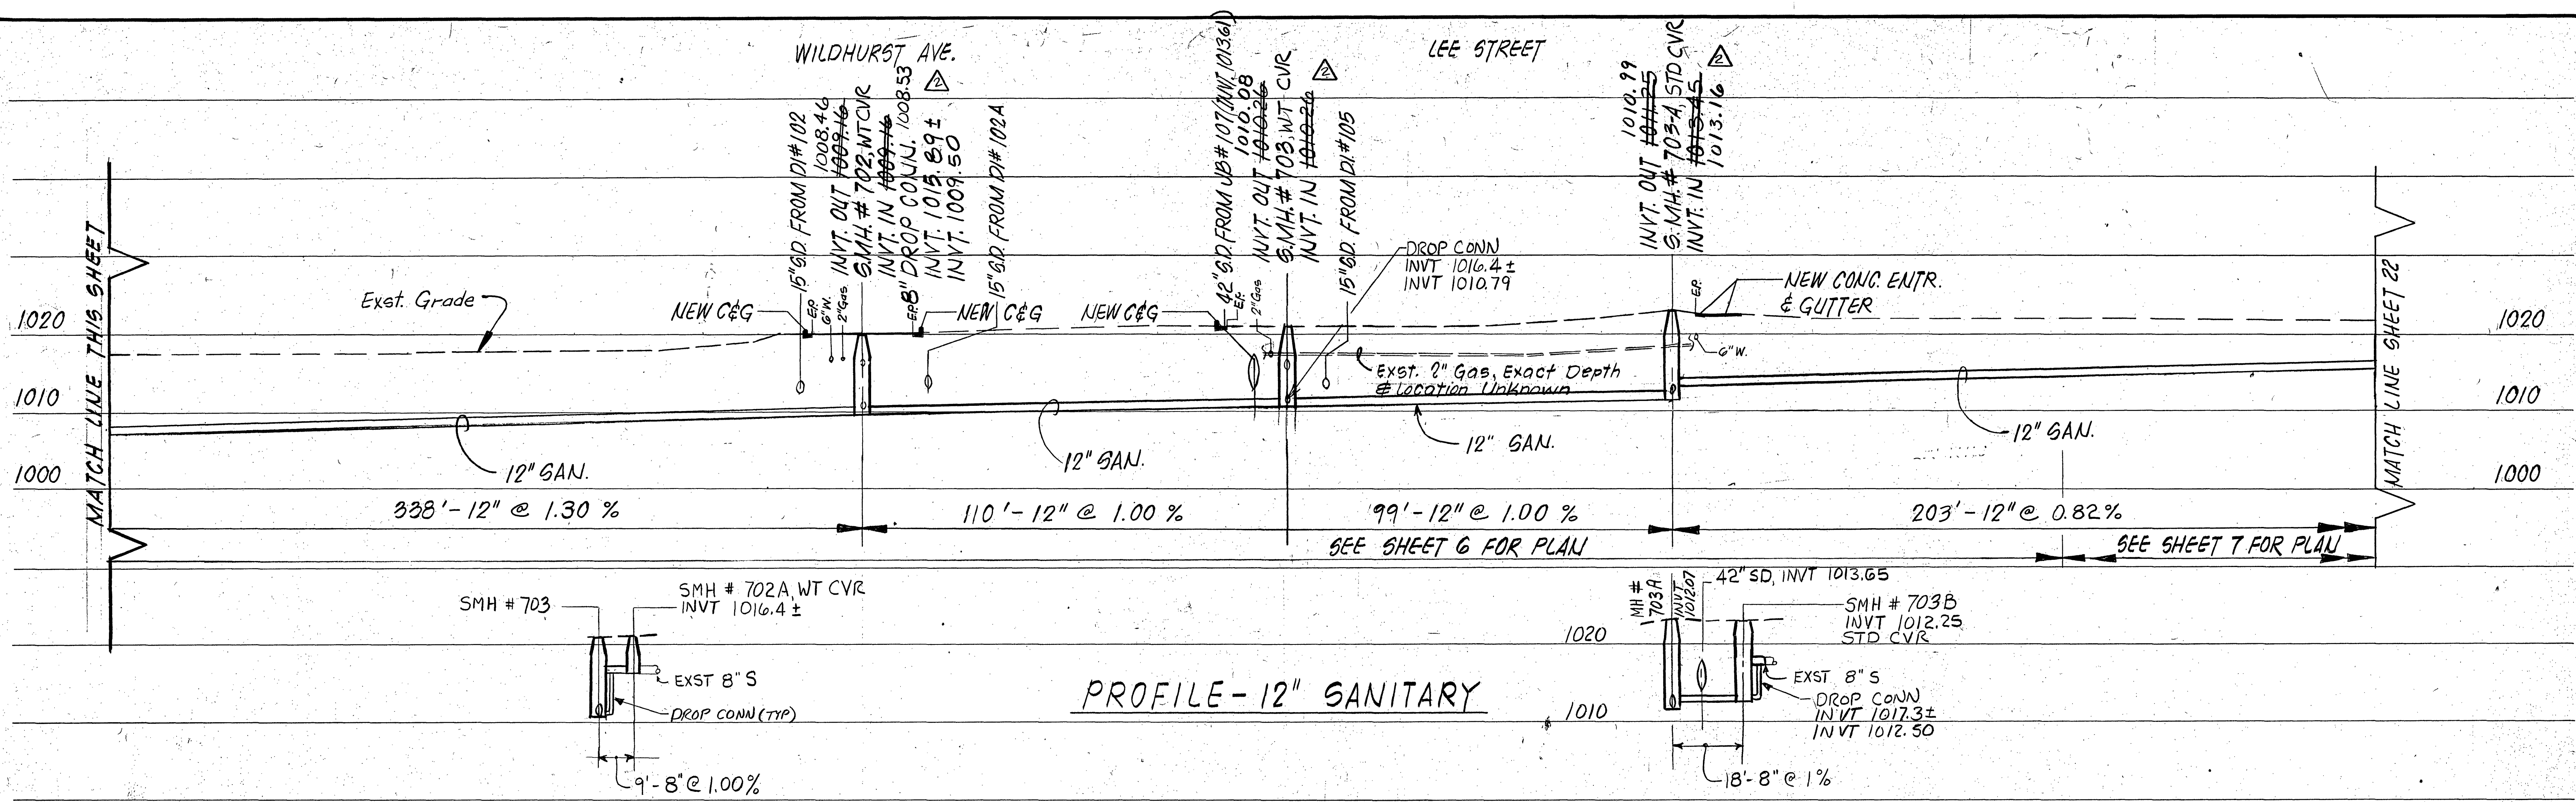

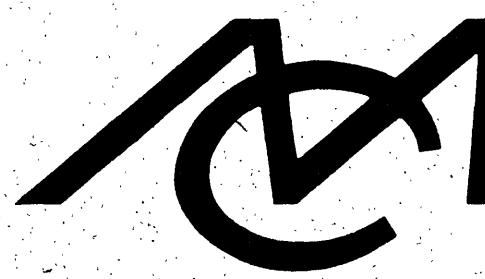


Mattern & Craig
CONSULTING ENGINEERS
SUITE 401, 707 S. JEFFERSON STREET, ROANOKE, VIRGINIA 24011 (703) 345-9342

DESIGNED: JWC

CHECKED: SWH

APPROVED:

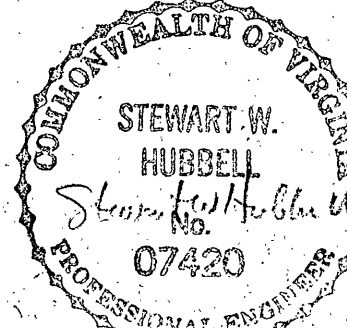

REVISION	DATE	DESCRIPTION	BY	APP.
1	1-9-86	REV INVT	SWH	SWH
2	9/16/88	RECORD DWG	SWH	SWH

DATE
JULY 1983

COMM.
428

WILLIAMSON ROAD STORM DRAIN - PHASE 1

CONTRACT II

ROANOKE, VIRGINIA

SANITARY SEWER PROFILES

SHEET

21