
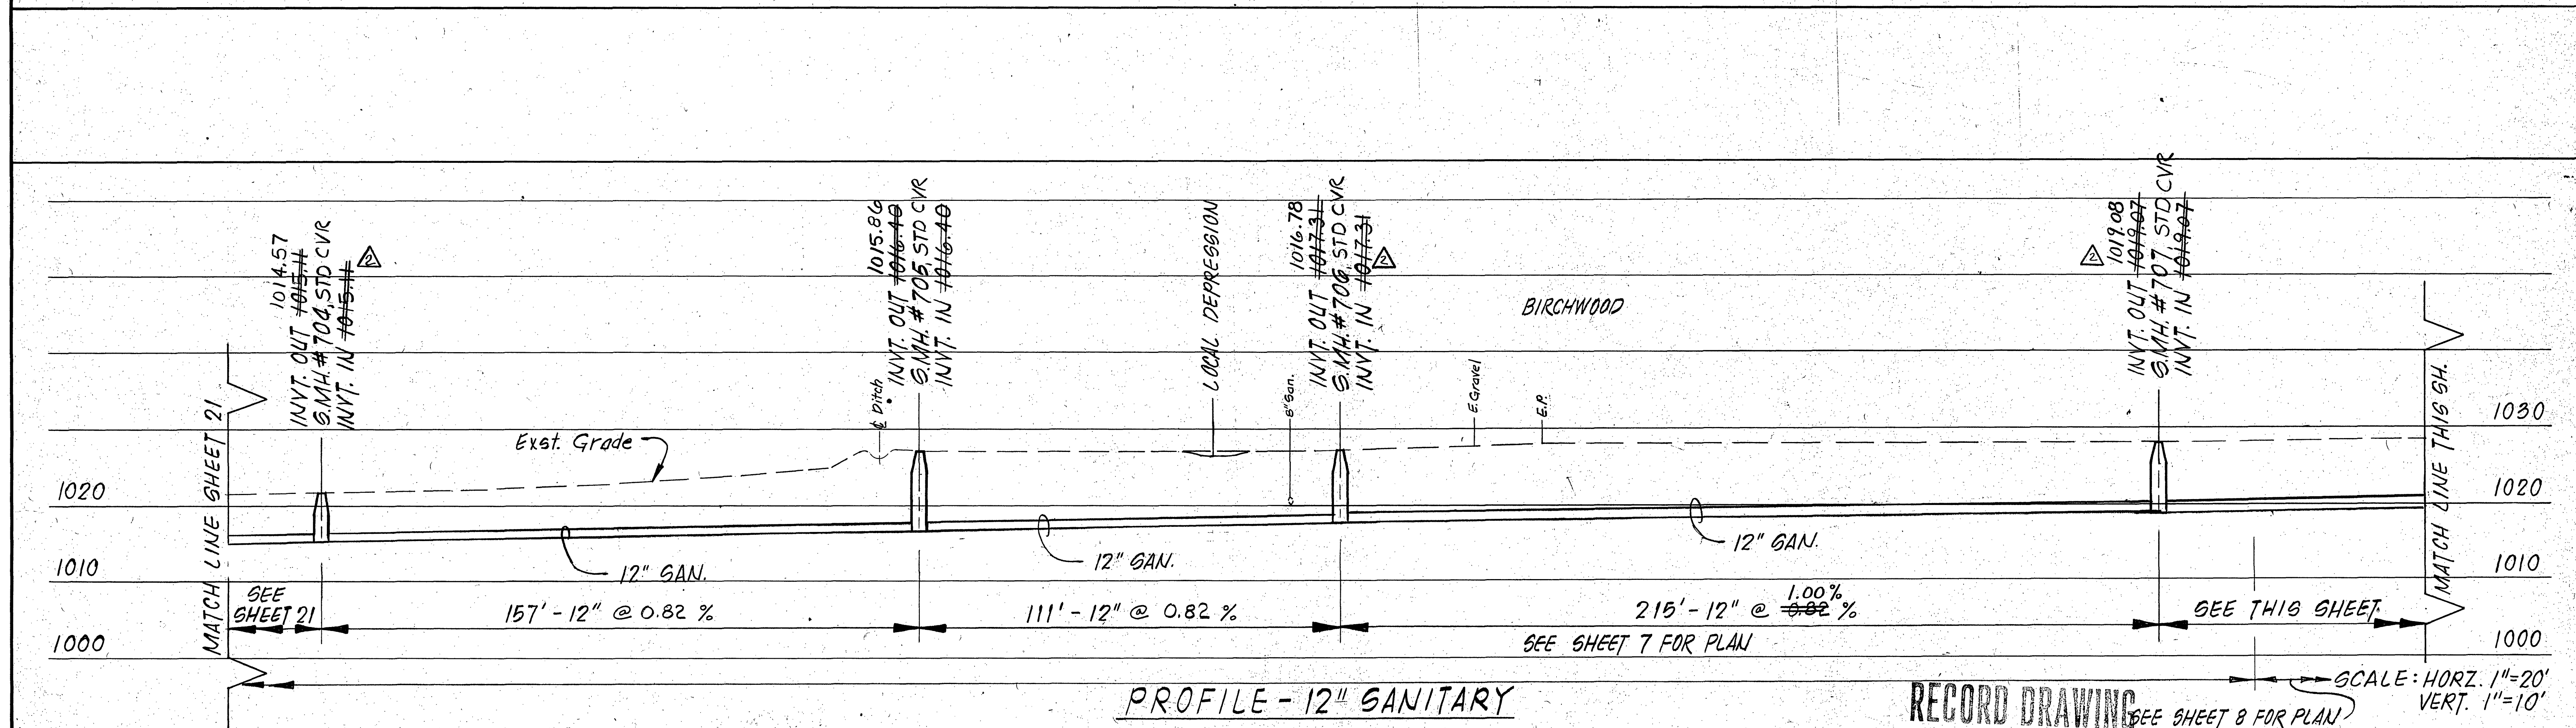


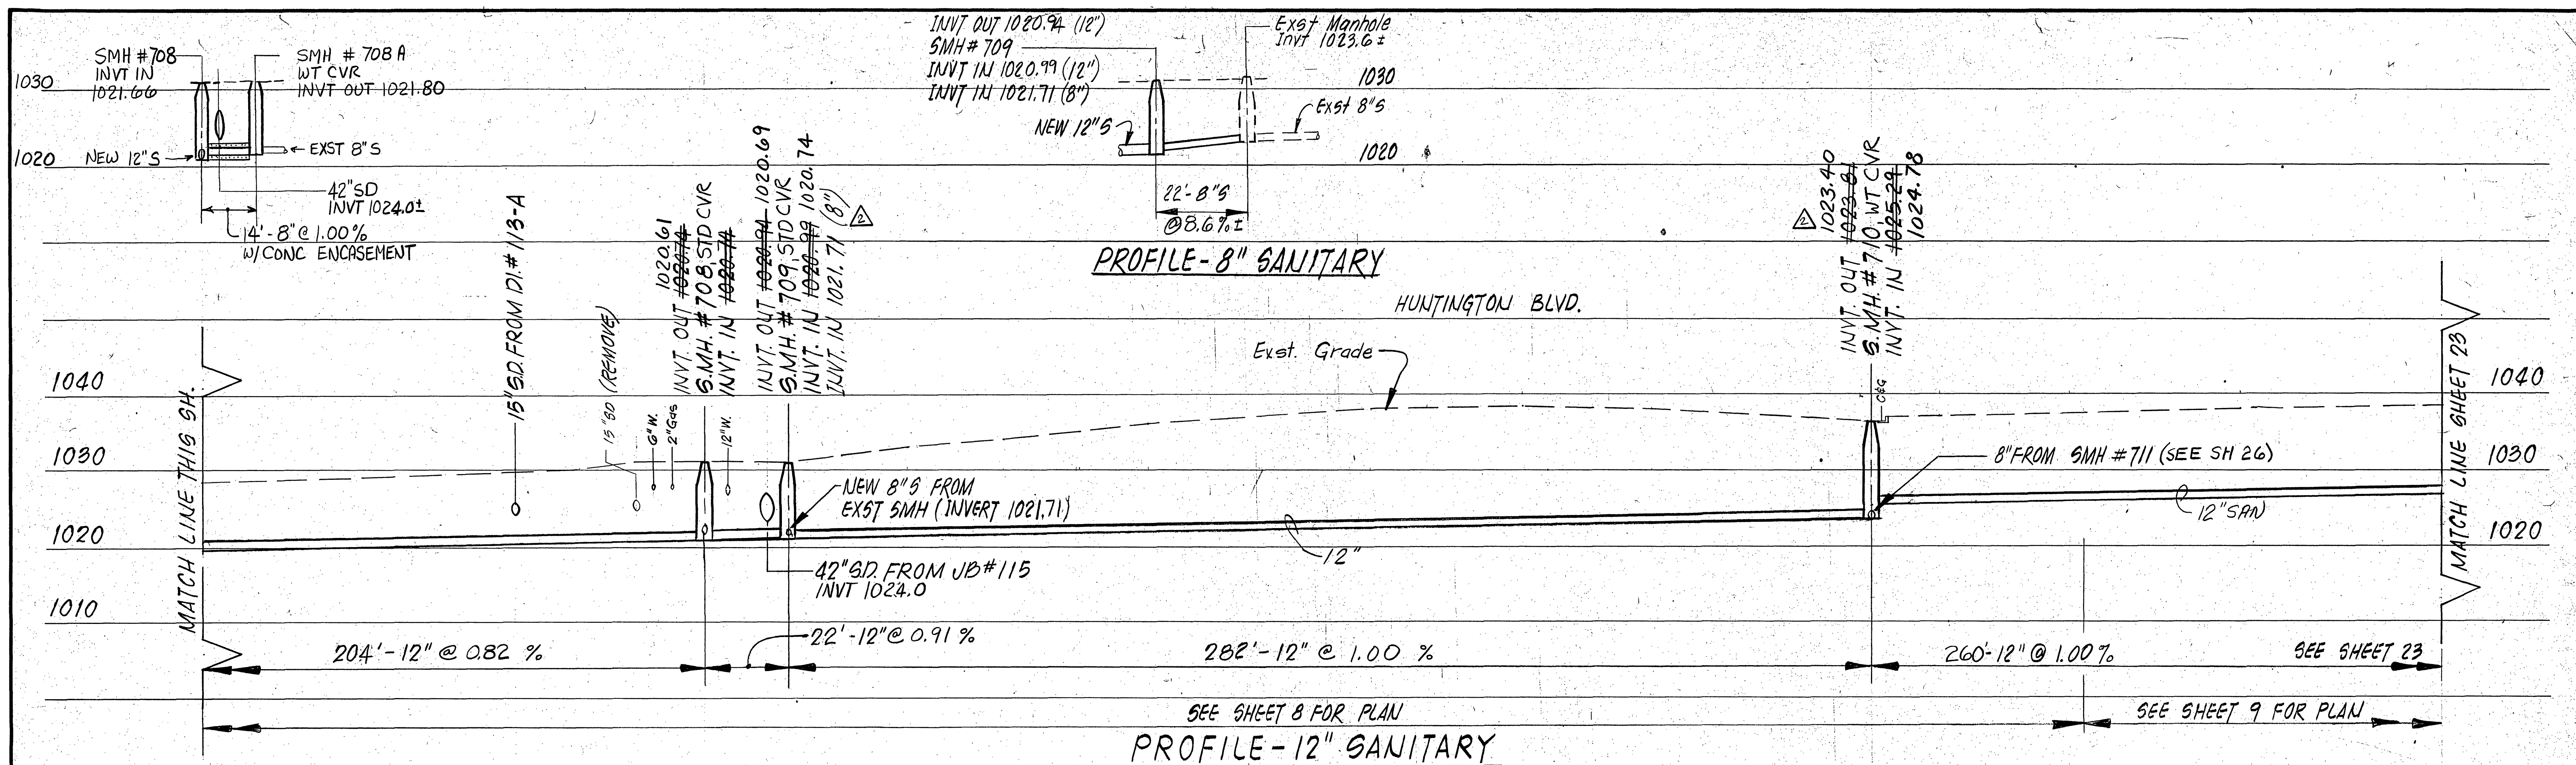

 Mattern & Craig CONSULTING ENGINEERS SUITE 401 707 S. JEFFERSON STREET ROANOKE, VIRGINIA 24011 (703) 345-9342	DESIGNED: JWC		REVISION	DATE	DESCRIPTION	BY	APP.	DATE	WILLIAMSON ROAD STORM DRAIN - PHASE 1 CONTRACT II ROANOKE, VIRGINIA SANITARY SEWER PROFILES	SHEET 22
	CHECKED: SWH		1-9-86	REV. INVTs				JULY 1983		
	APPROVED:		9/16/88	RECORD DWG				COMM. 428		