



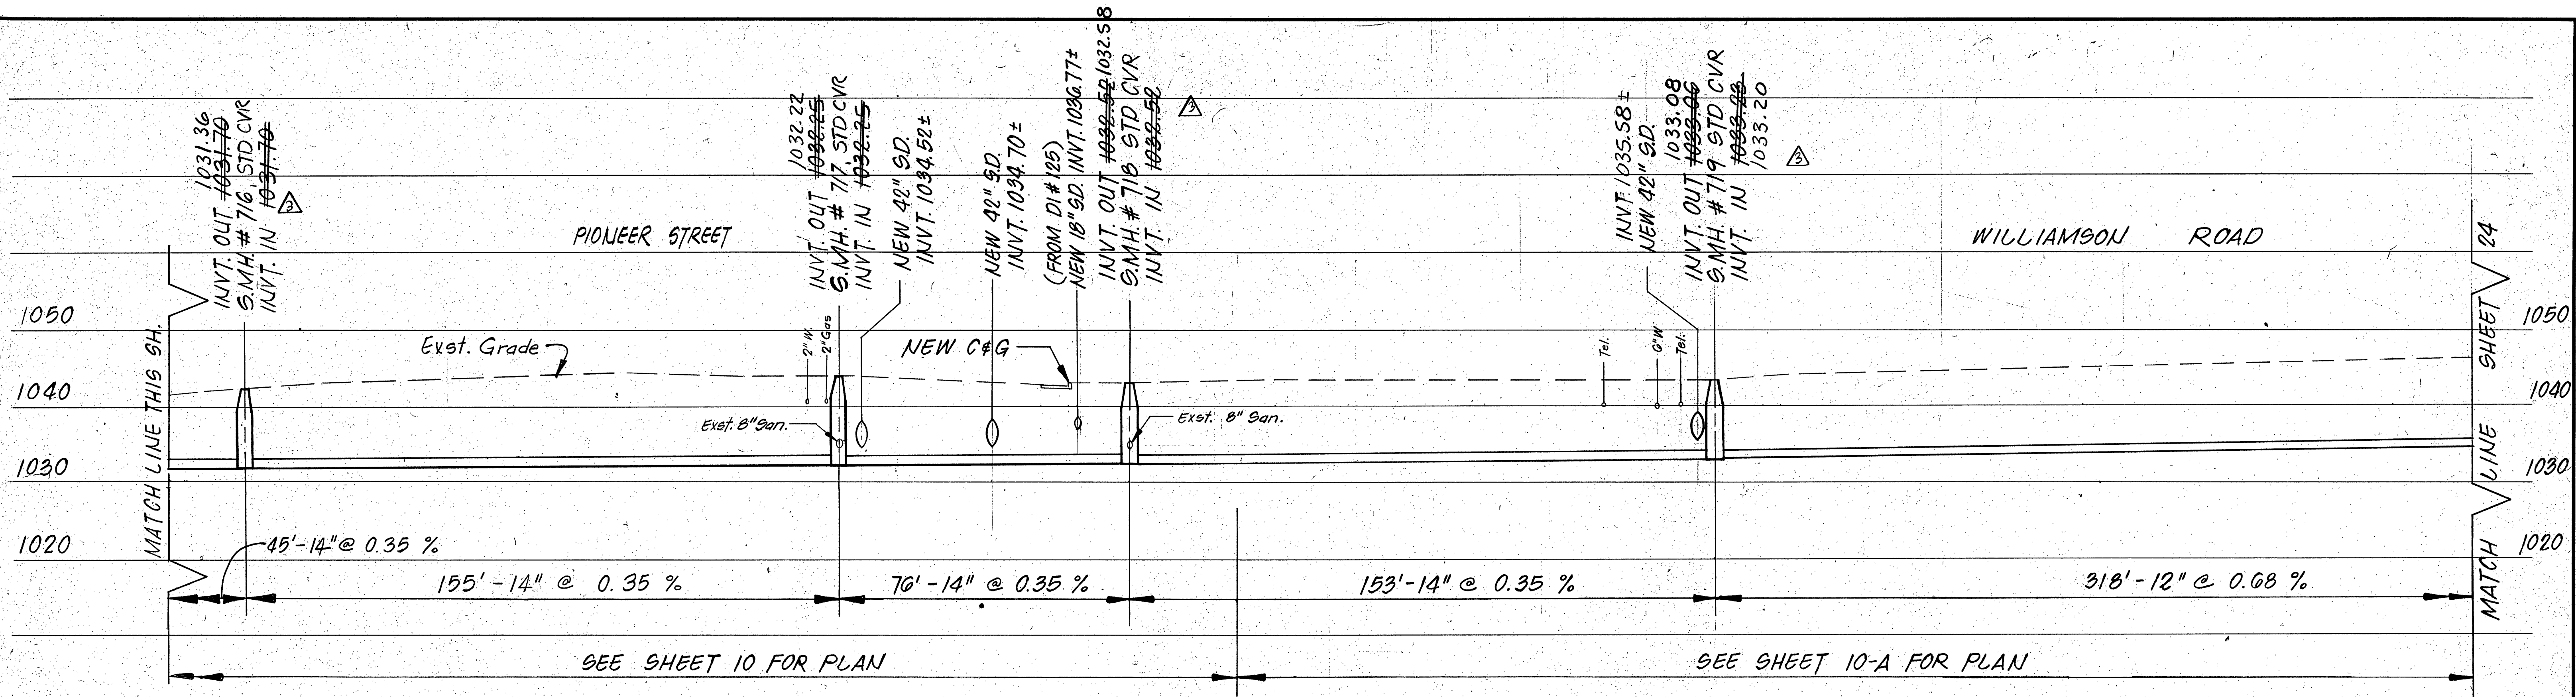

PROFILE - 14" SANITARY

SCALE: HORIZ. 1"=20'
VERT. 1"=10'

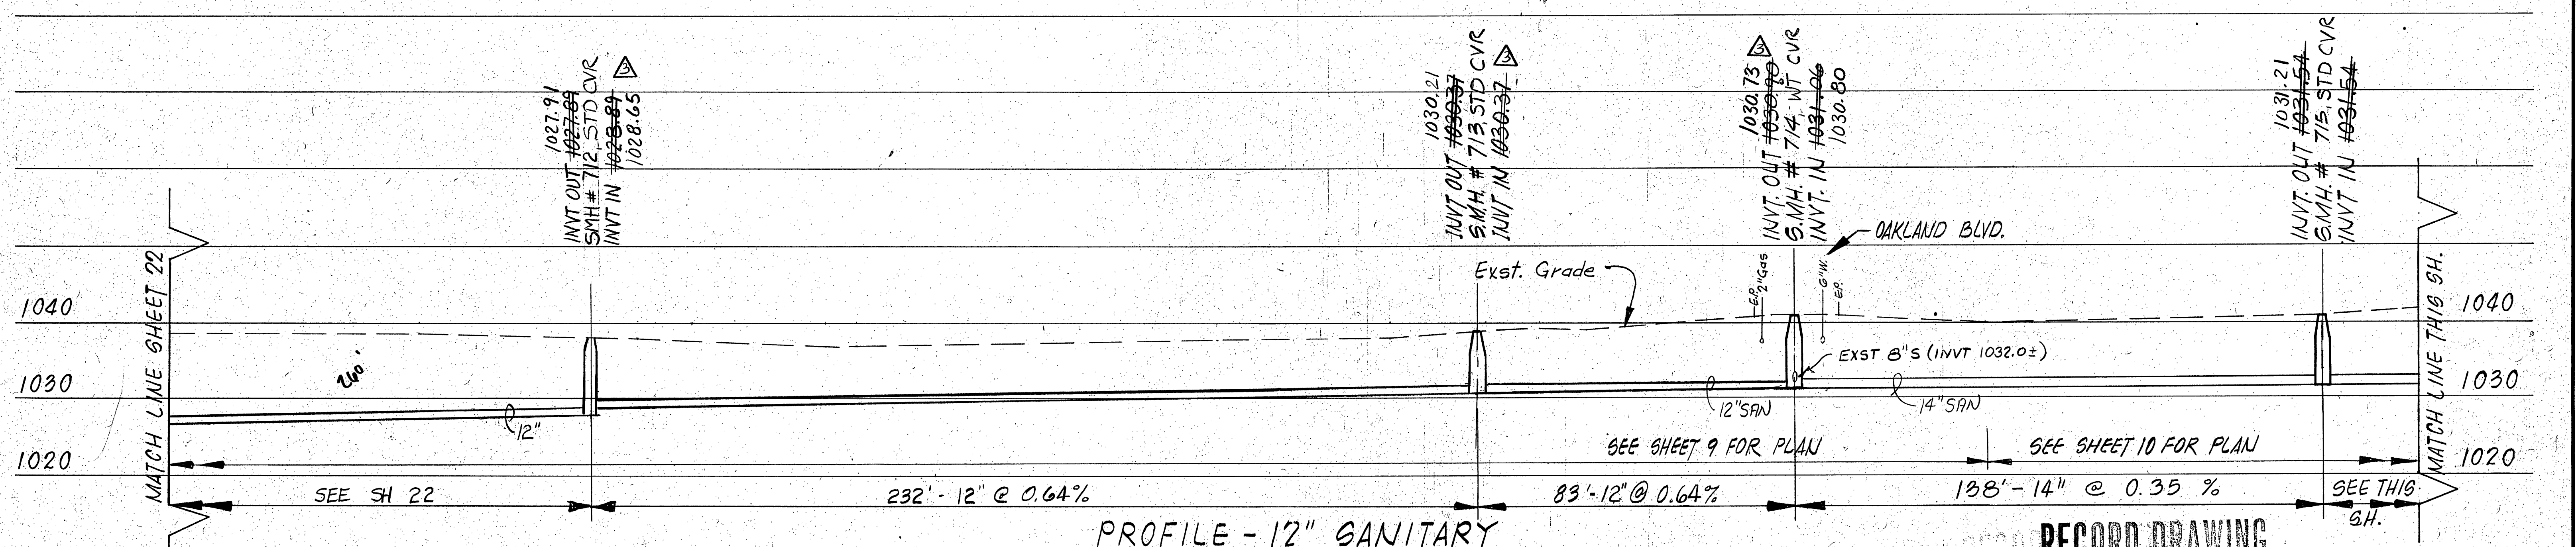

PROFILE - 12" SANITARY

RECORD DRAWING

Mattern & Craig
CONSULTING ENGINEERS
SUITE 401, 707 S. JEFFERSON STREET, ROANOKE, VIRGINIA 24011, 703.345.0342

DESIGNED: JWC
CHECKED: Stewart W. Hubbell
APPROVED:

REVISION	DATE	DESCRIPTION	BY	APP.
1	1-11-86	REV SIZES & INVT	SWH	
2	4-4-86	REV. INVT'S.	ARB	
3	9/16/88	RECORD DWG	SWH	

DATE
JULY 1983
COMM.
428

WILLIAMSON ROAD STORM DRAIN - PHASE 1
CONTRACT II
ROANOKE, VIRGINIA
SANITARY SEWER PROFILES

SHEET
23