



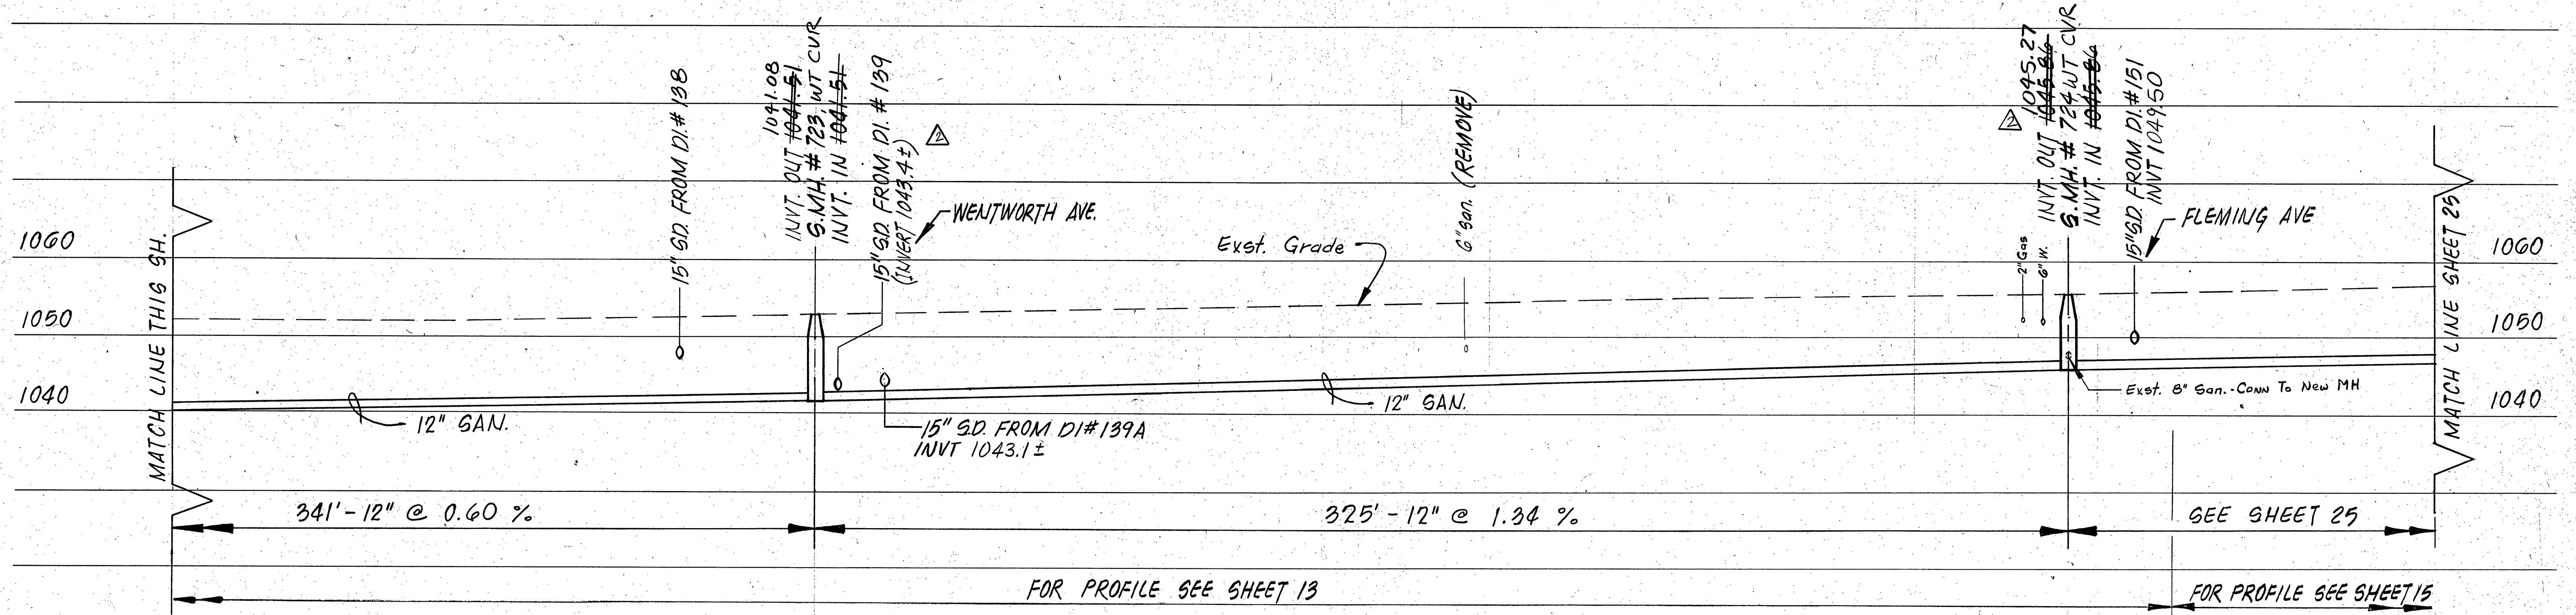

PROFILE - 12" SANITARY

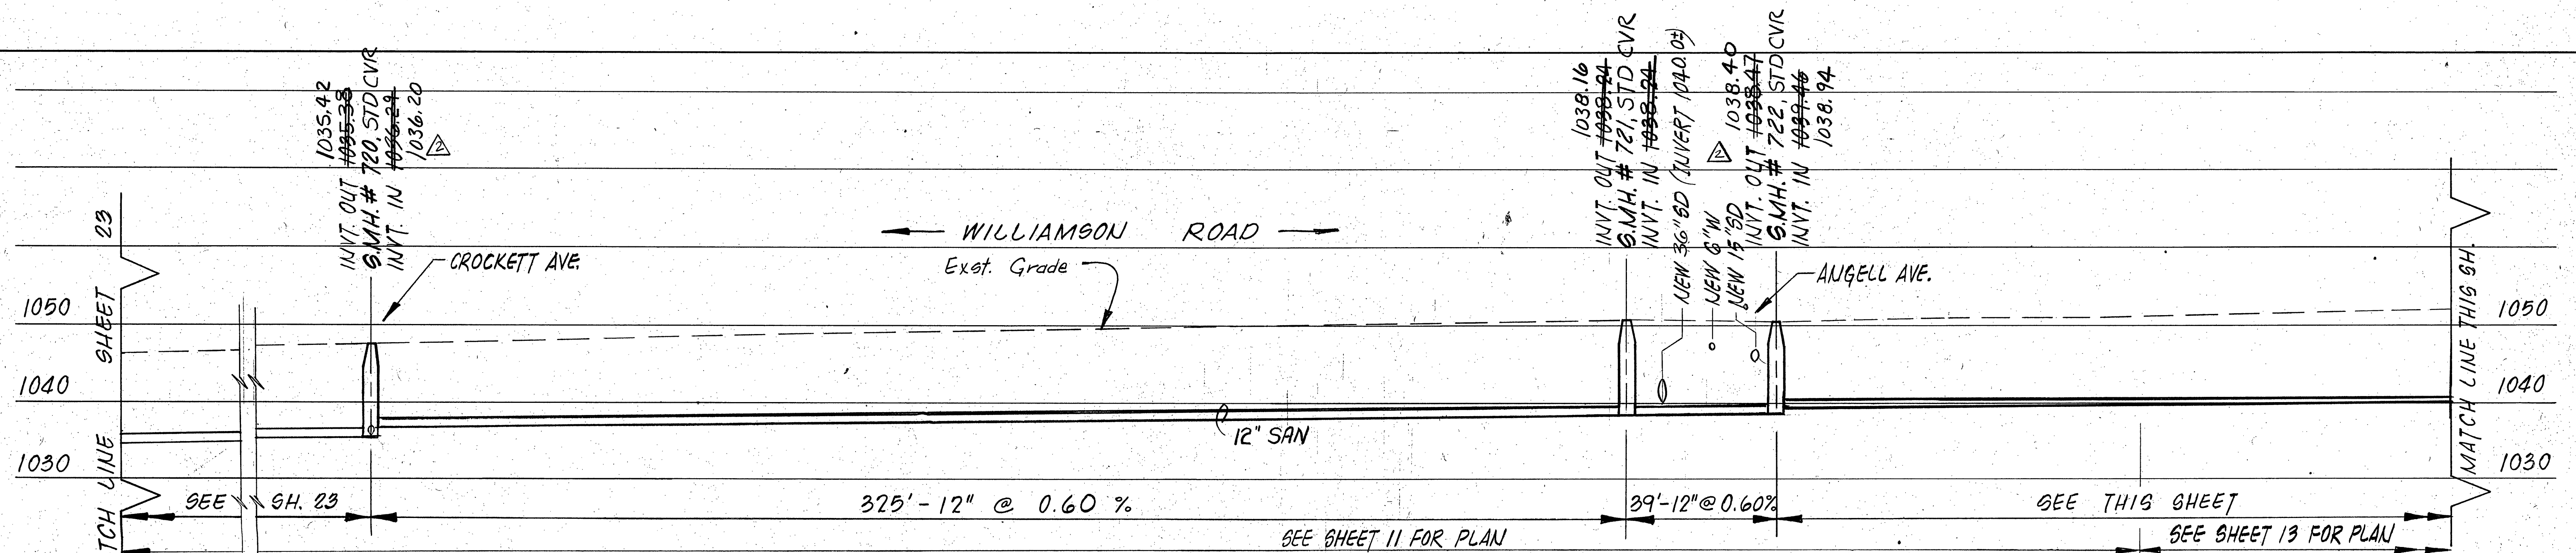


PROFILE - 12" SANITARY

RECORD DRAWING SCALE: HORZ. 1" = 20'
VERT. 1" = 10'



DESIGNED: JWC
CHECKED: SWH
APPROVED:

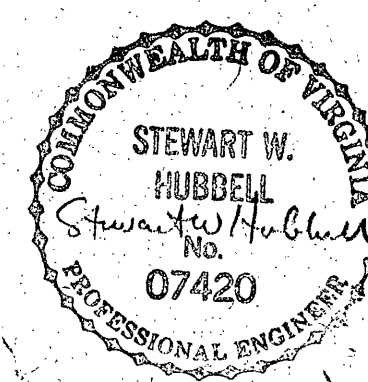

REVISION	DATE	DESCRIPTION	BY	APP.
1	1-11-86	REV PIPE SLOPES	SWH	
2	9/16/88	RECORD DWG	SWH	

DATE
JULY
1983
COMM.
428

WILLIAMSON ROAD STORM DRAIN - PHASE 1
CONTRACT II
ROANOKE, VIRGINIA
SANITARY SEWER PROFILES

SHEET
24