

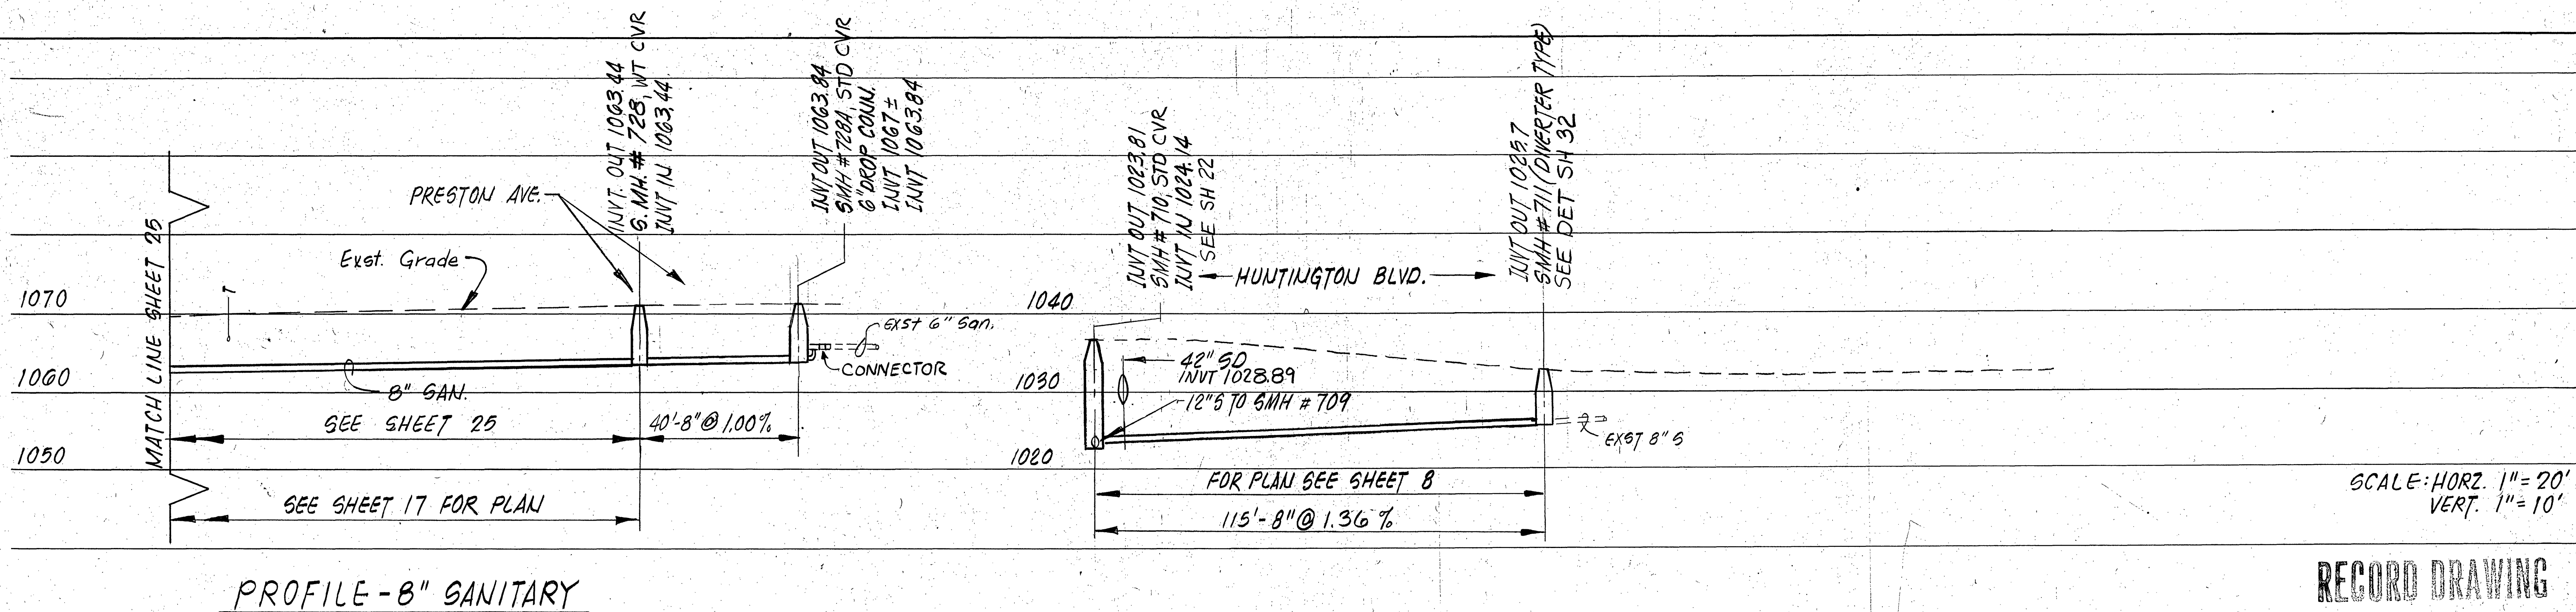


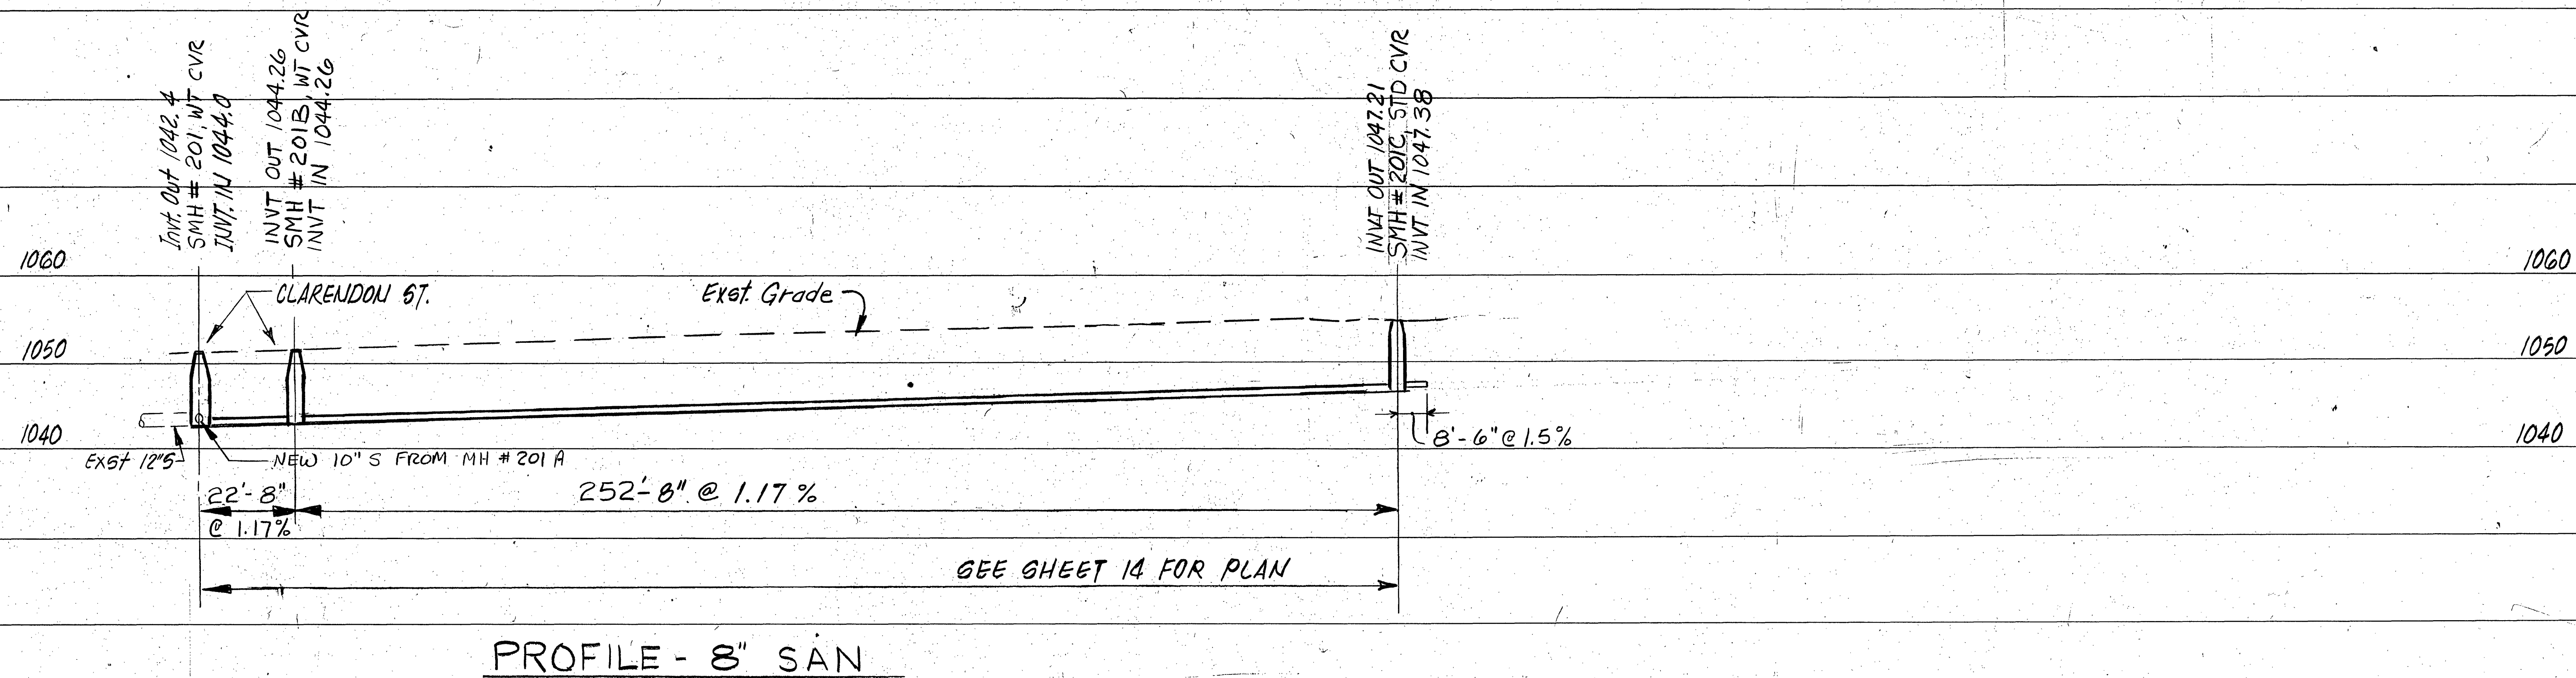

DESIGNED:
JWC
CHECKED:
SWH
APPROVED:

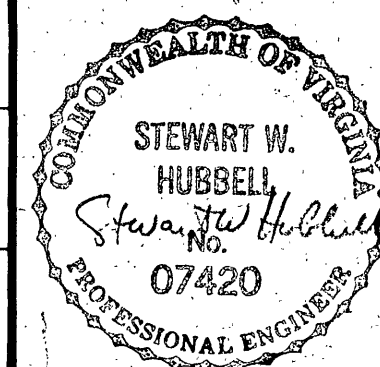

REVISION	DATE	DESCRIPTION	BY	APP
1	1-11-86	REV. INVERTS		SWH
2	9/16/88	RECORD DWG		SWH

DATE
JULY
1983
COMM.
428

WILLIAMSON ROAD STORM DRAIN - PHASE 1
CONTRACT II
ROANOKE, VIRGINIA
SANITARY SEWER PROFILES

SHEET
26