



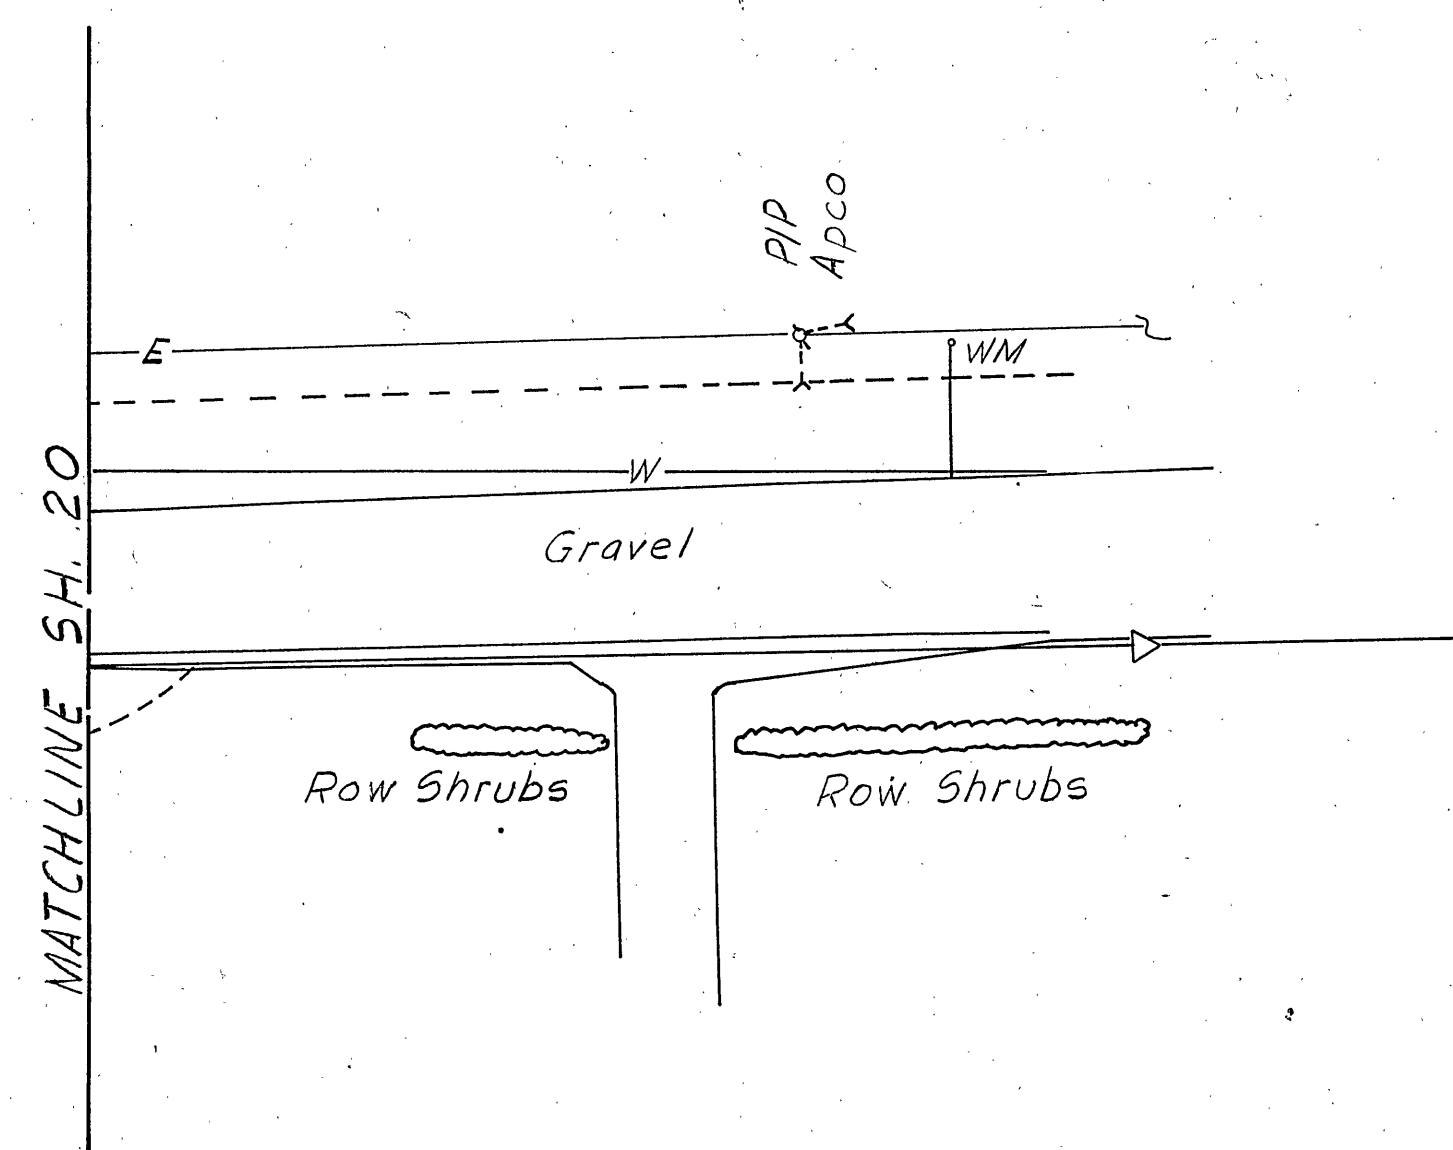


PLAN-
SCALE: 1" = 20'

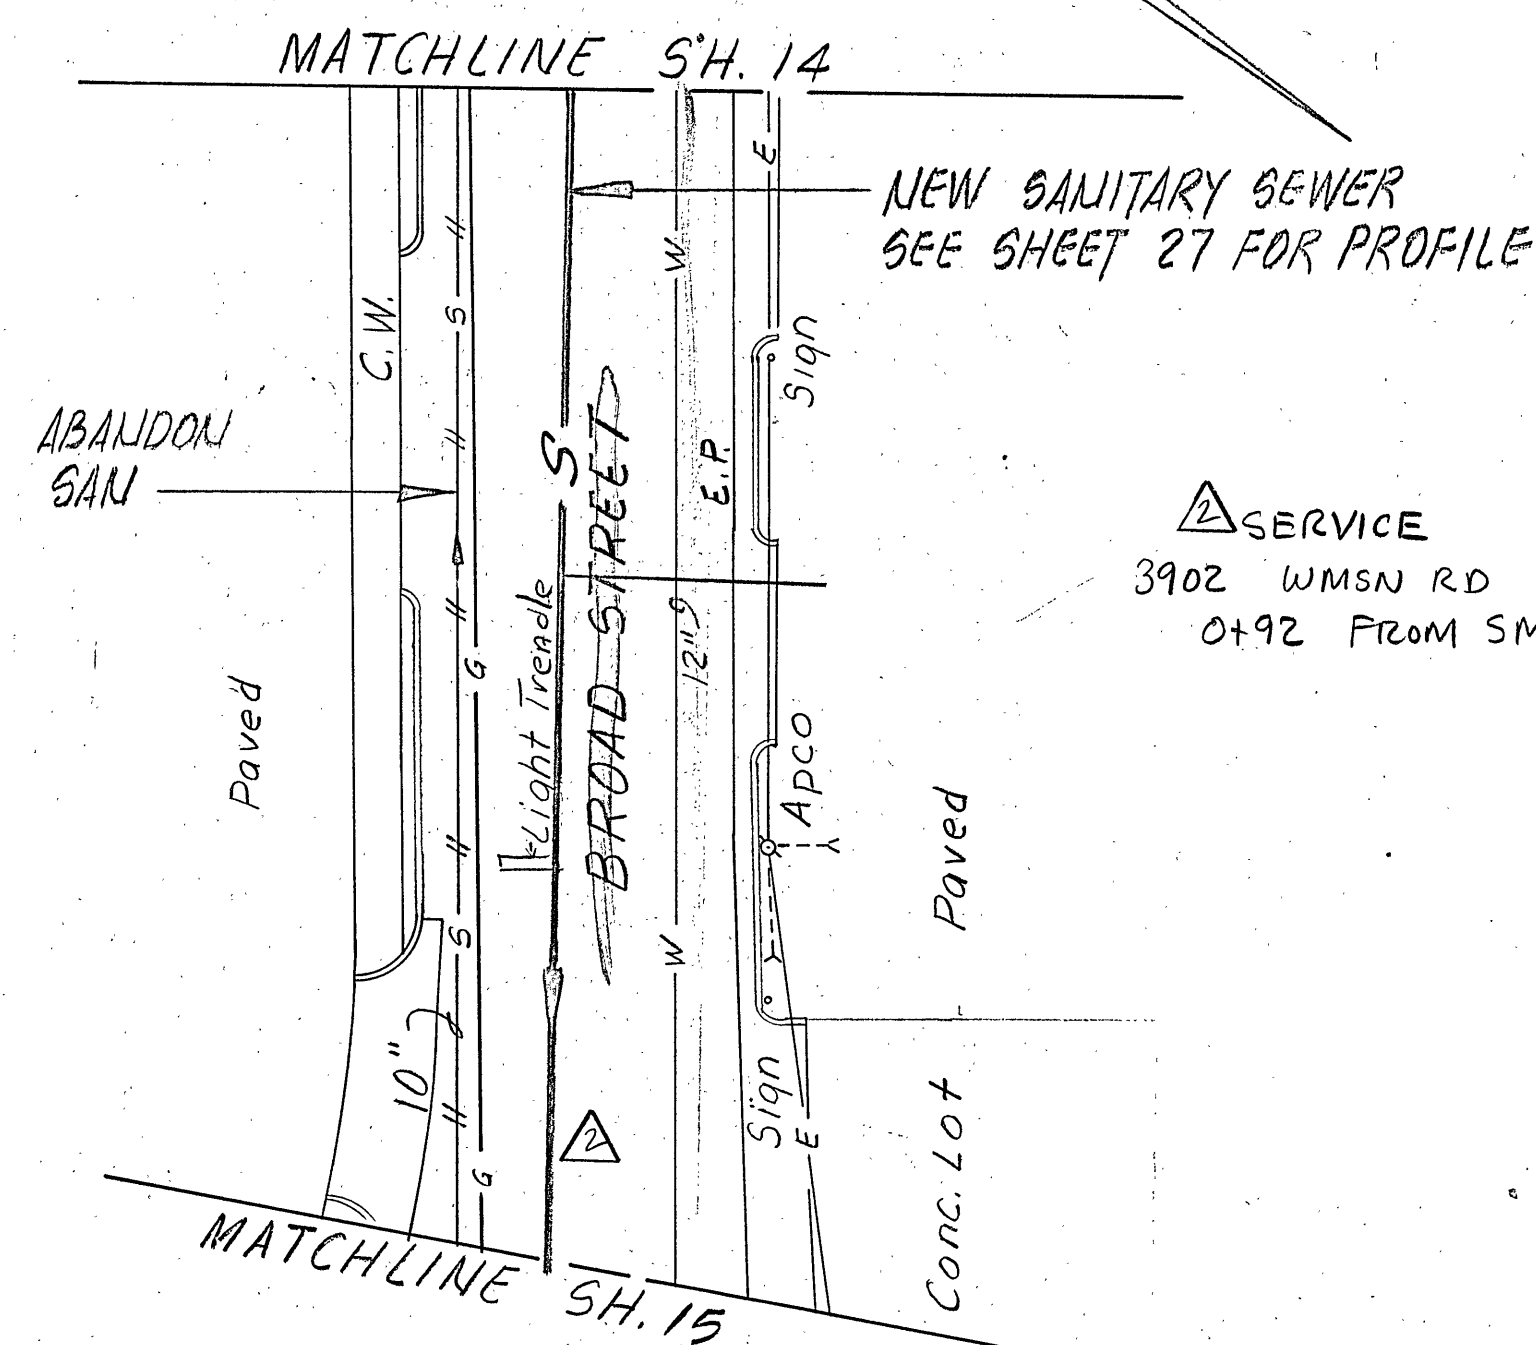


PLAN - BROAD STREET
SCALE: 1" = 20'


△ SERVICE
3902 WMSN RD
0+92 FROM SMH # 725A

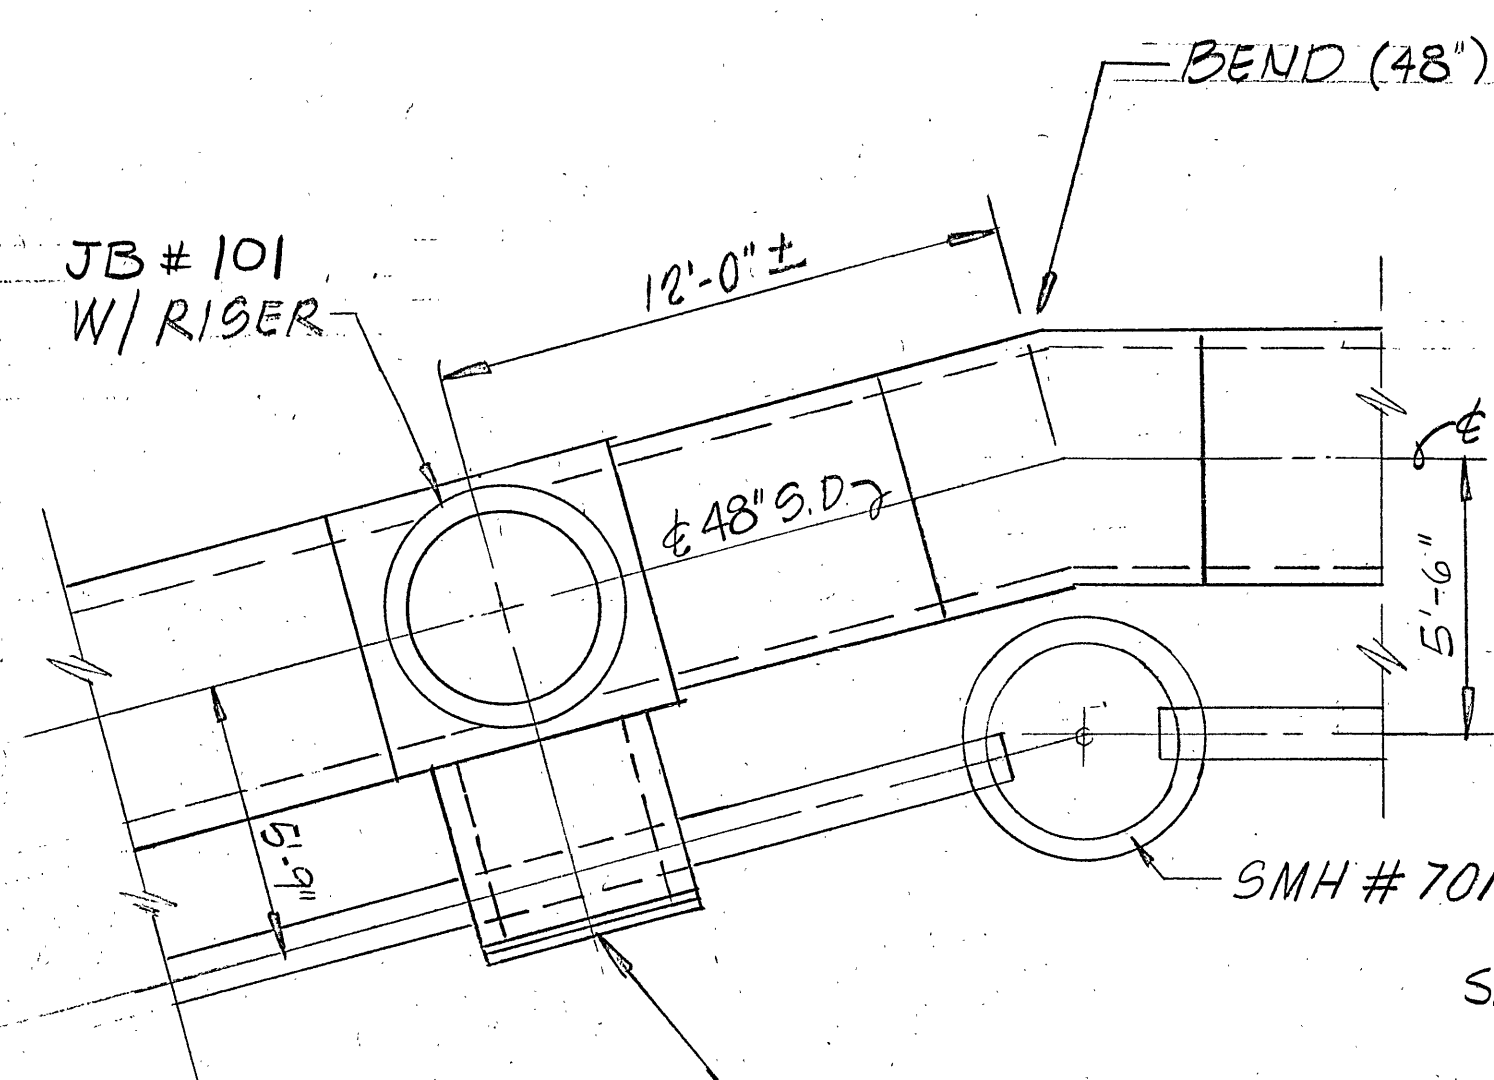


SANITARY MANHOLE # 701
SCALE: 1/4" = 1'-0"

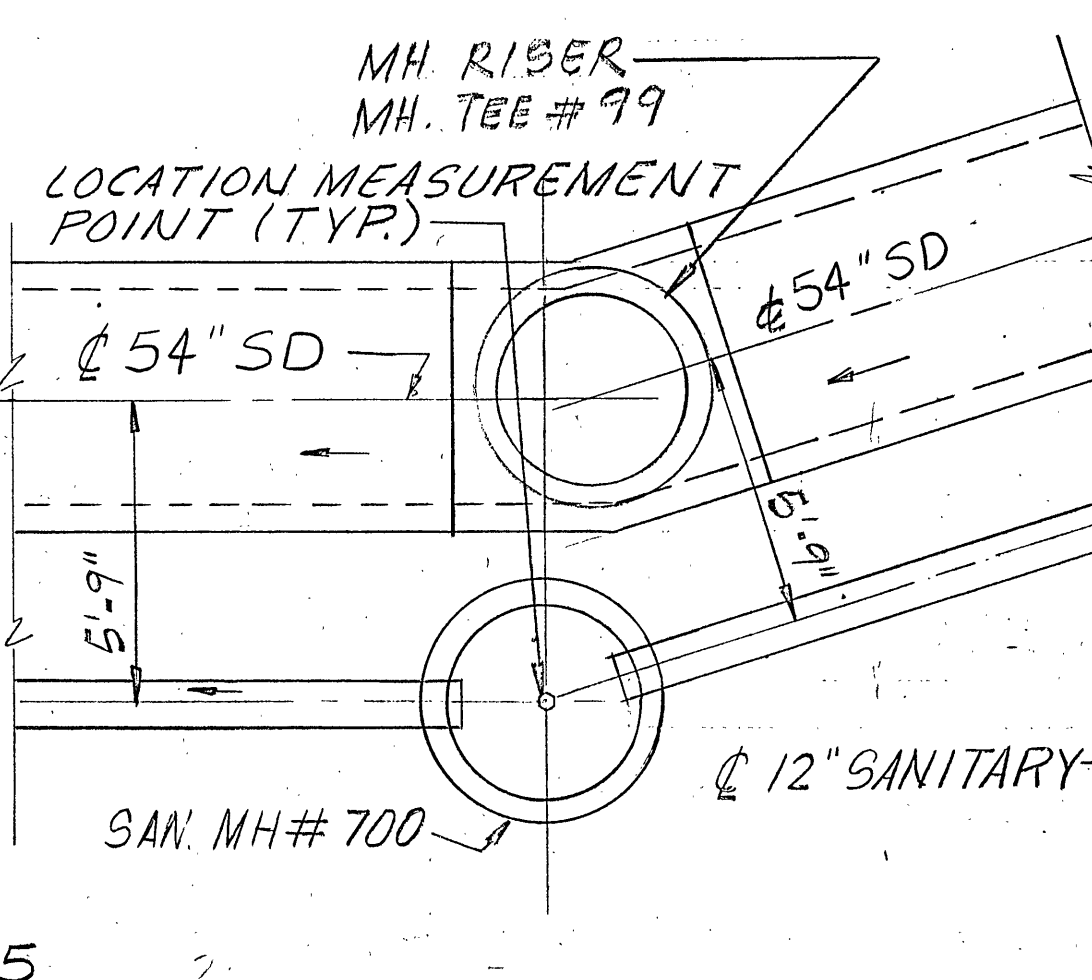

SANITARY MANHOLE # 700
SCALE: 1/4" = 1'-0"

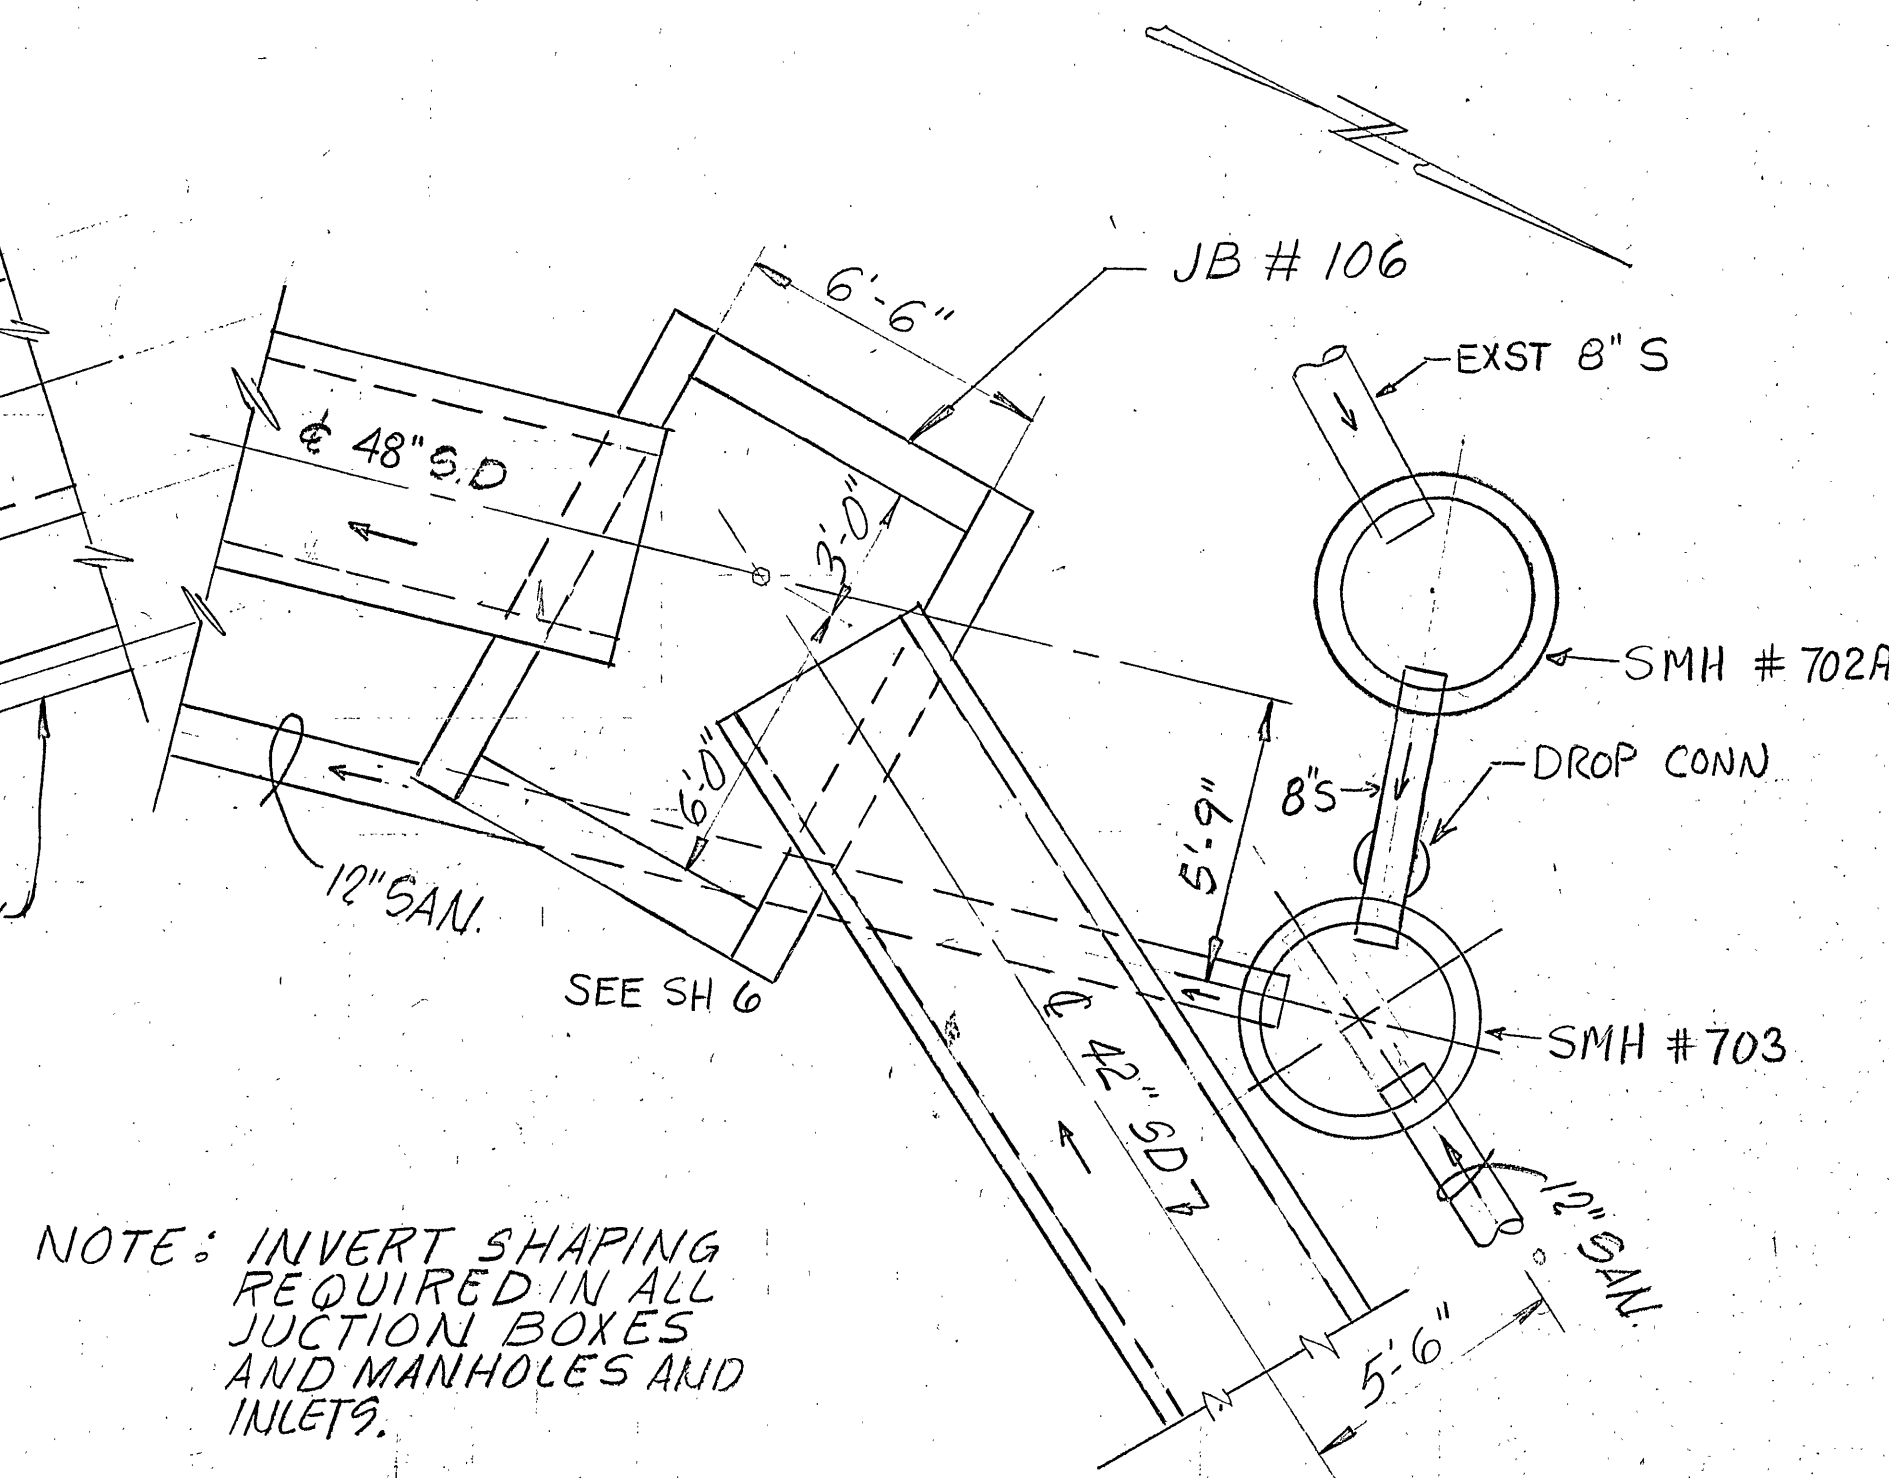

SANITARY MANHOLE # 703
SCALE: 1/4" = 1'-0"

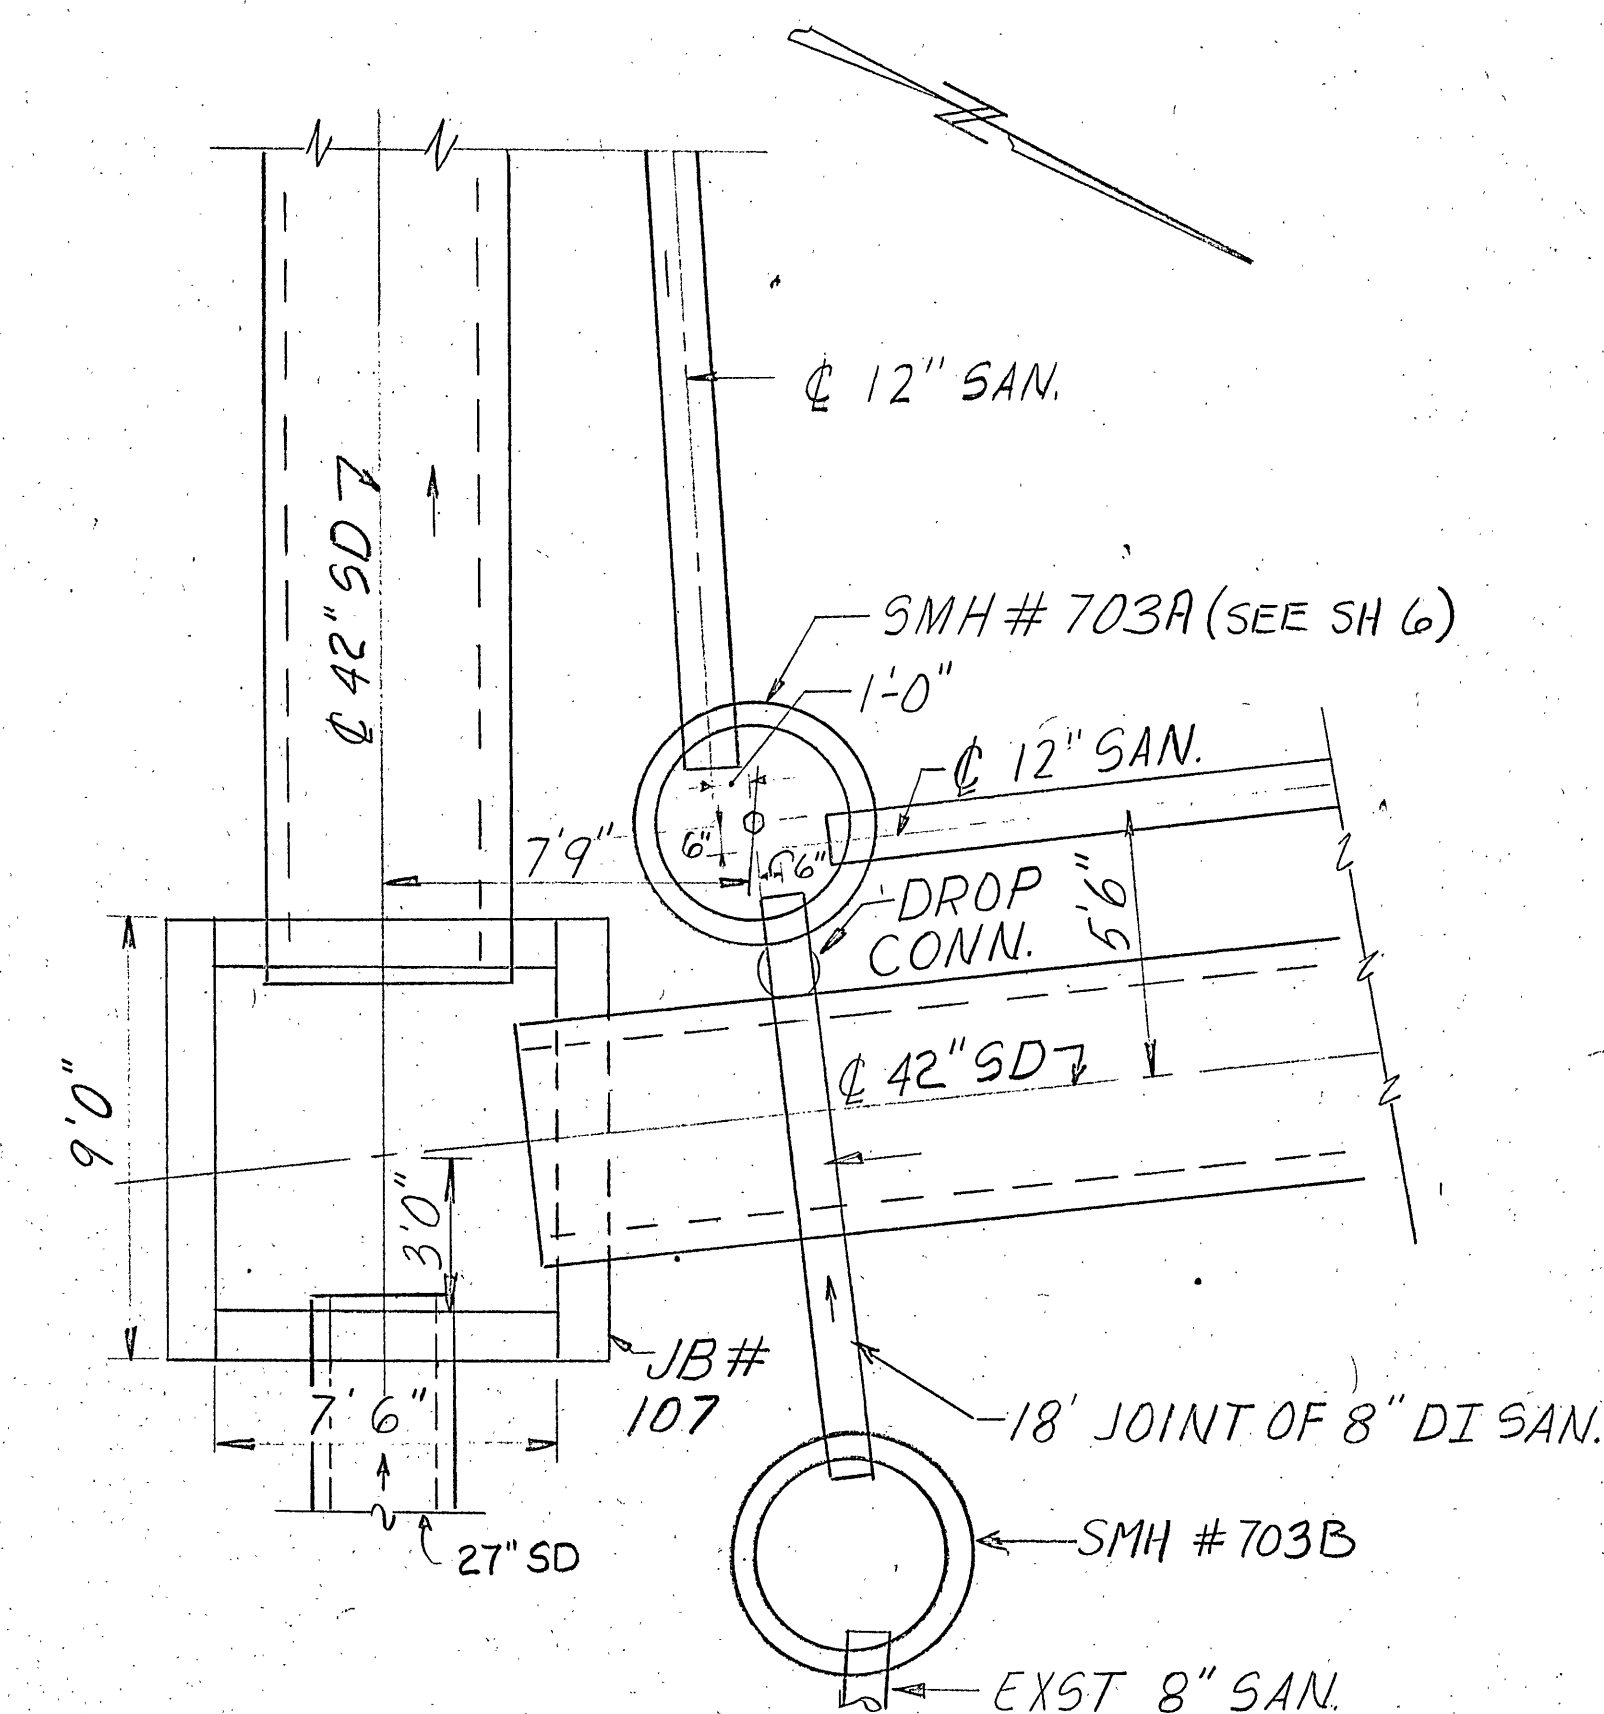


SANITARY MANHOLE # 704
SCALE: 1/4" = 1'-0"

NOTE: INVERT SHAPING
REQUIRED IN ALL
JUNCTION BOXES
AND MANHOLES AND
INLETS.



SUITE 401, 707 S. JEFFERSON STREET, ROANOKE, VIRGINIA 24011 (703) 345-0342

DESIGNED:
JWC
CHECKED:
SWH
APPROVED:

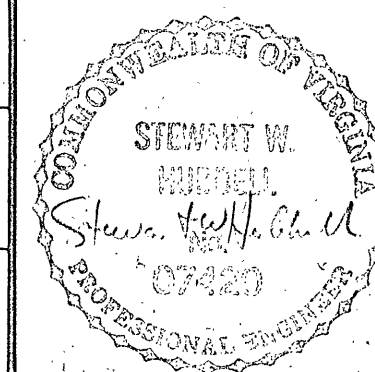

REVISION	DATE	DESCRIPTION	BY	APP
△	1-11-86	REV SIZES		SWH
△	9/16/88	RECORD DWG		SWH

DATE
JULY
1983
COMM.
428

WILLIAMSON ROAD STORM DRAIN - PHASE 1
CONTRACT II

DETAILS

SHEET
28