




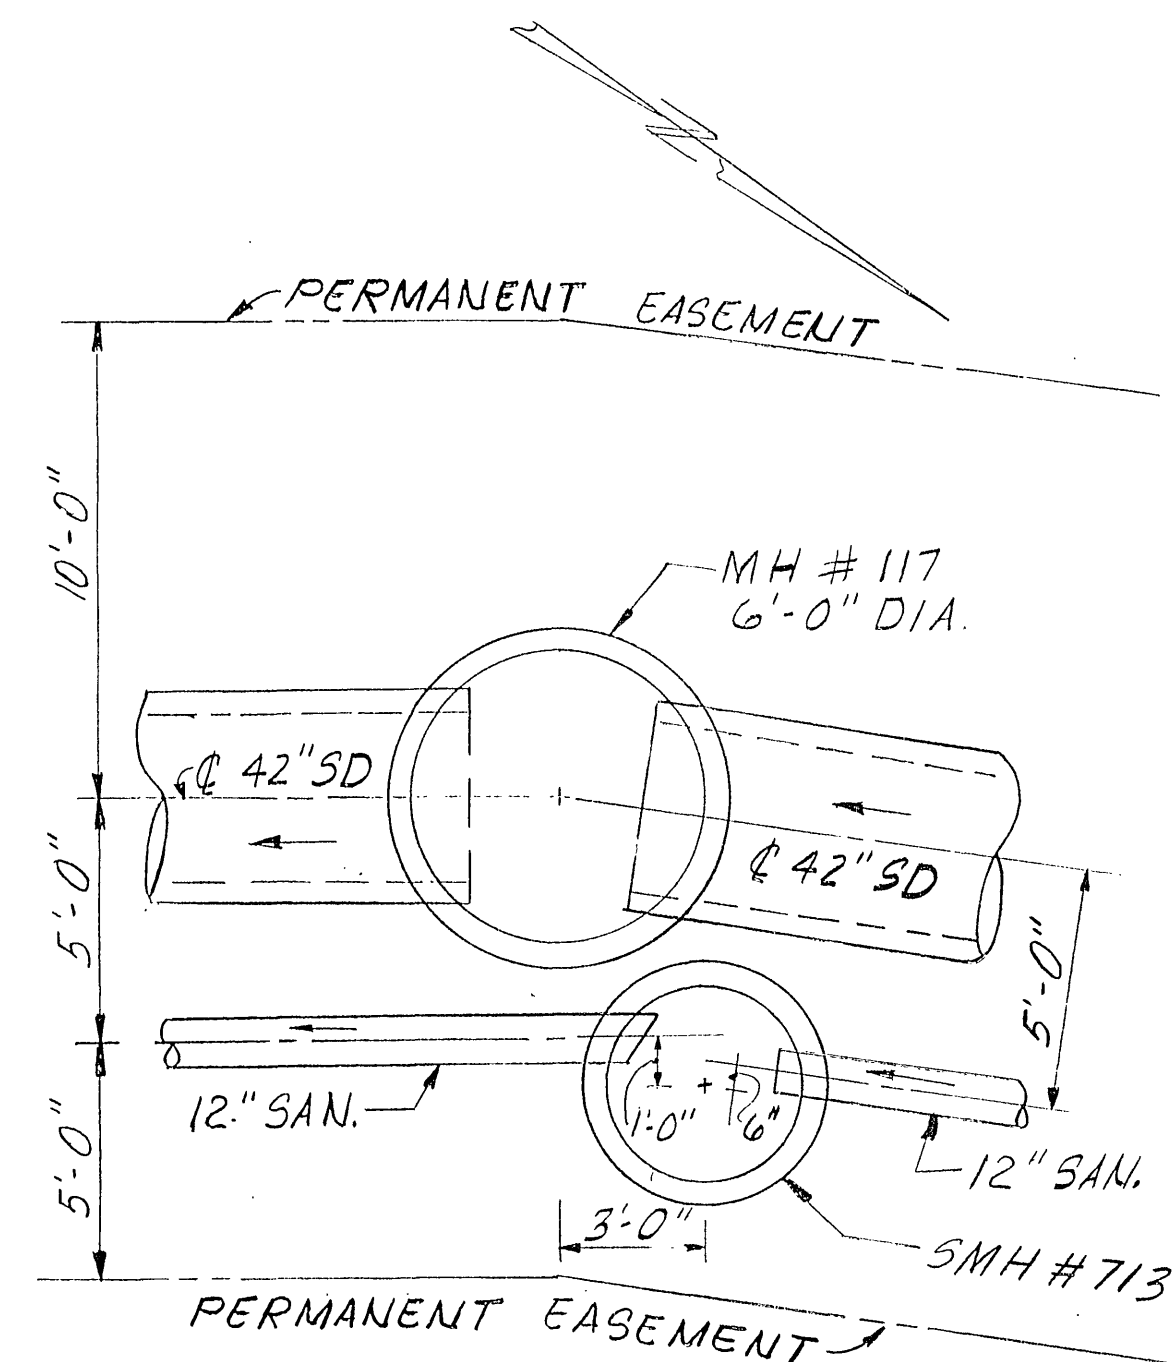


SANITARY MANHOLE # 713

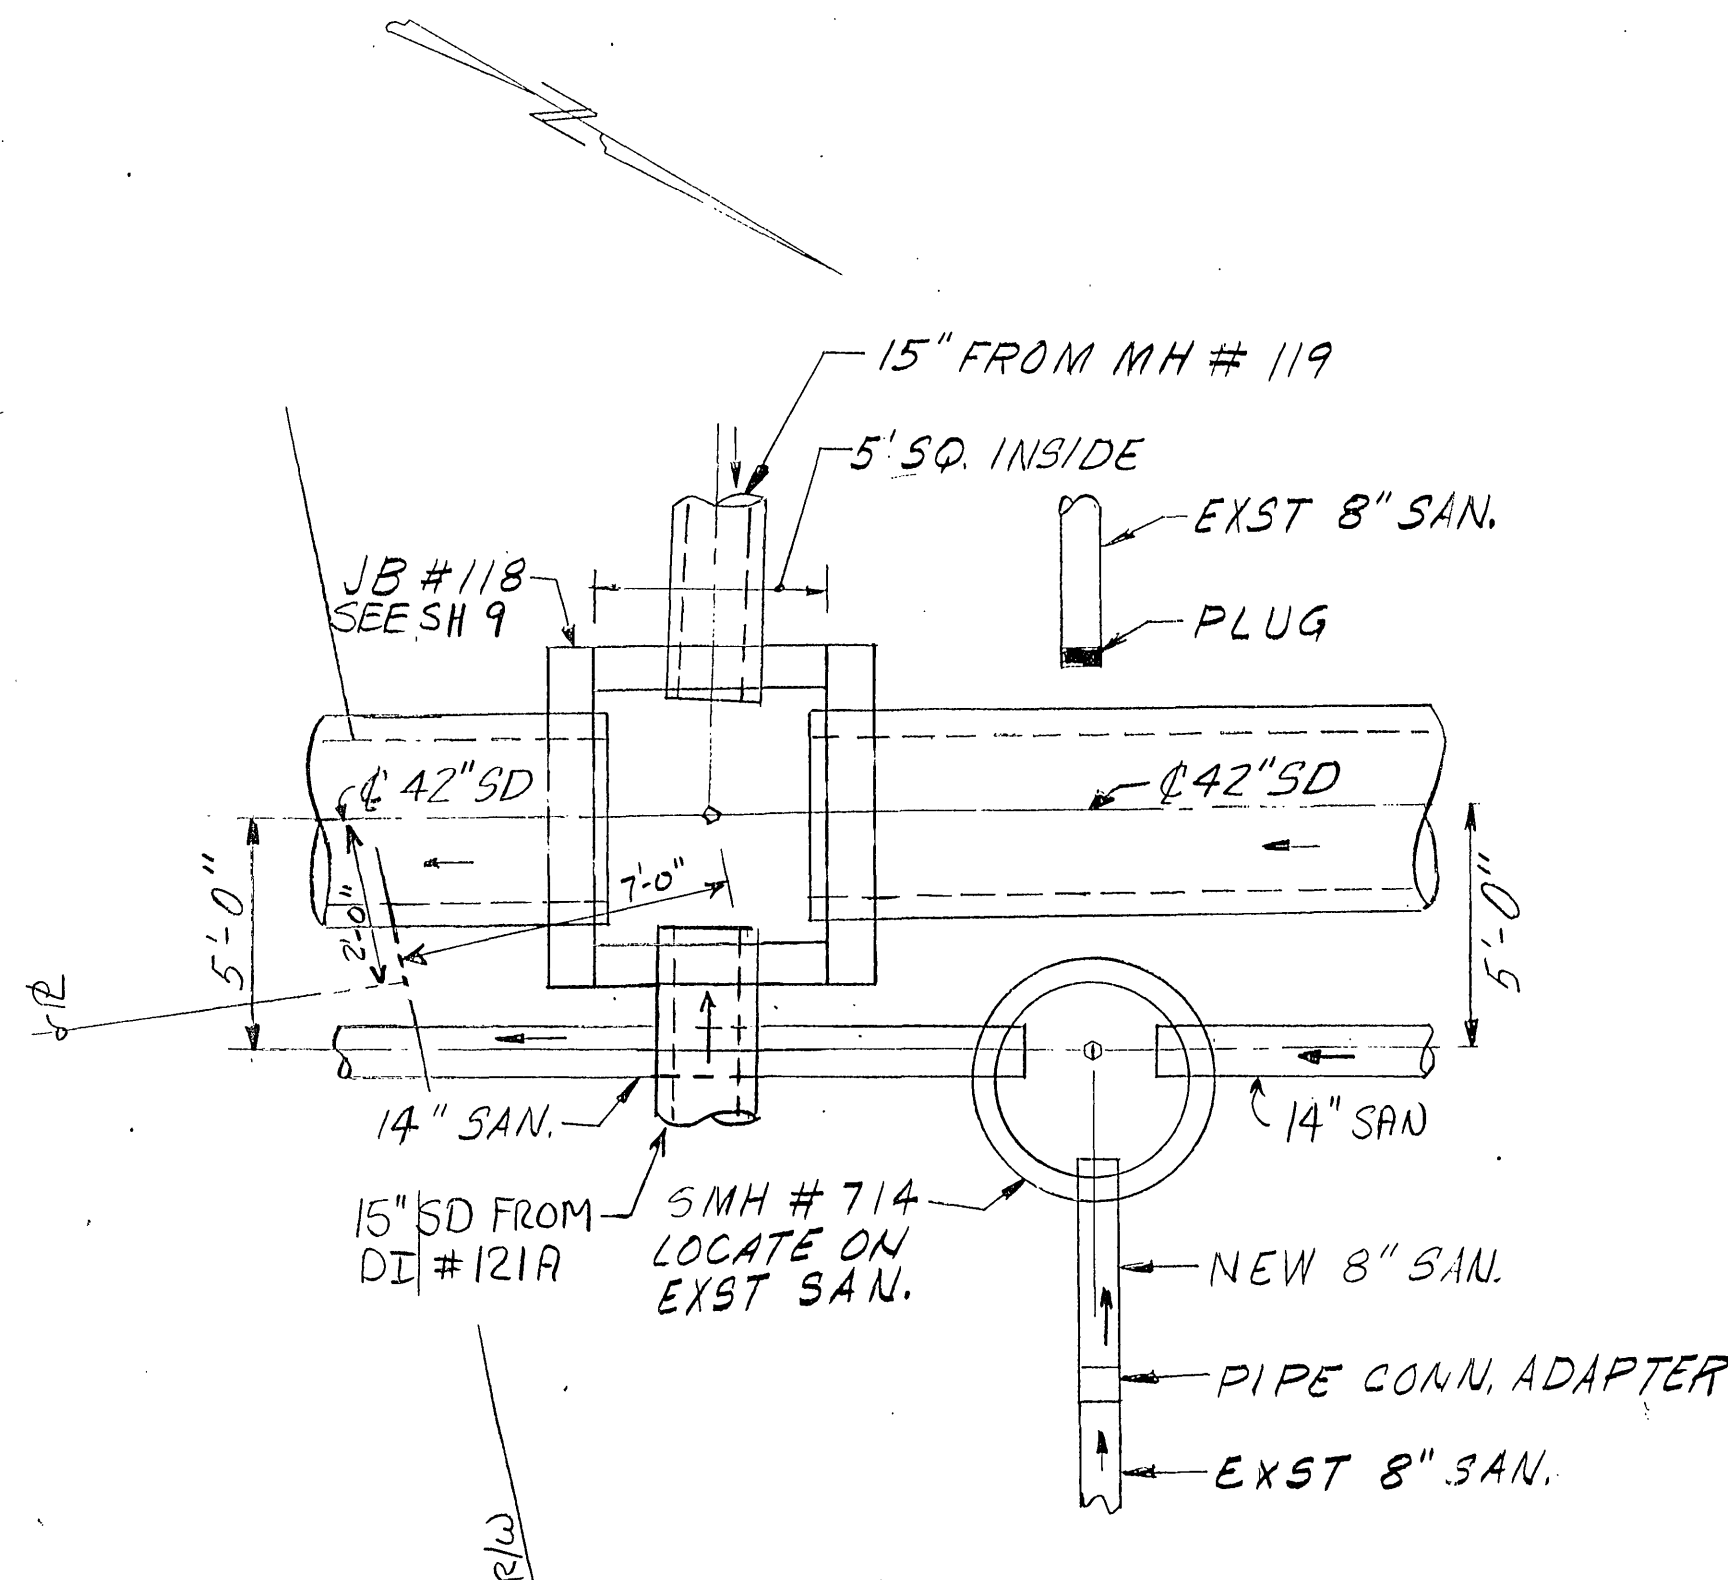

SANITARY MANHOLE # 714

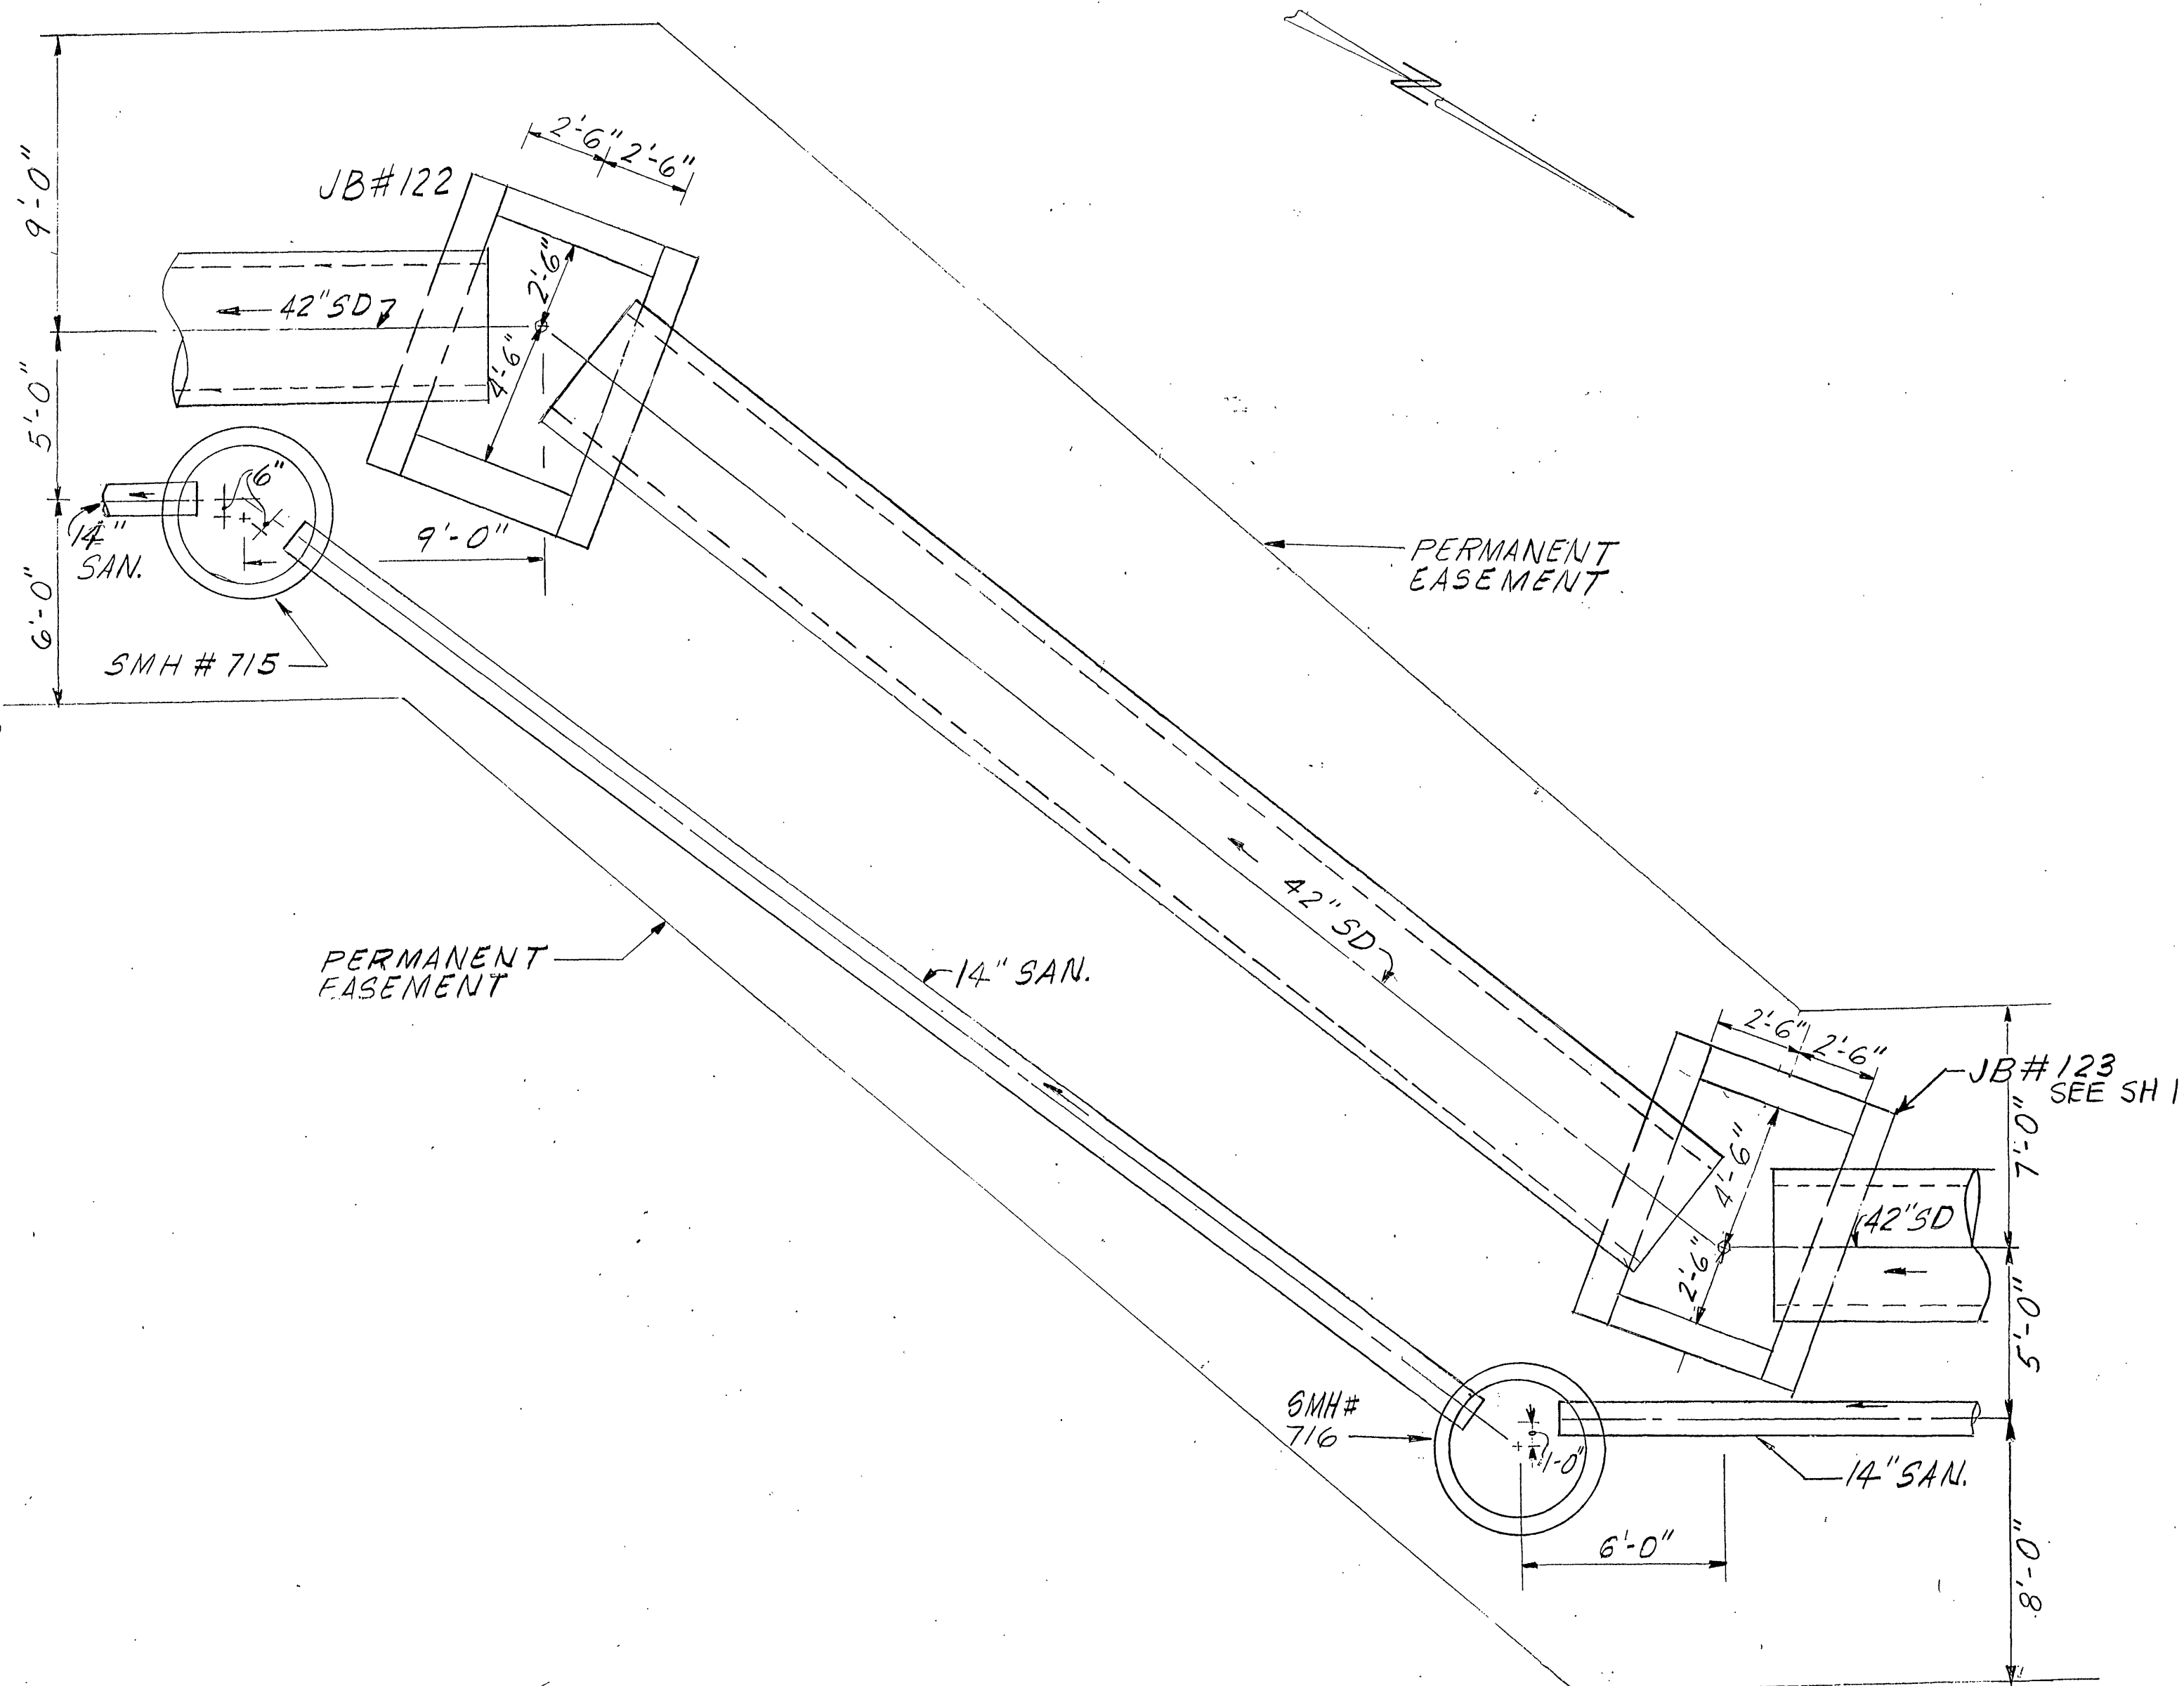

SANITARY MANHOLE # 715 & 716

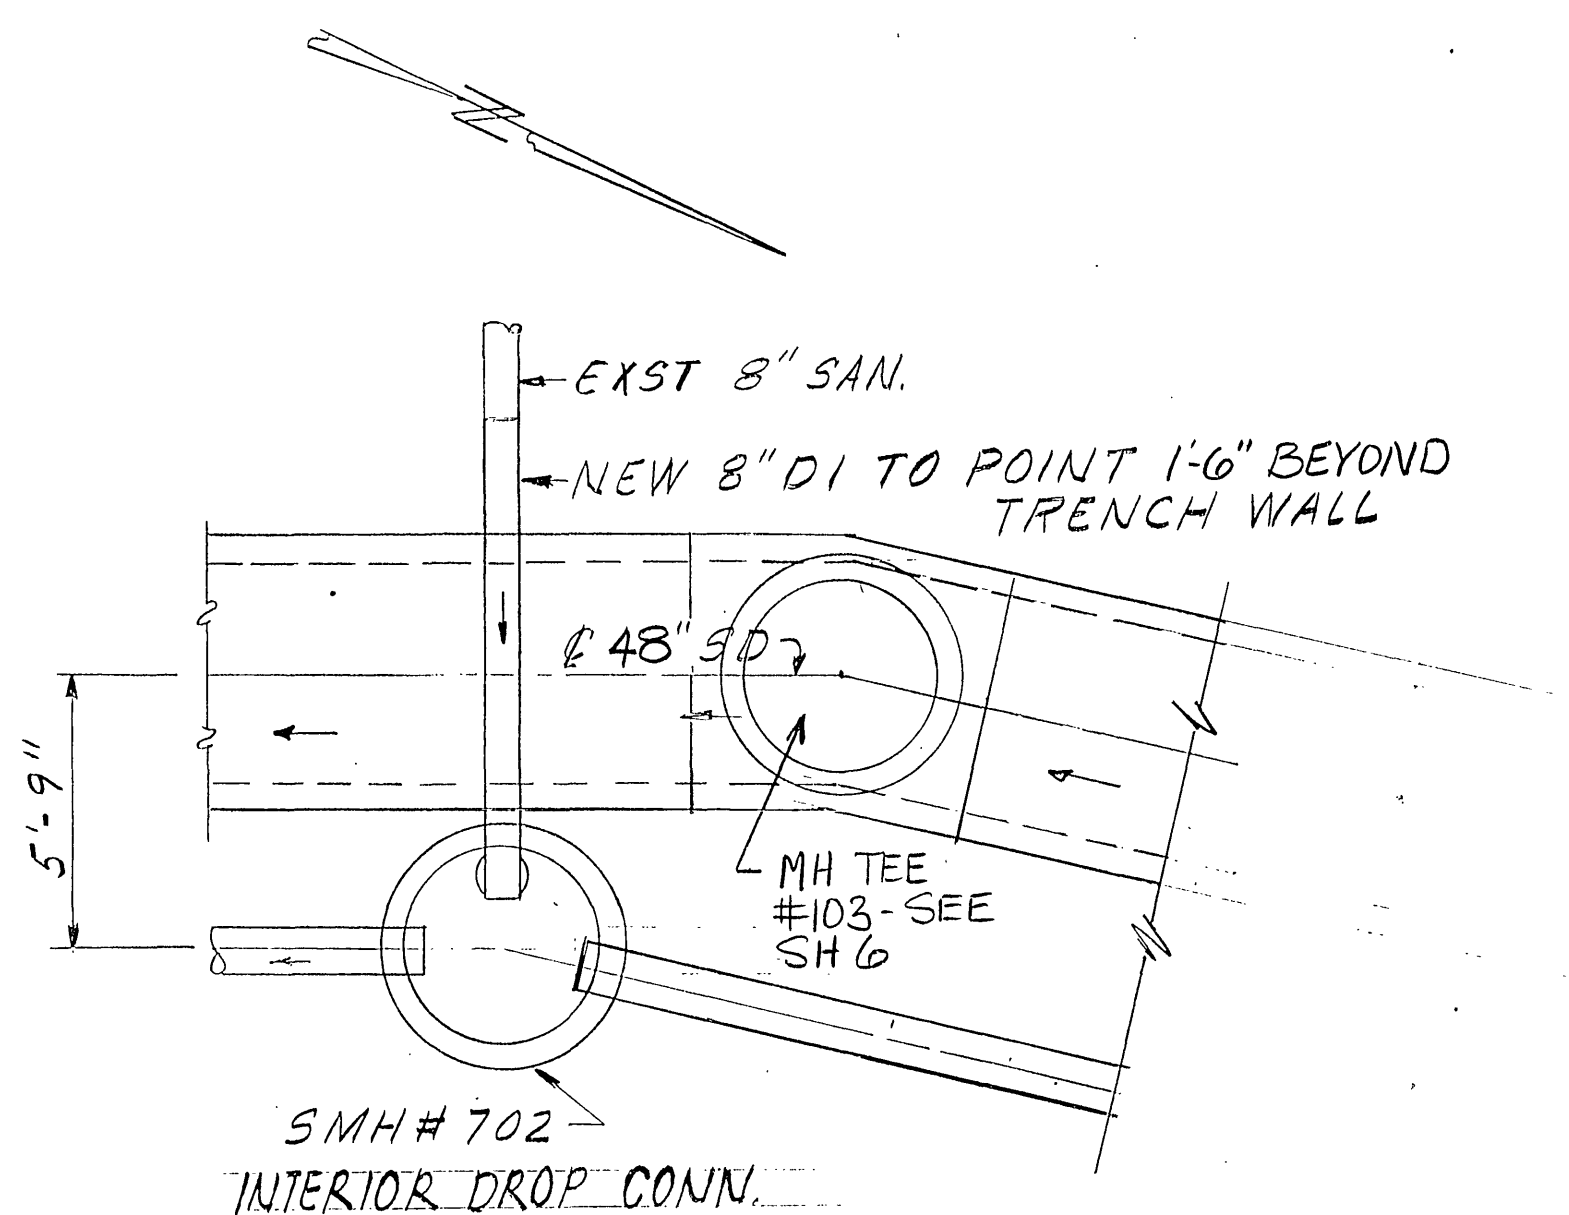

SANITARY MANHOLE # 702

RECORD DRAWING