
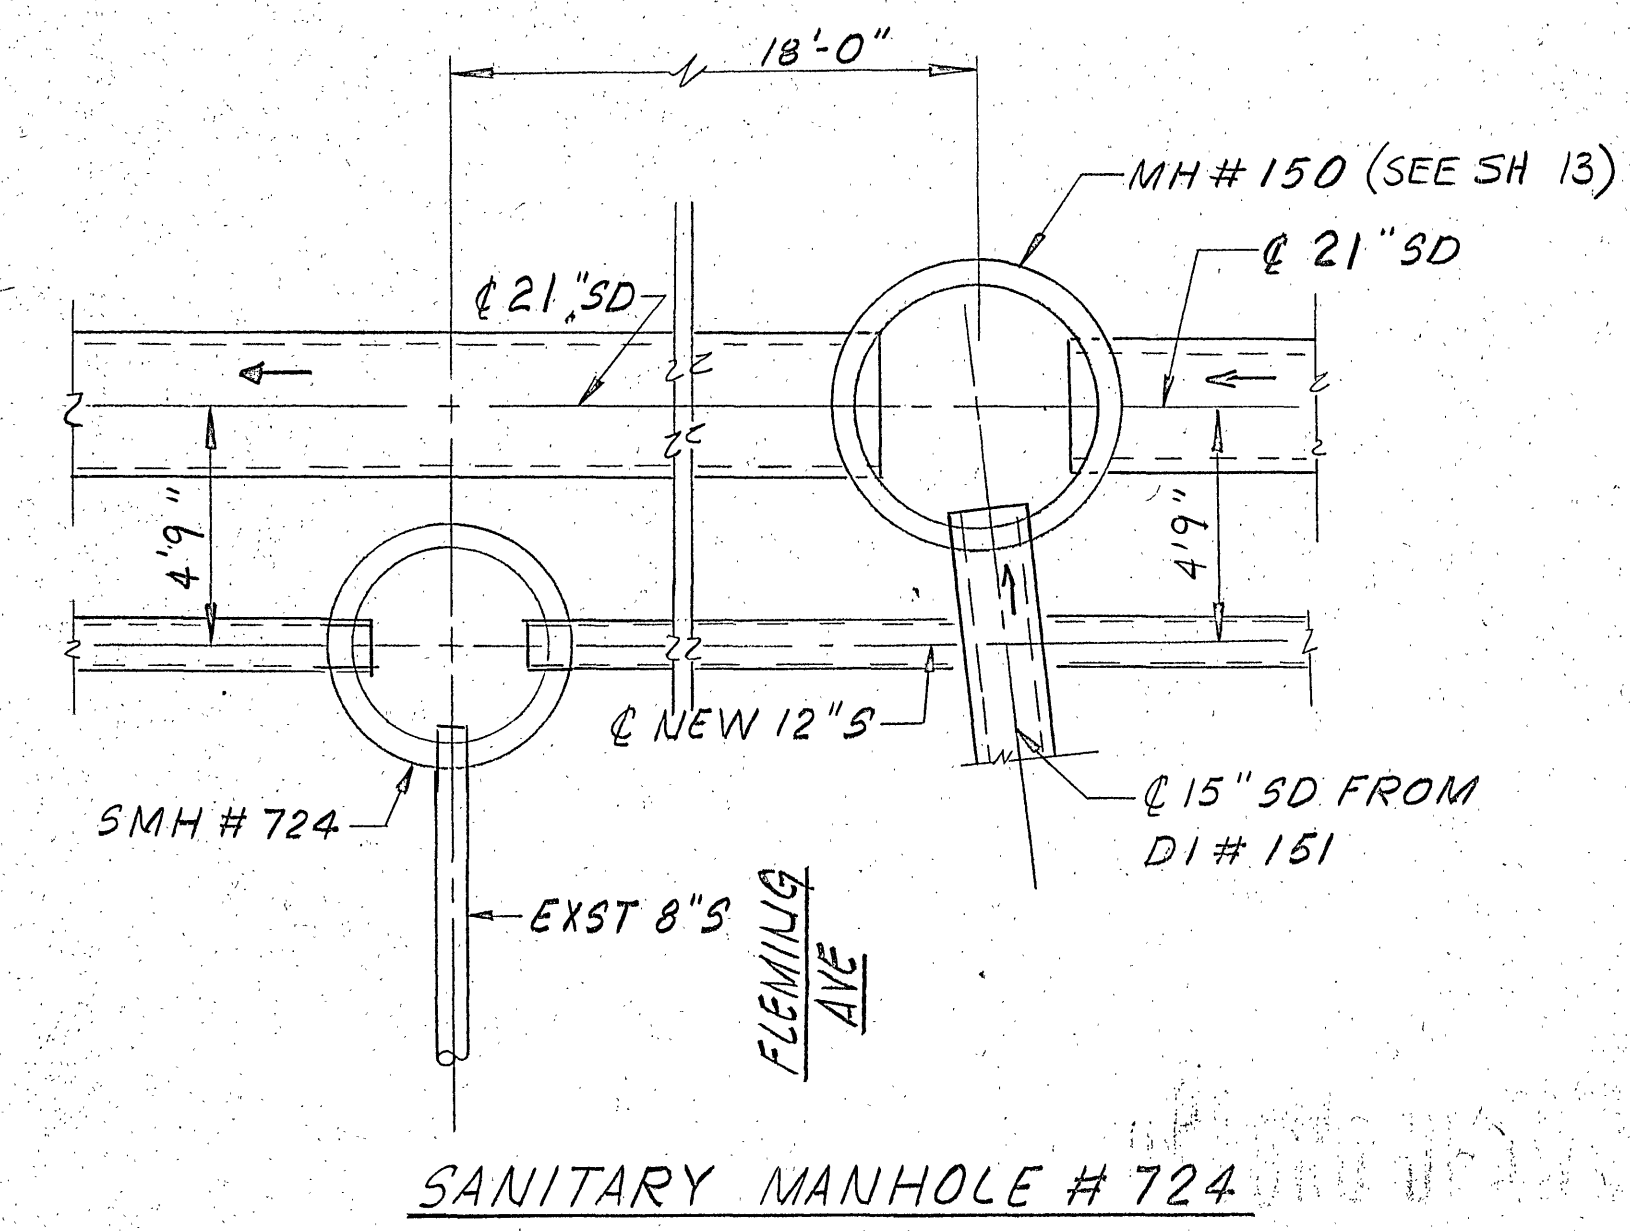
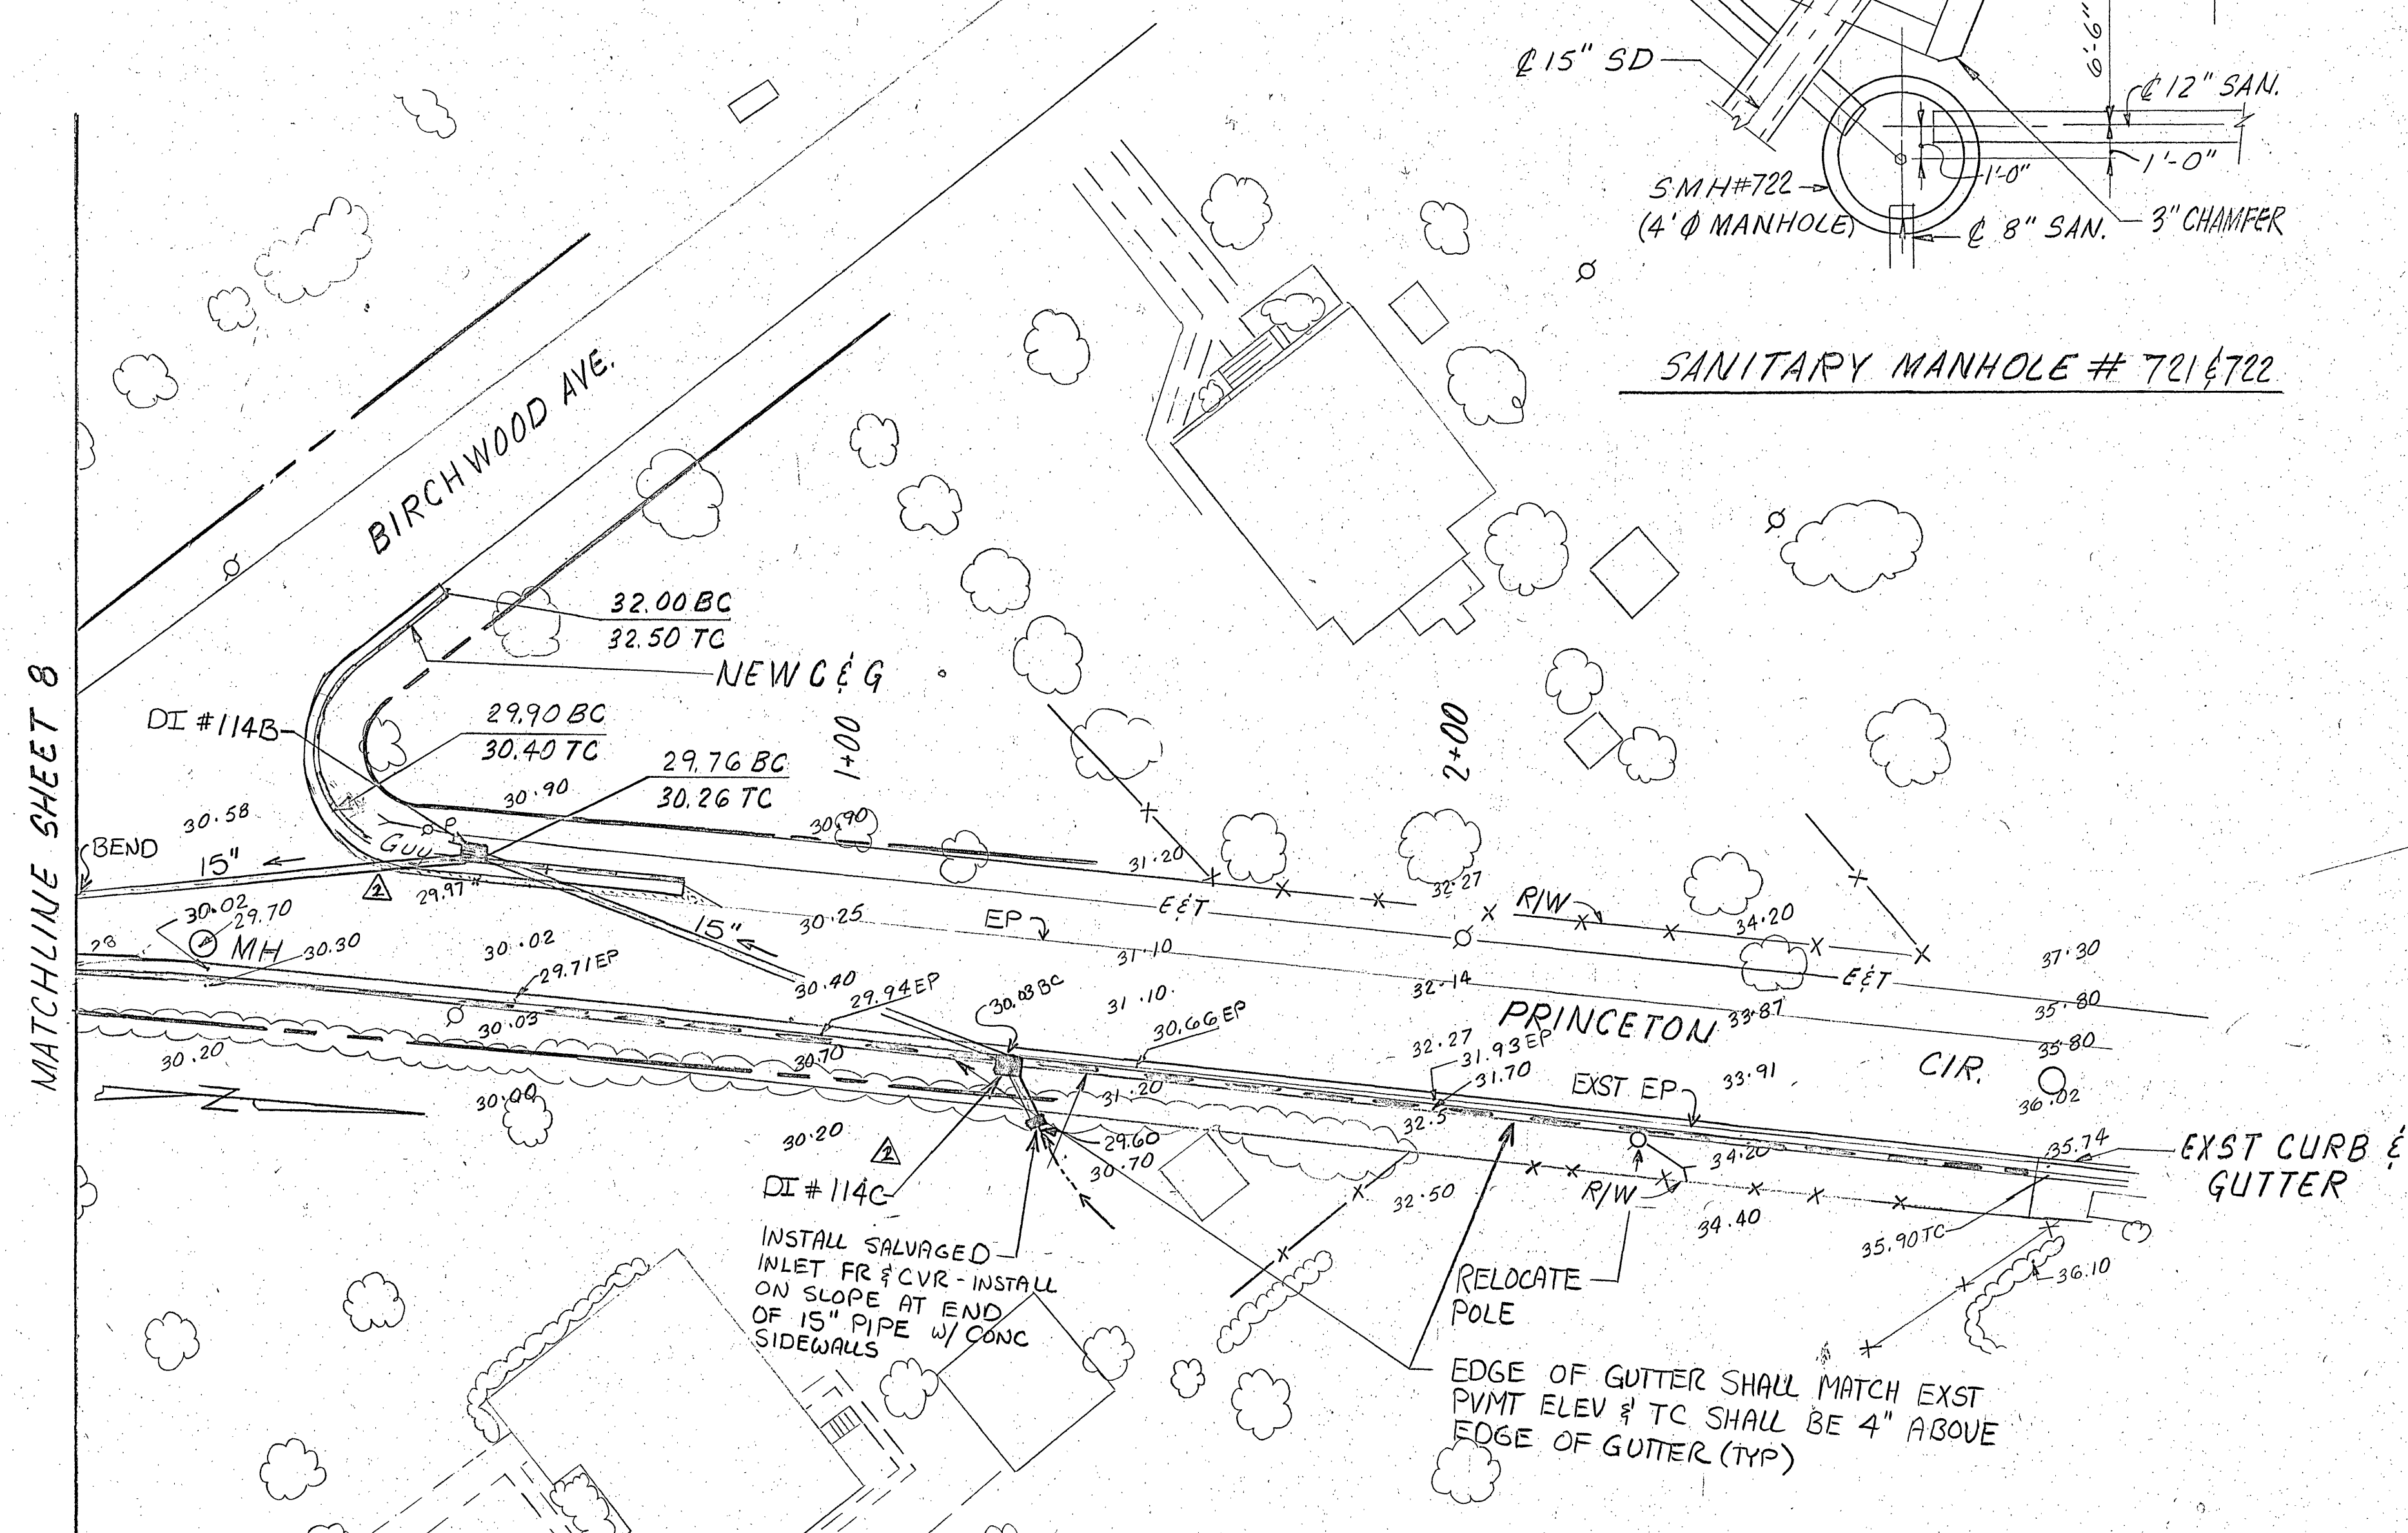
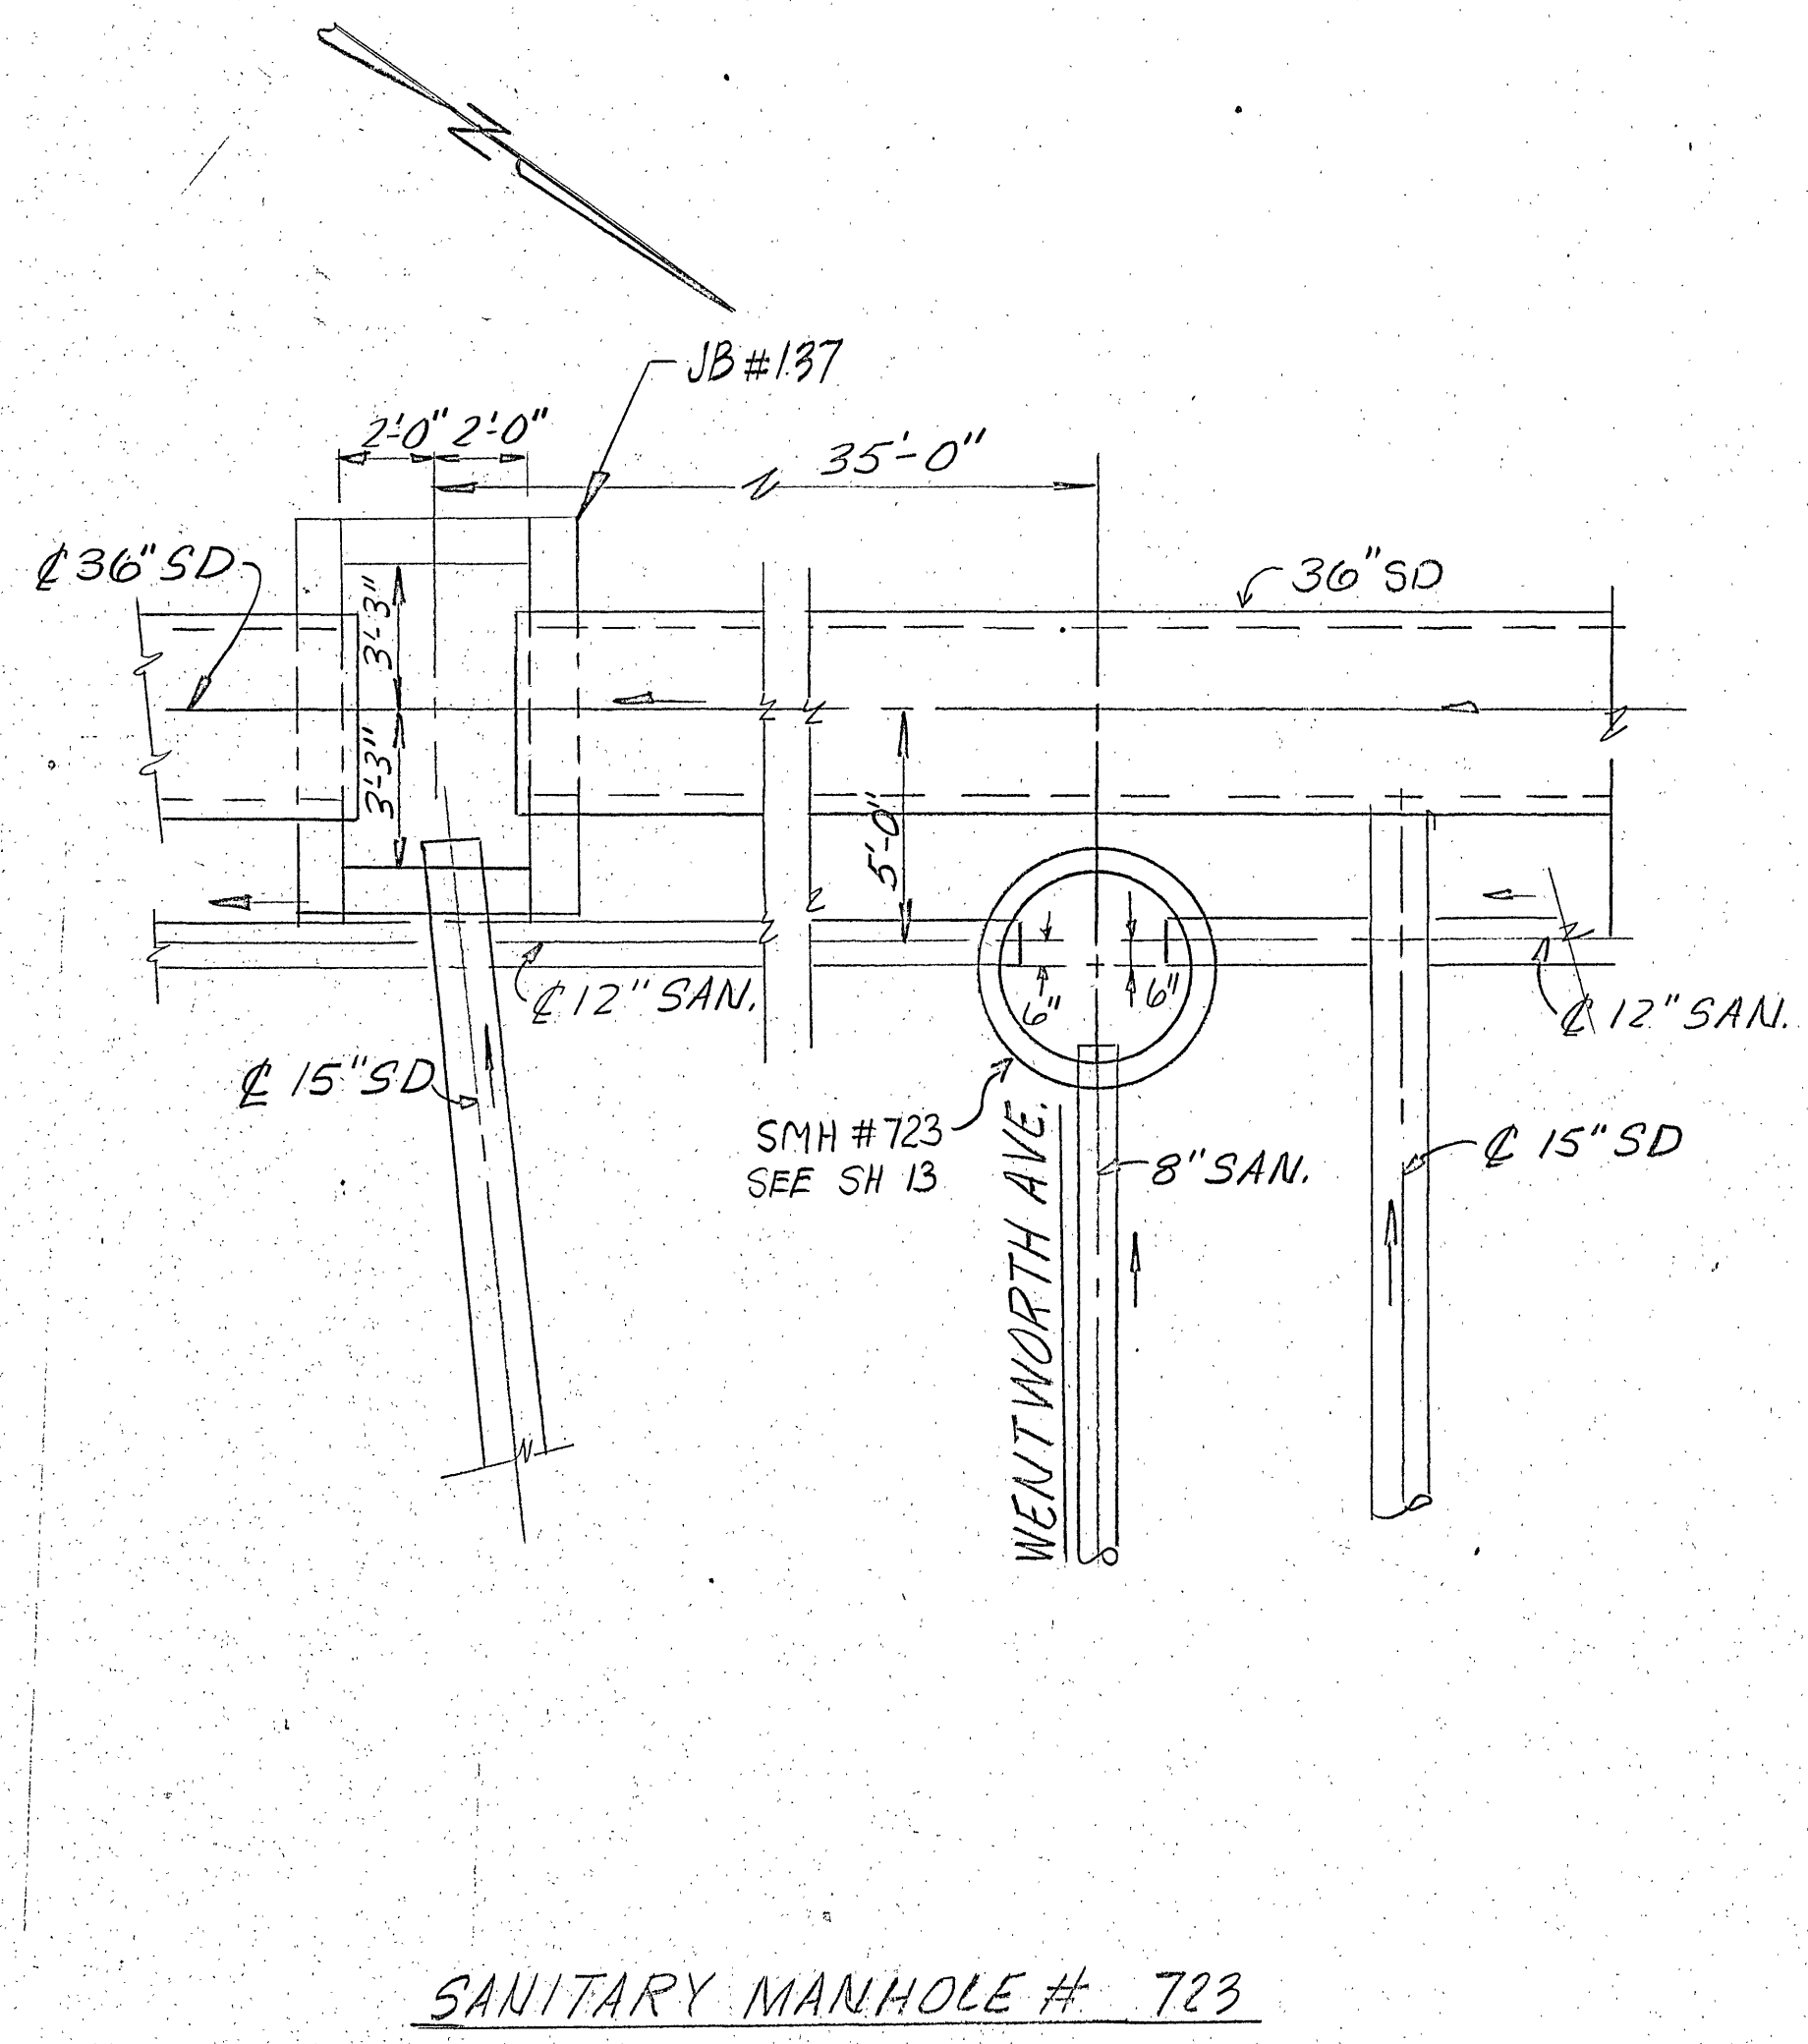
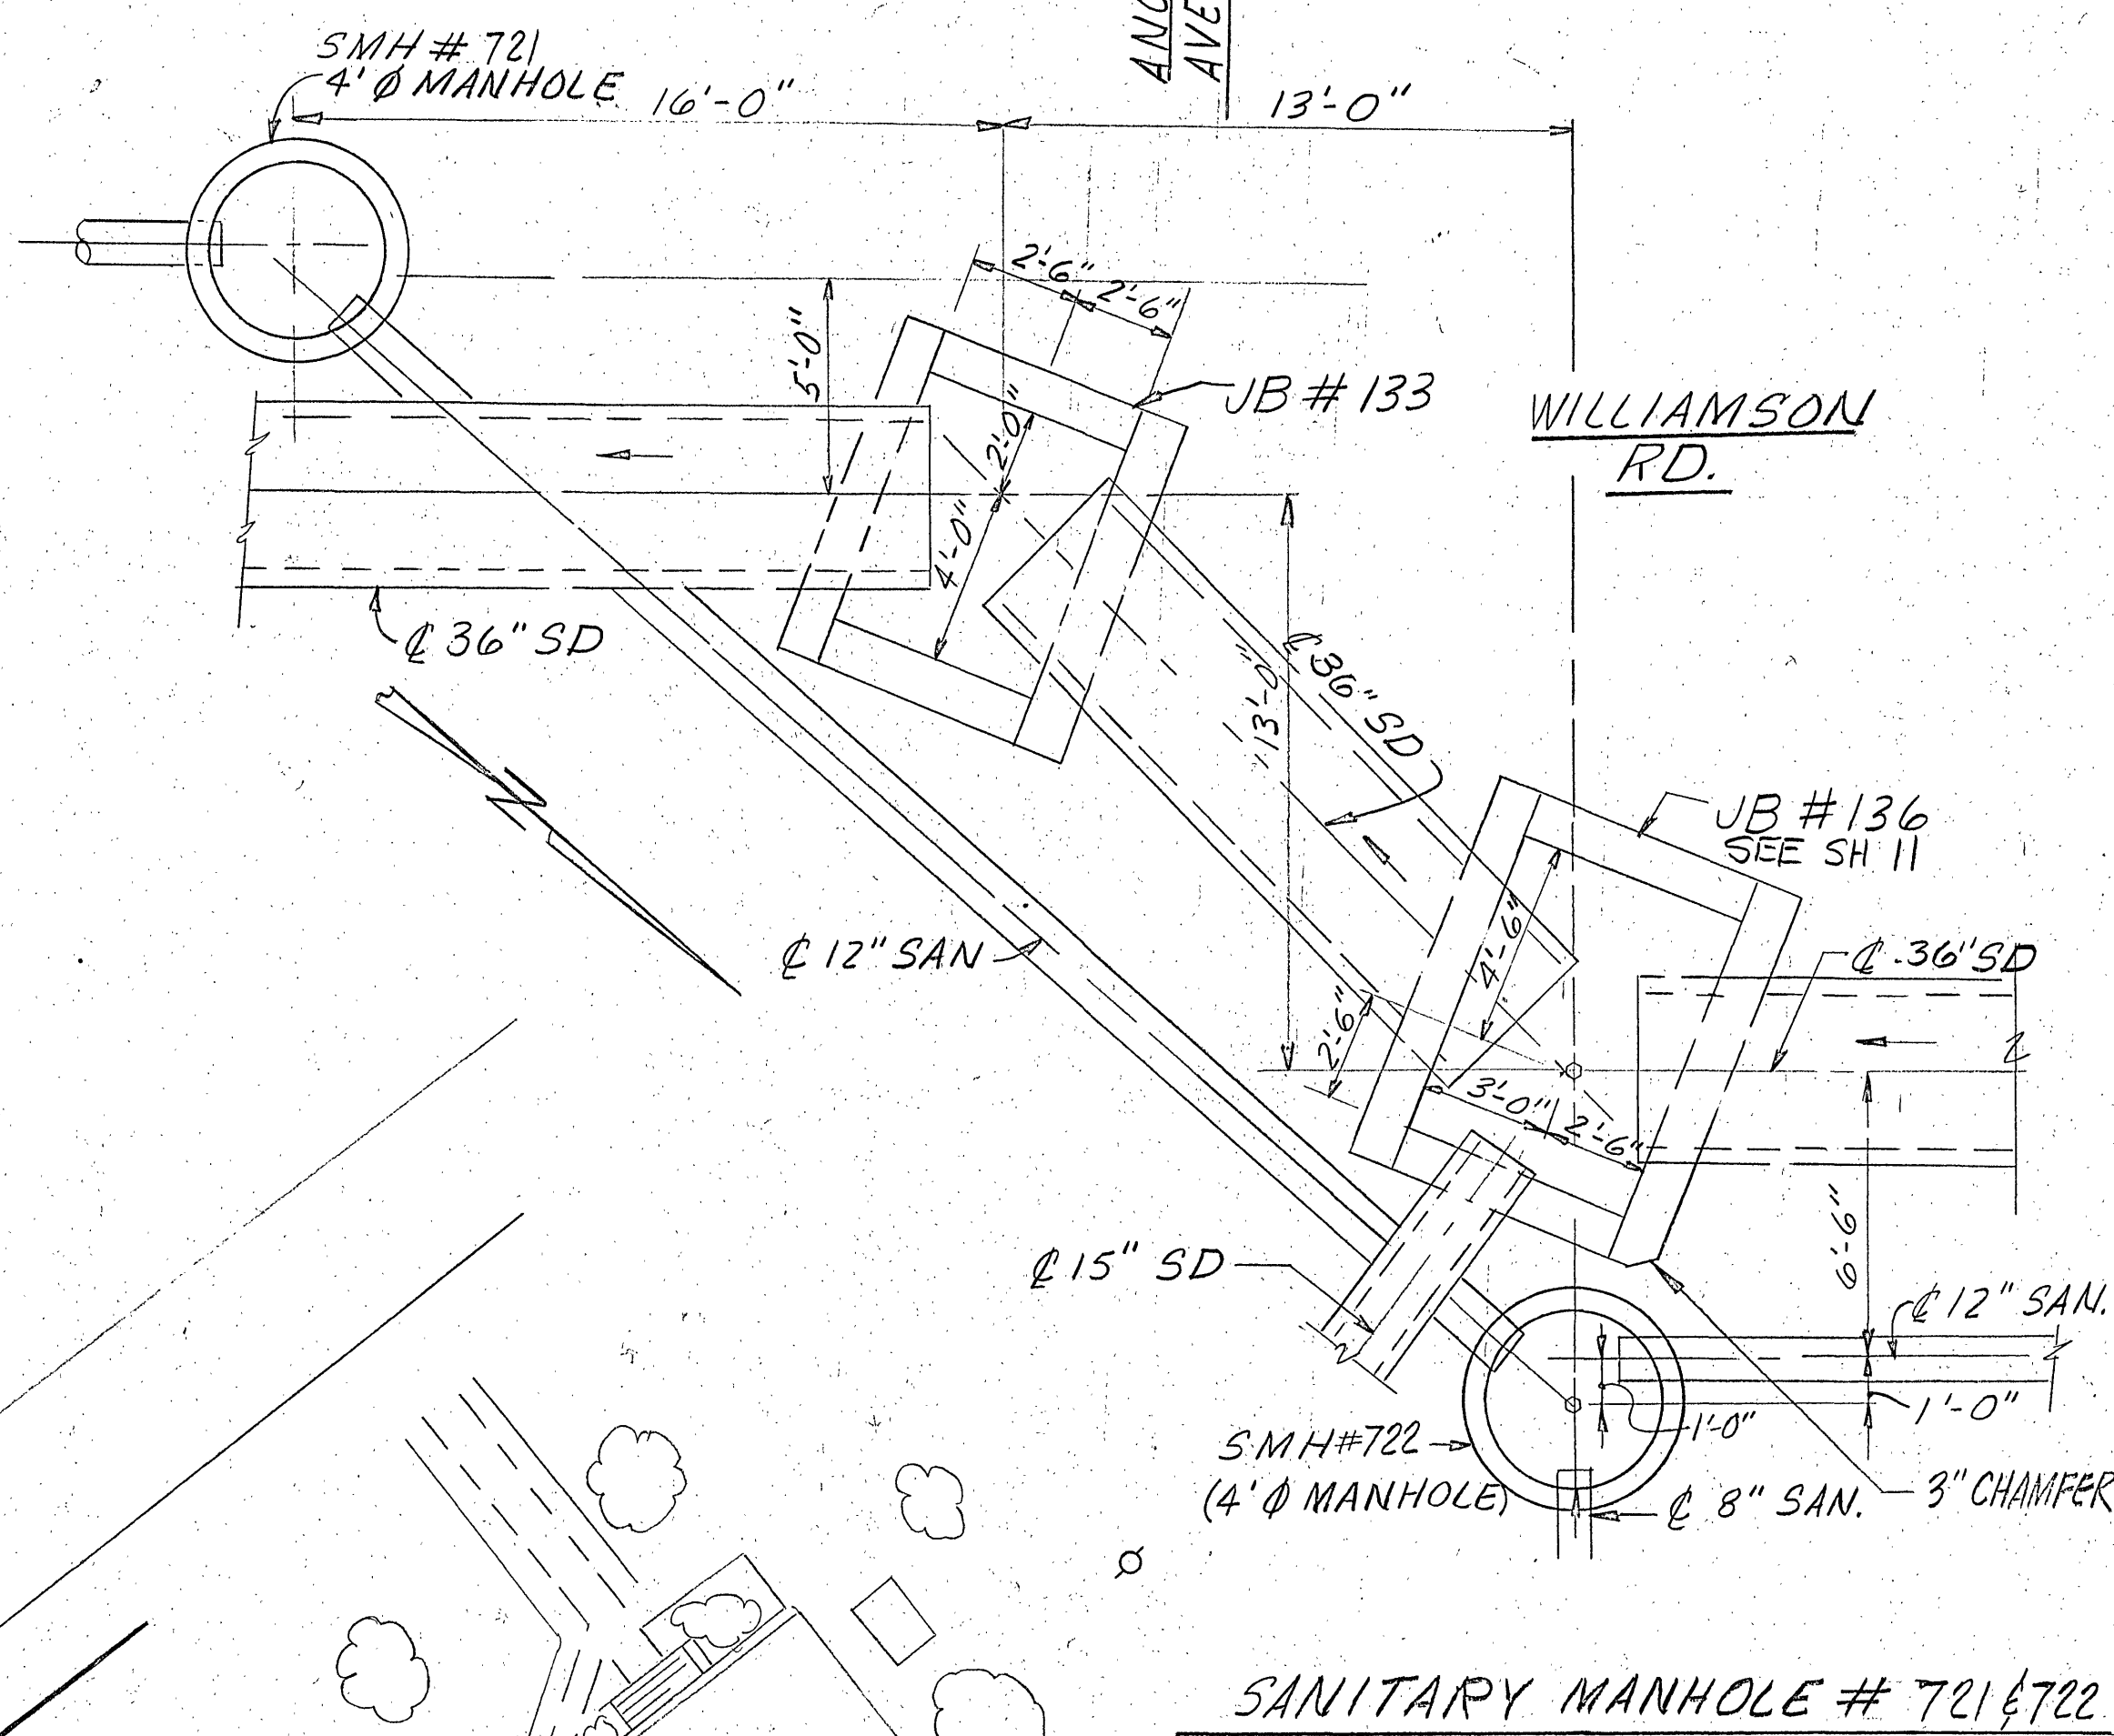


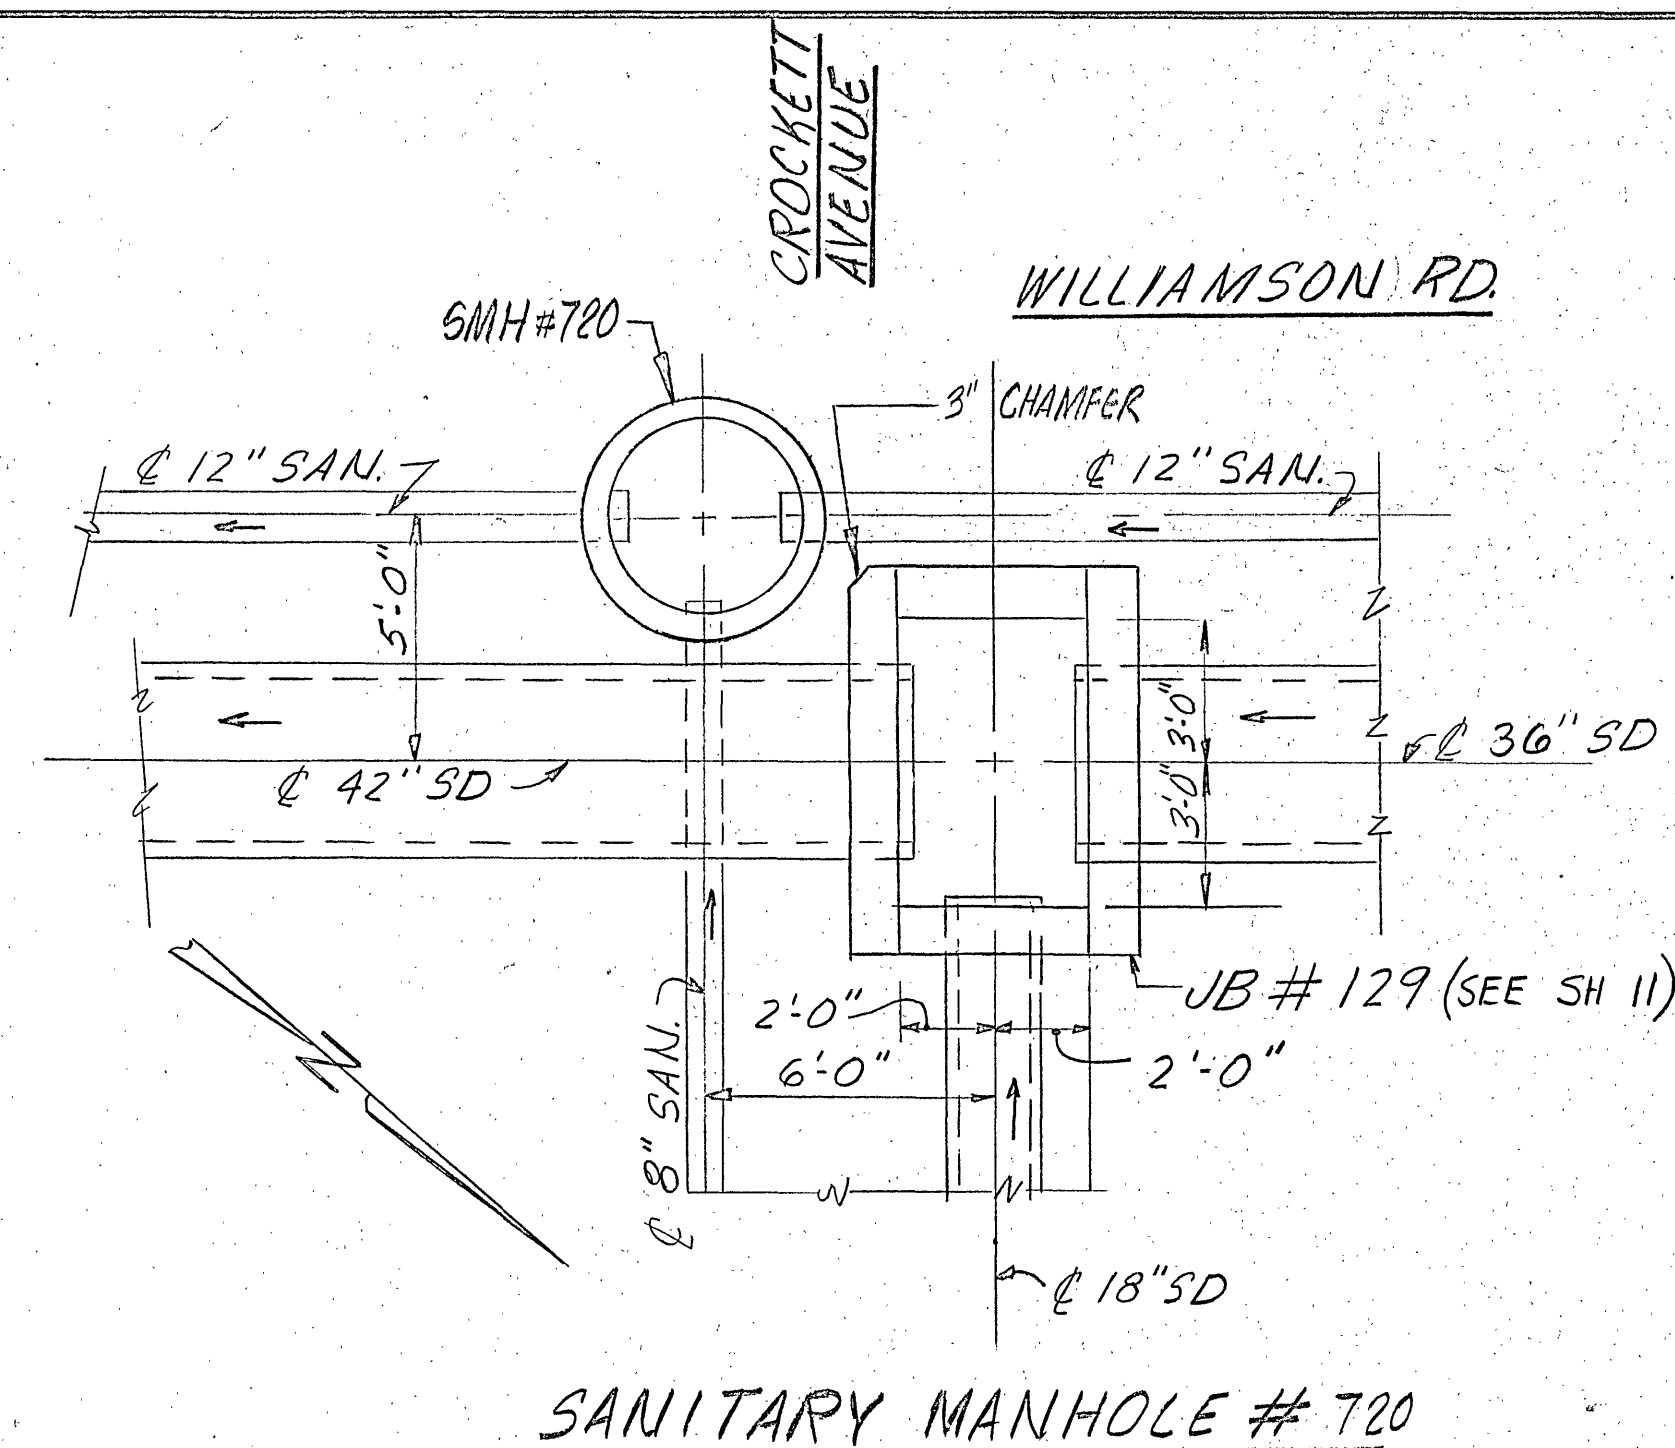

Mattern & Craig
CONSULTING ENGINEERS
SUITE 401, 707 S. JEFFERSON STREET, ROANOKE, VIRGINIA 24011, (703) 345-9342

DESIGNED: JWC
CHECKED: SWH
APPROVED:

STEWART W. HUBBELL
PROFESSIONAL ENGINEER
07420

REVISION	DATE	DESCRIPTION	BY	APP.
1	1-11-86	REV SIZES		SWH
2	5-21-87	REV DI #114B & ADD #114C		SWH
3	9/16/88	RECORD DWG		SWH

DATE
JULY 1983
COMM.
428

WILLIAMSON ROAD STORM DRAIN - PHASE 1
CONTRACT II

DETAILS

SHEET
31