
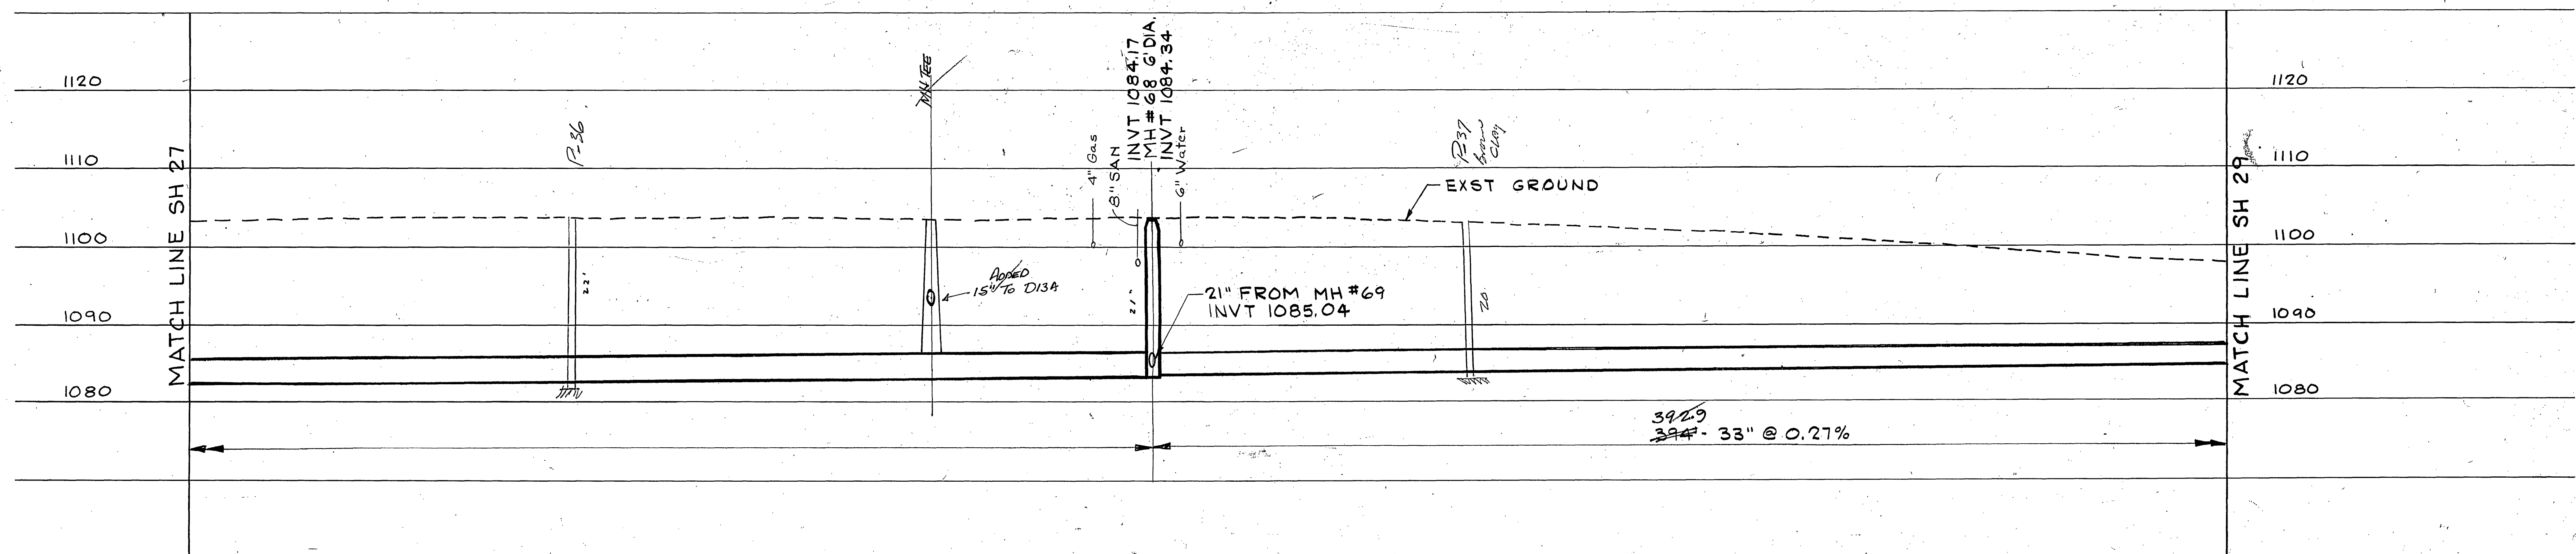


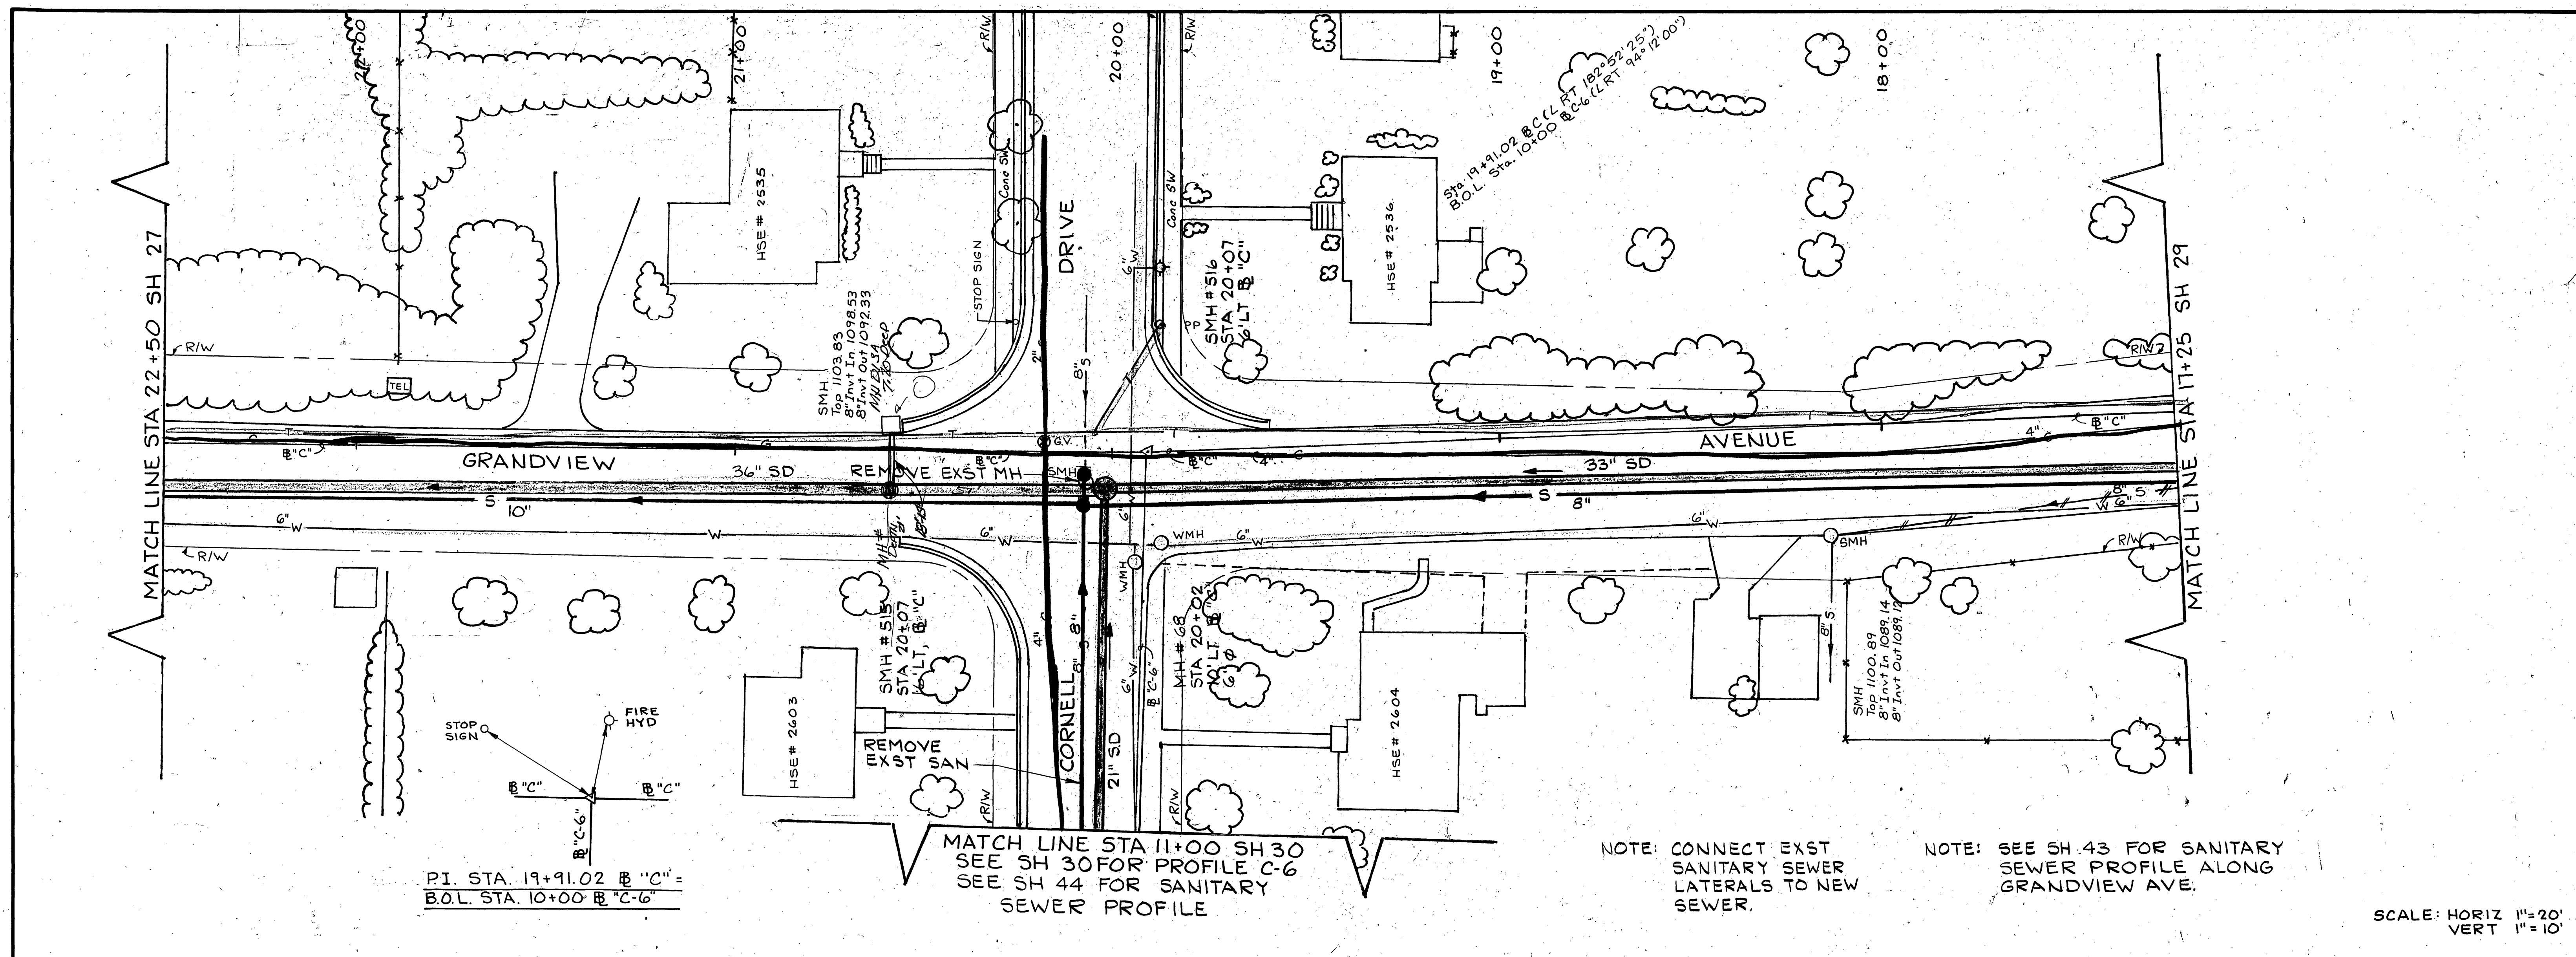

Mattern & Craig CONSULTING ENGINEERS SUITE 401, 707 S. JEFFERSON STREET, ROANOKE, VIRGINIA 24011, (703) 345-9342	DESIGNED: JLJ / SWH			REVISION	DATE	DESCRIPTION	BY	APP.	DATE JULY 1986	WILLIAMSON ROAD STORM DRAIN - PHASE 2 CONTRACT I-C ROANOKE, VIRGINIA	SHEET 28
	CHECKED: SWH								COMM. 582		PLAN AND PROFILE
	APPROVED: SWH										