

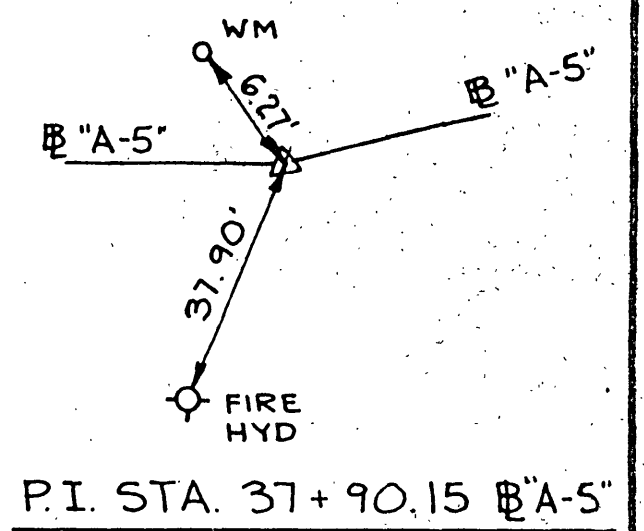


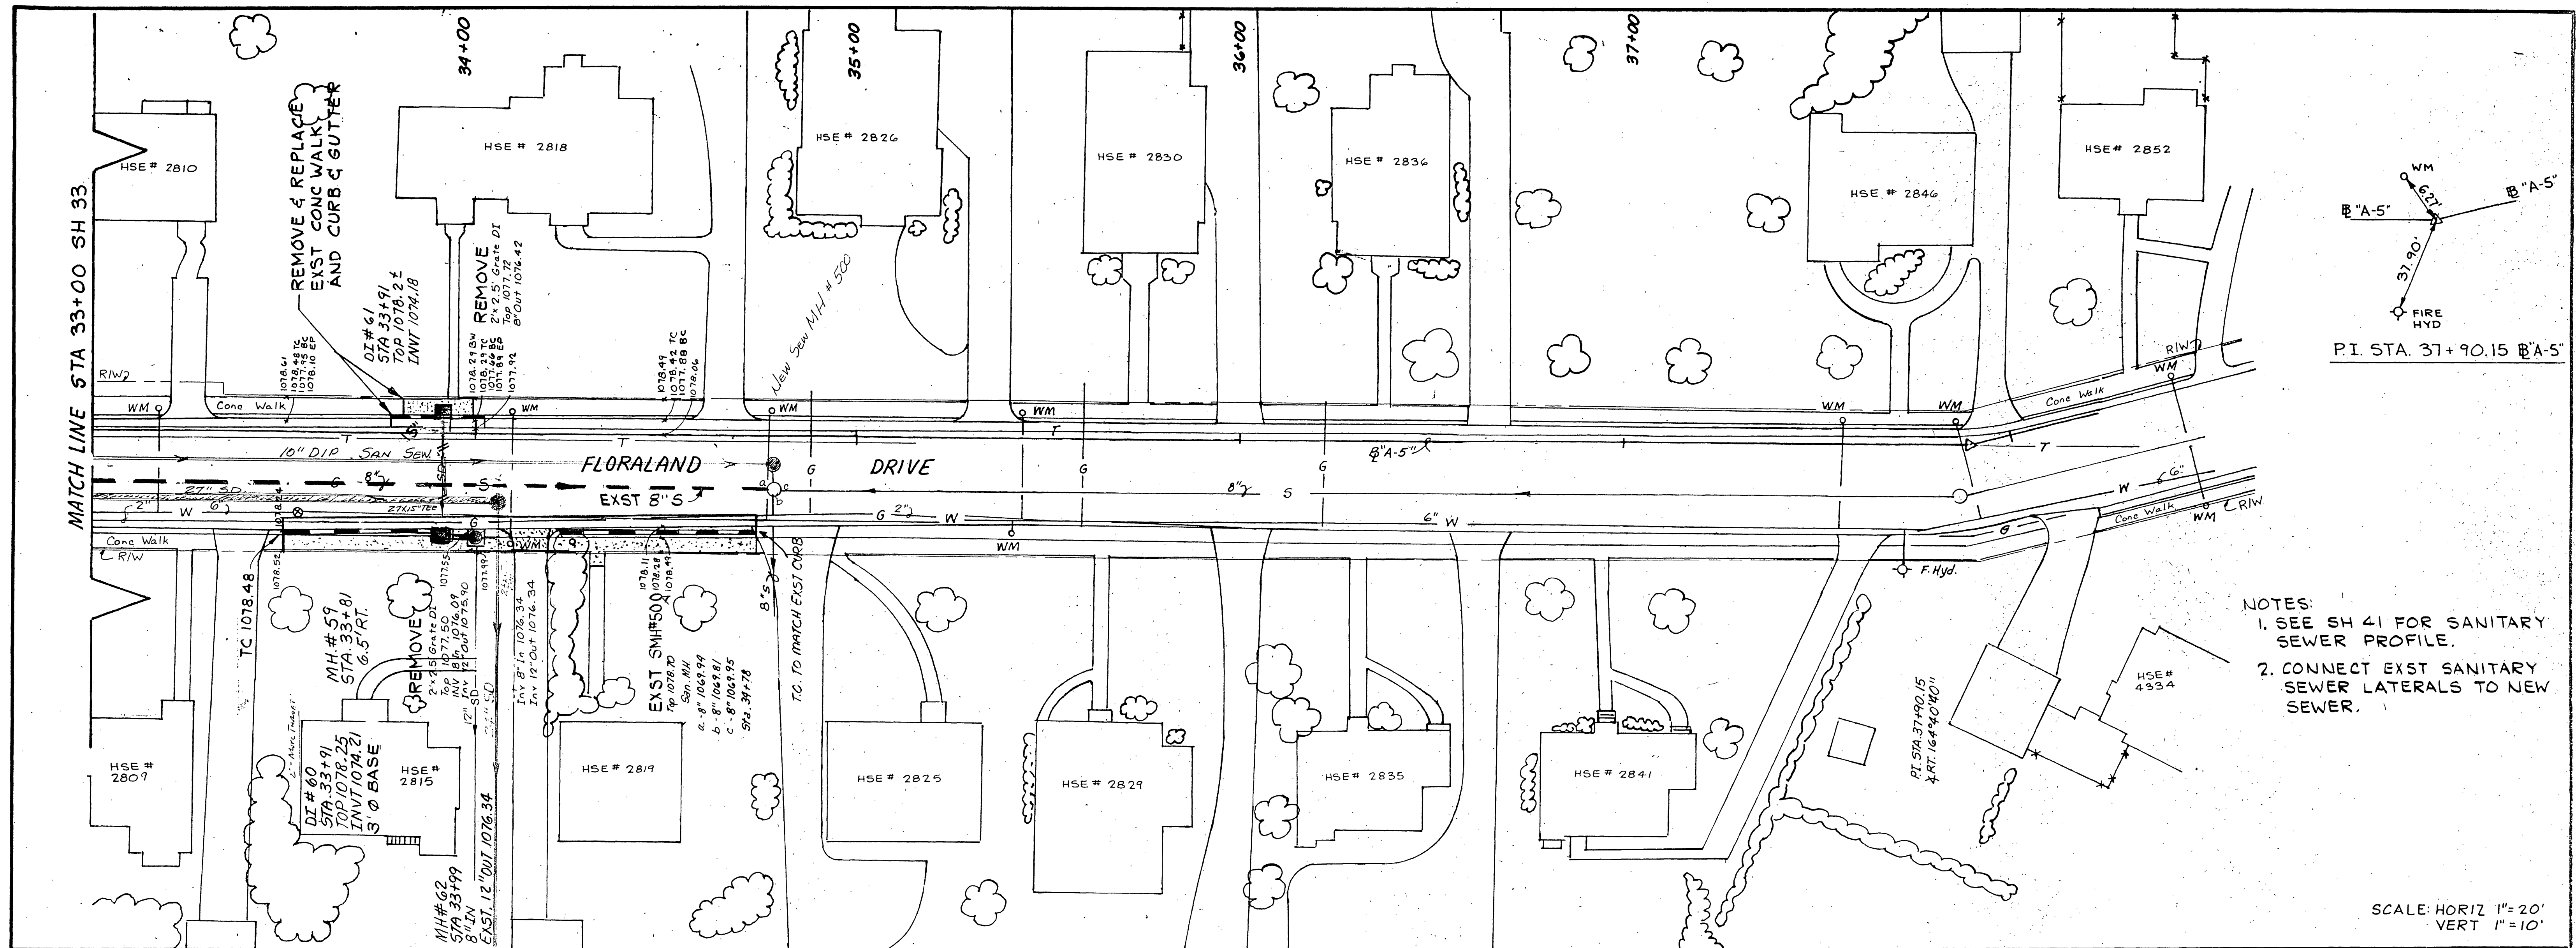

- NOTES:
1. SEE SH 41 FOR SANITARY SEWER PROFILE.
 2. CONNECT EXST SANITARY SEWER LATERALS TO NEW SEWER.

SCALE: HORIZ 1"=20'
VERT 1"=10'

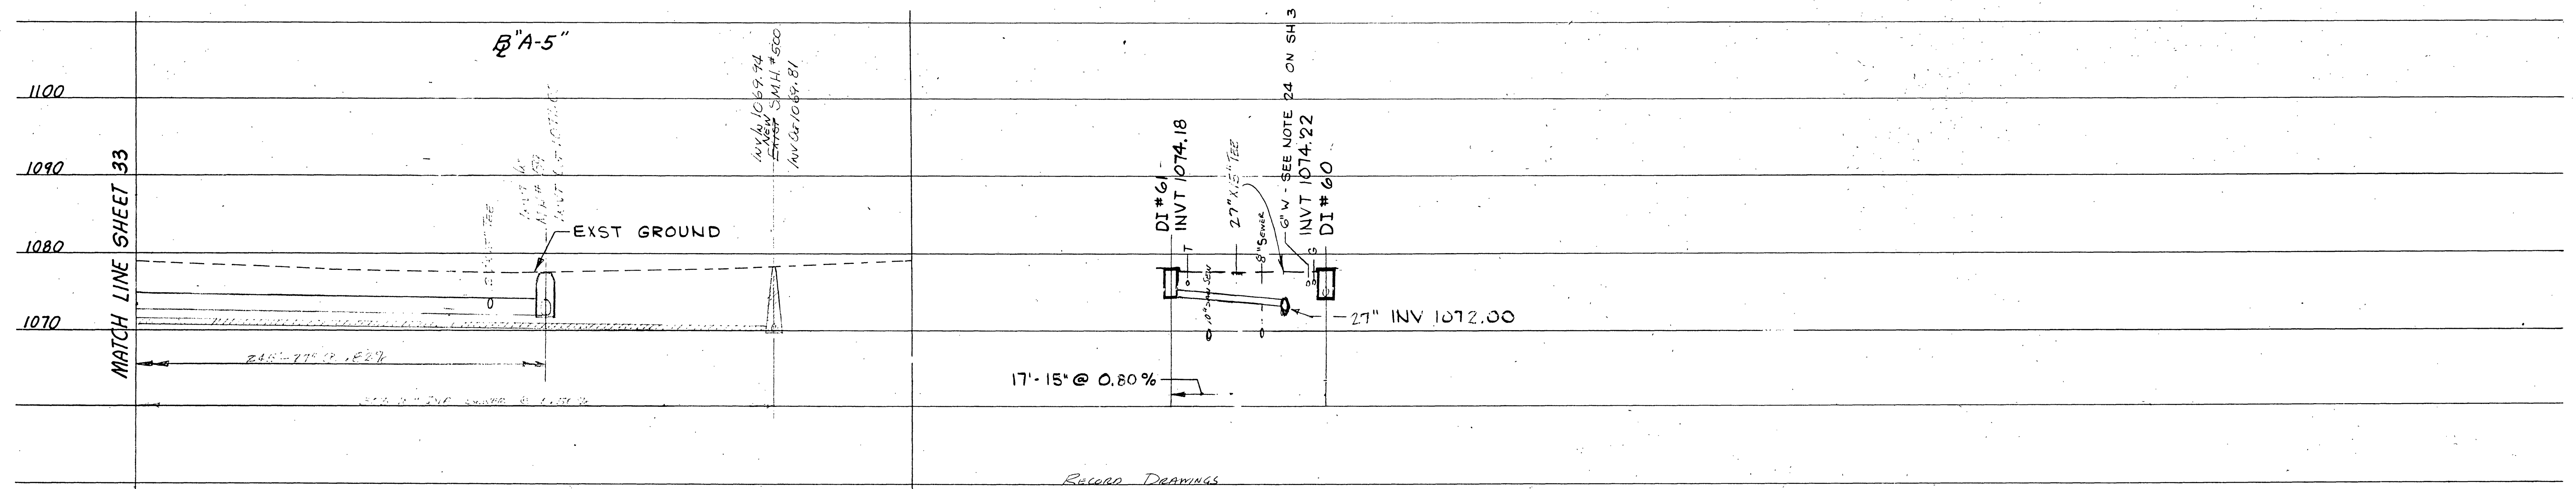

SUITE 401, 707 S. JEFFERSON STREET, ROANOKE, VIRGINIA 24011 (703) 345-9342	DESIGNED:	JLJ / SWH		REVISION	DATE	DESCRIPTION	BY	APP	DATE	WILLIAMSON ROAD STORM DRAIN - PHASE 2 CONTRACT I-C ROANOKE, VIRGINIA PLAN AND PROFILE	SHEET 34
	CHECKED:	SWH		1	12/2/81	Change from Preliminary to CD			JULY 1986		
	APPROVED:	SWH							COMM. 582		