



PLAN	SURVEYED	DATE
NOTE BOOK	PLOTTED	BY
No.	ALIGNMENT CHECKED	
	ET. OF WAY CHECKED	

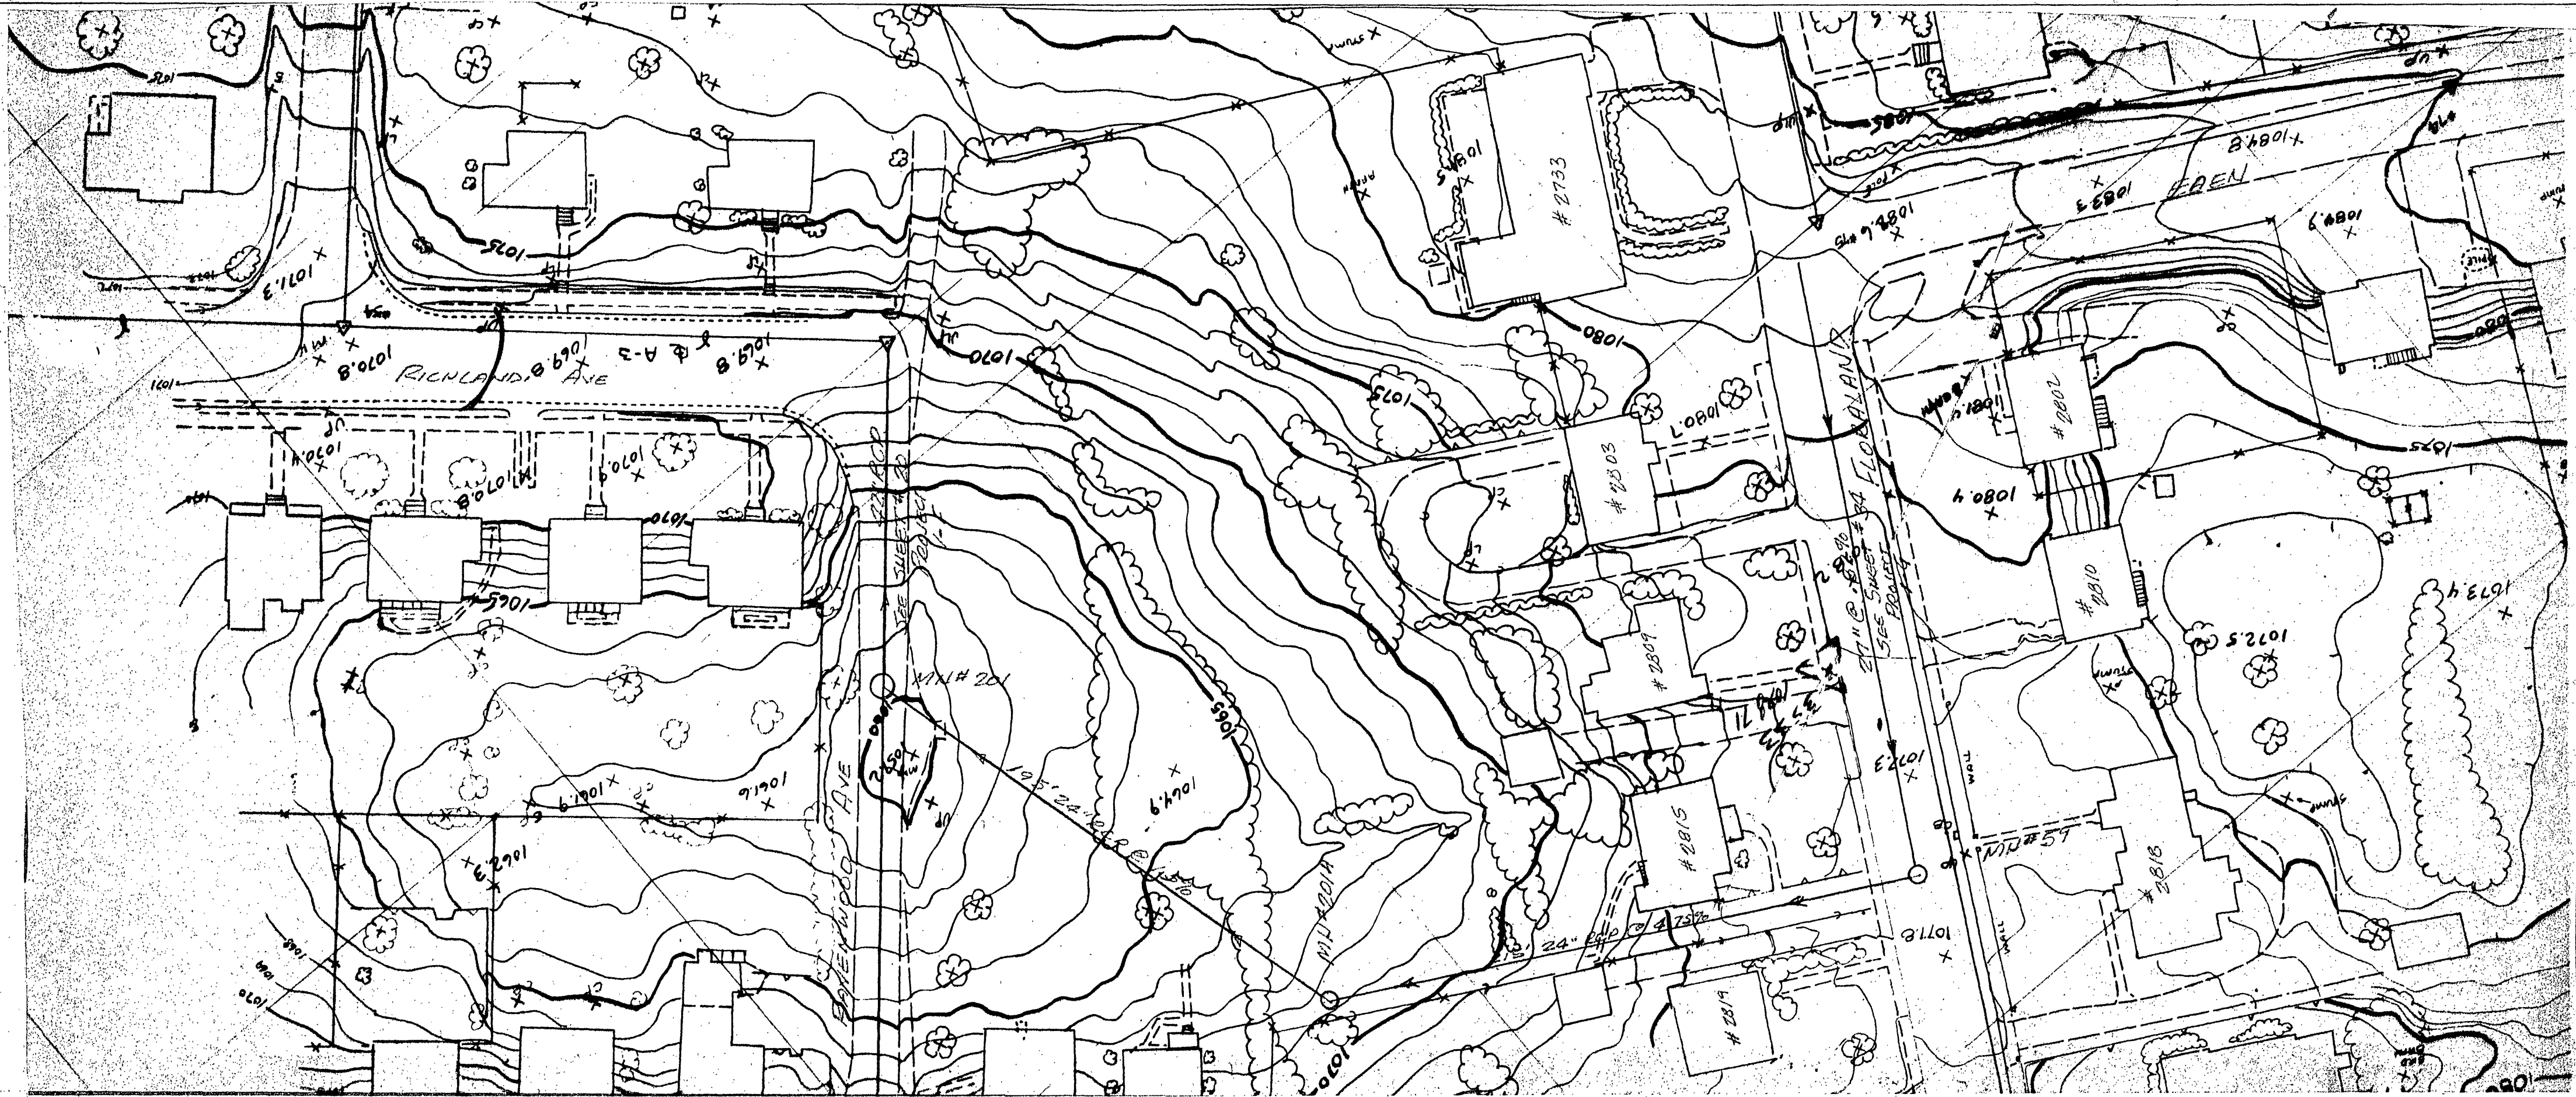

PLAN SCALE 1" = 40'-0"

PROFILE	SURVEYED	DATE
NOTE BOOK	PLOTTED	11/82
No.	GRADES CHECKED	
	STRUCTURE NOTATIONS CHECKED	

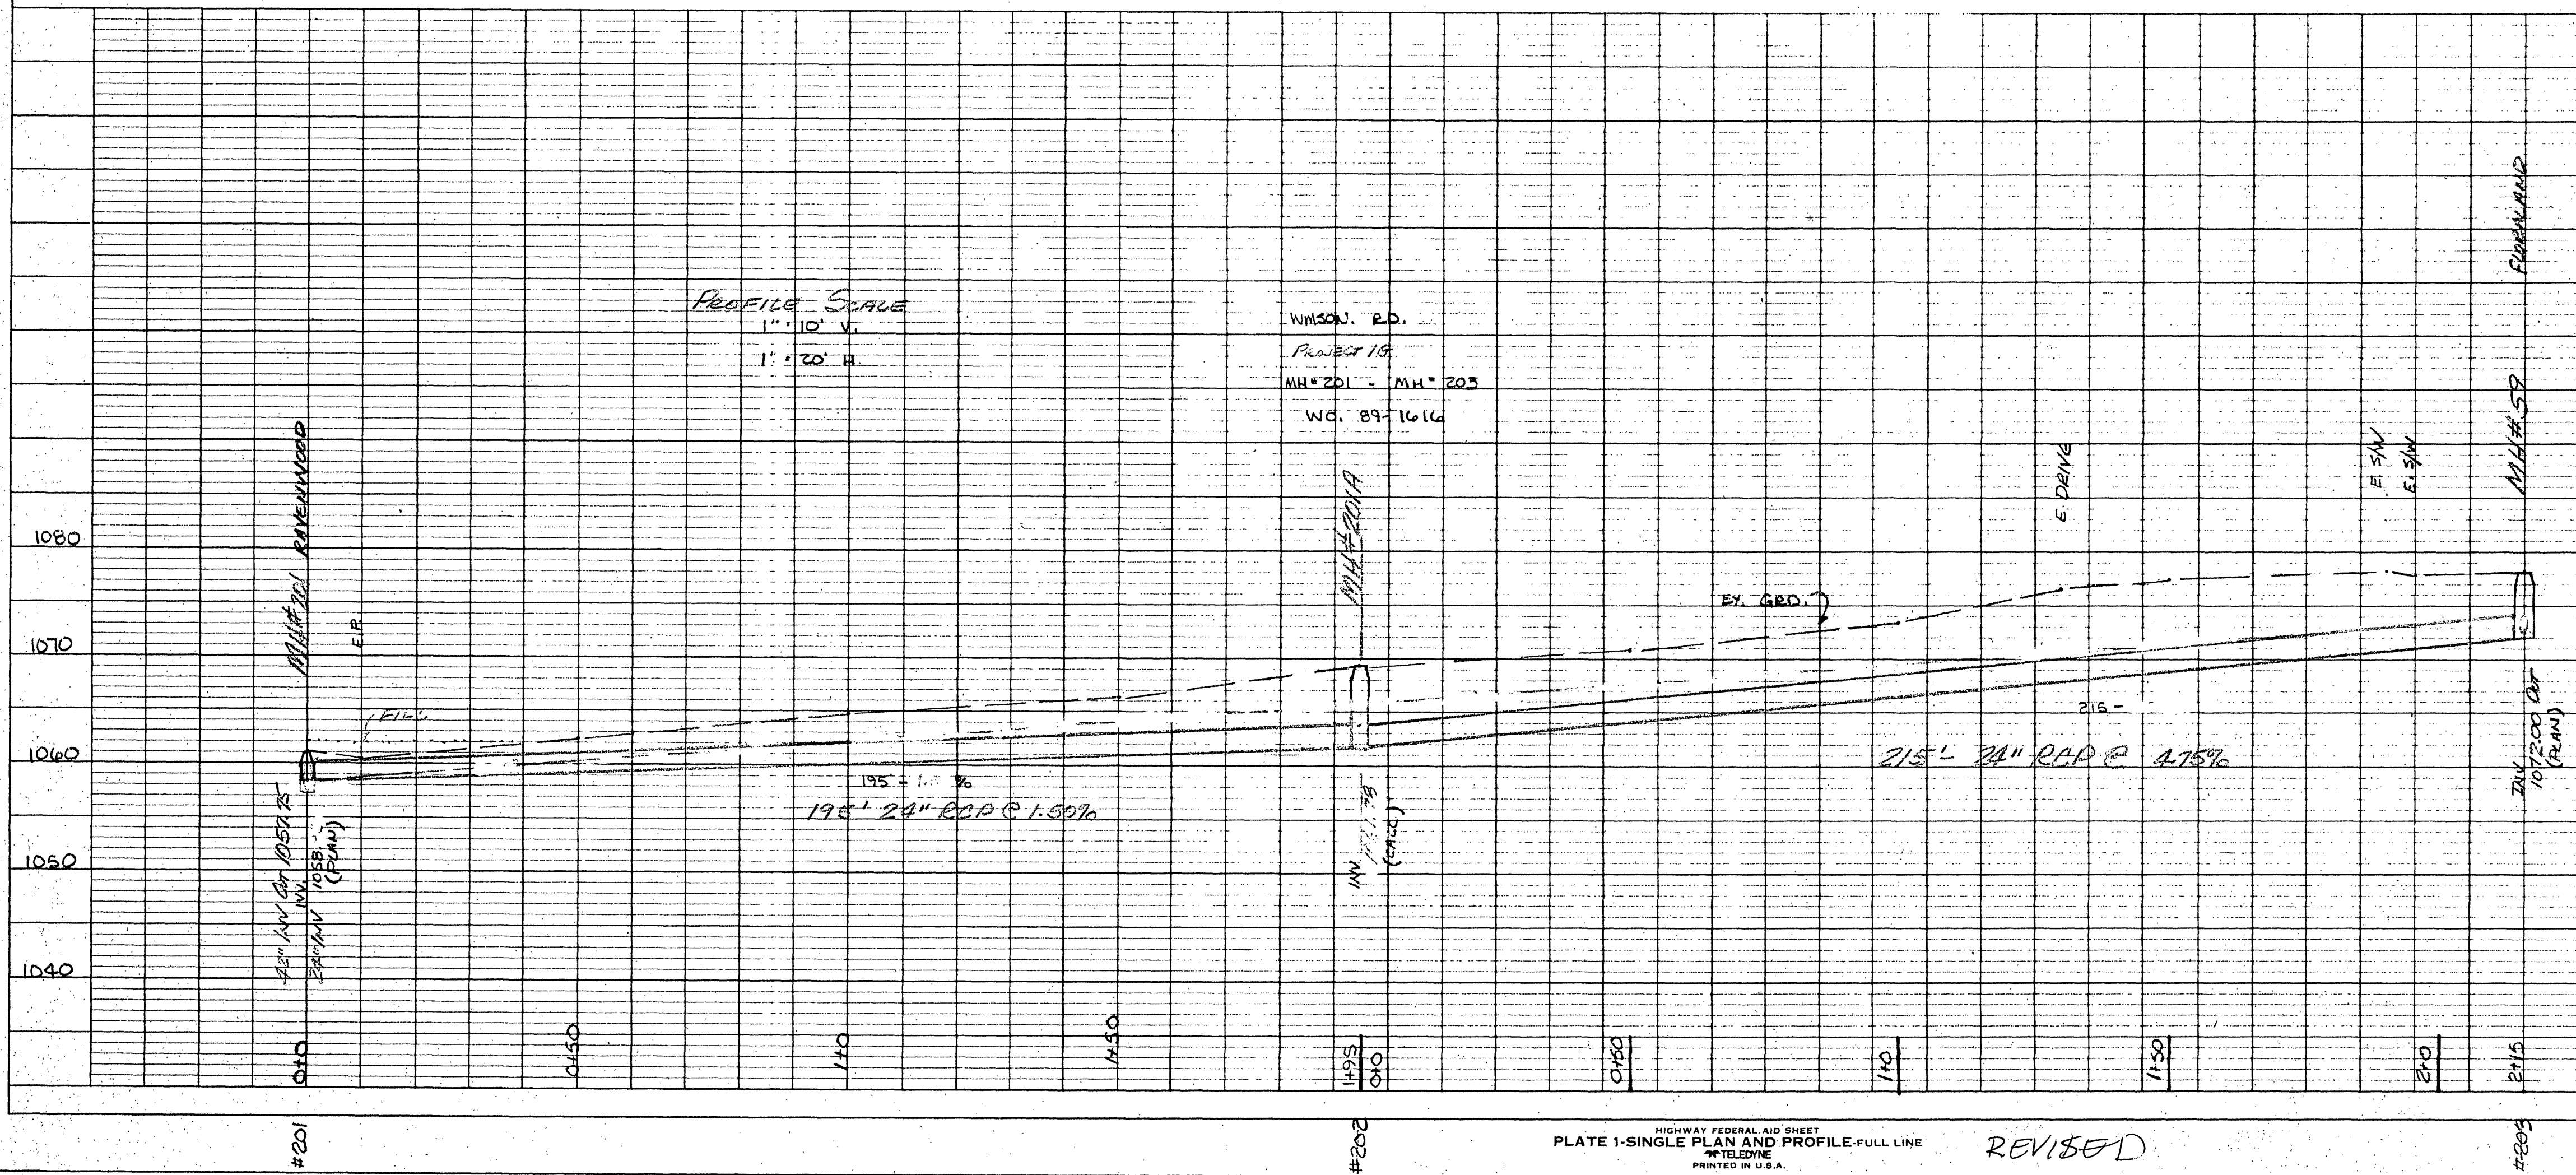

WILKINSON ROAD STORM DRAIN
PHASE II CONTRACT 16
PLAN FROM M.C. Aerial Photo
PROFILE STATIONED AND FIRST ELEVATION
PRIVATE PROPERTY EASEMENTS