
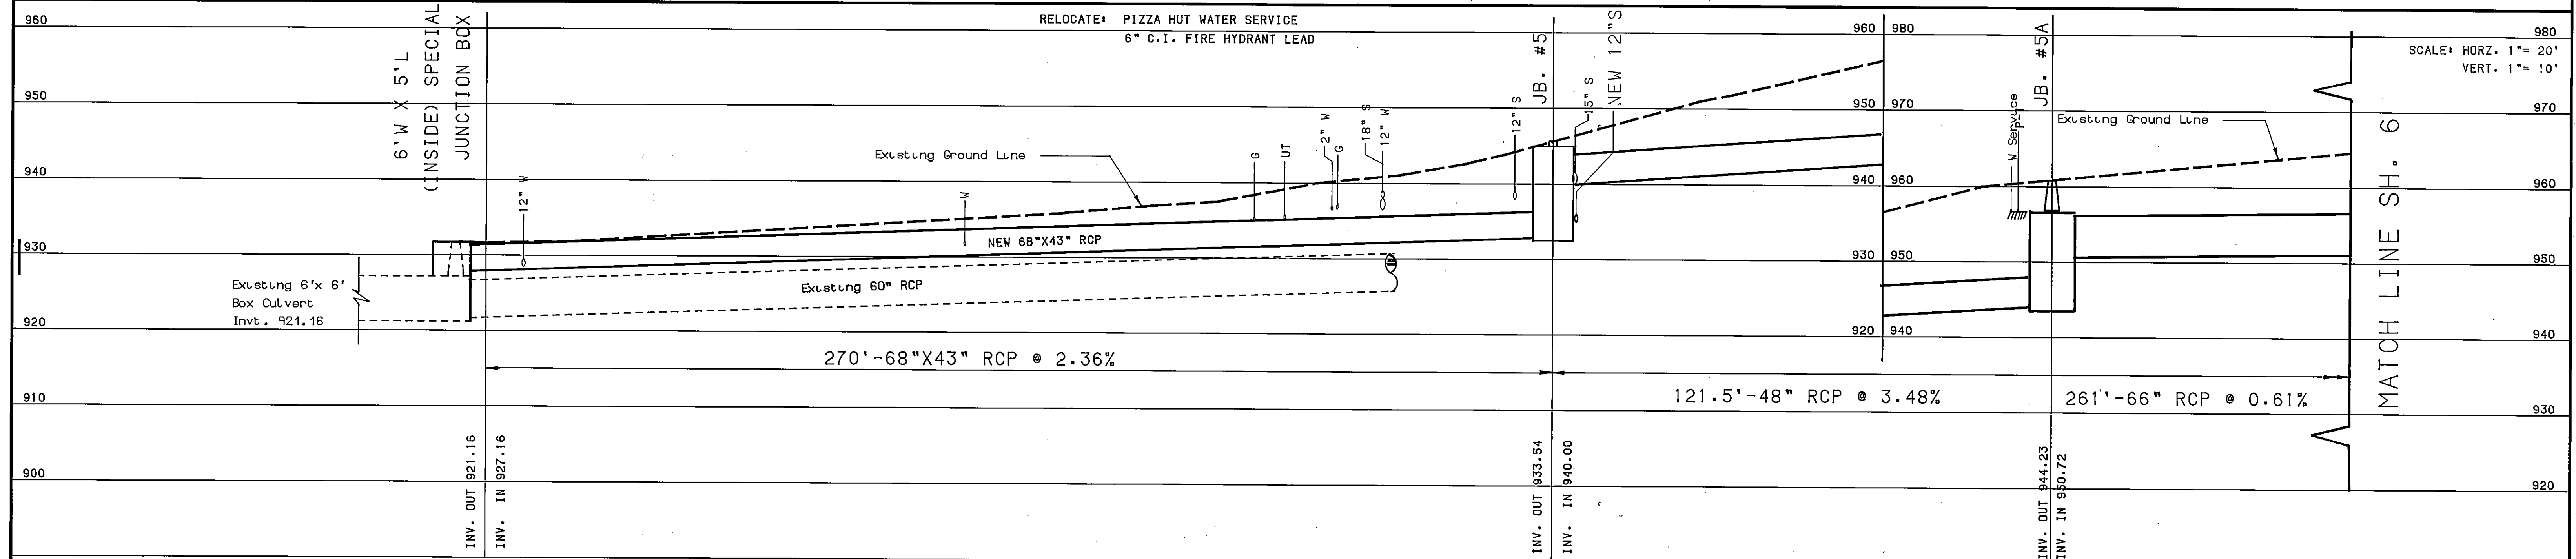


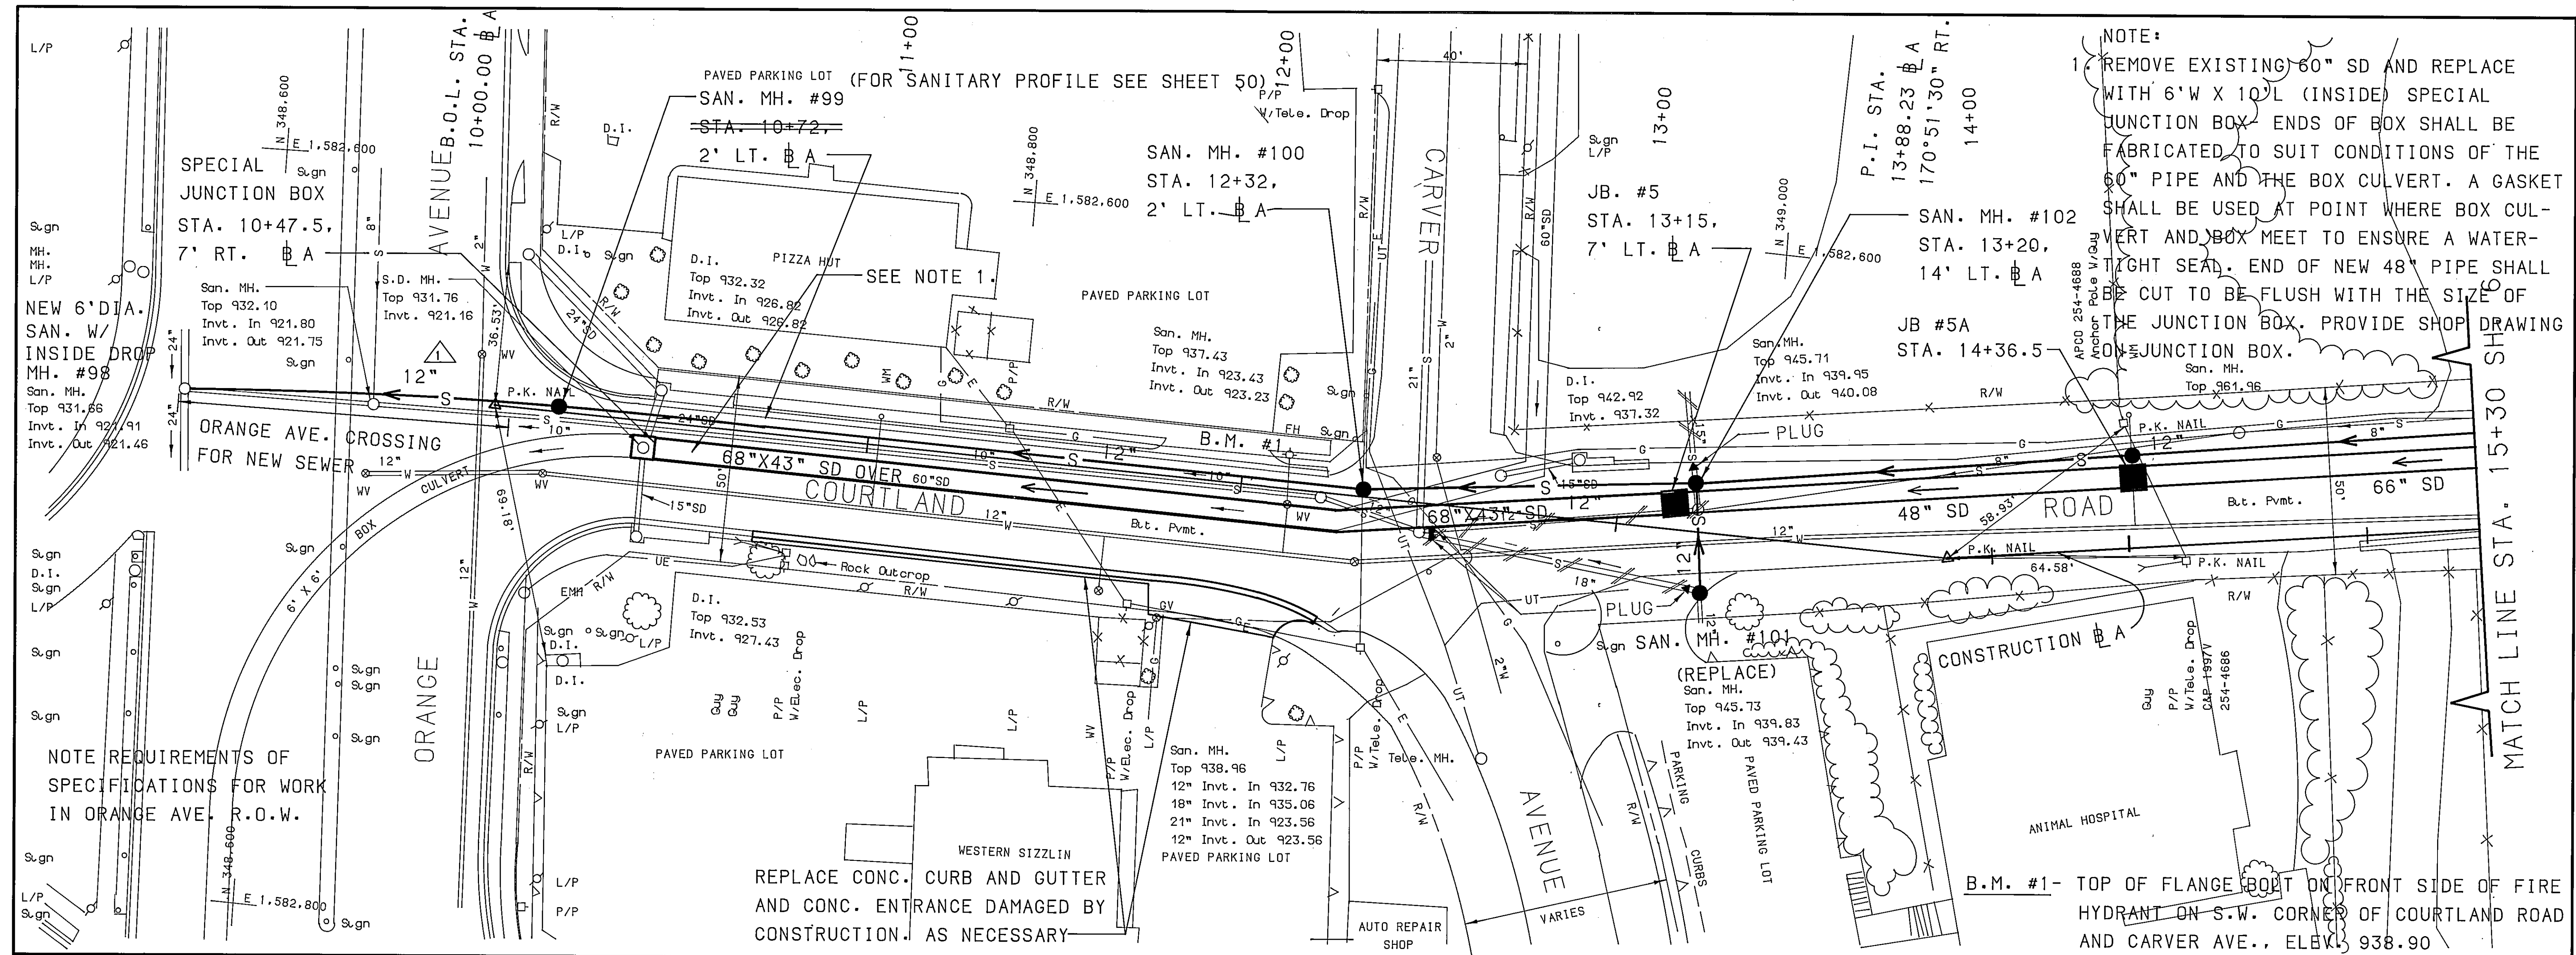

Mattern & Craig CONSULTING ENGINEERS - SURVEYORS 701 FIRST STREET, ROANOKE, VIRGINIA 24010, (703) 345-0342	DESIGNED: ARB/SWH			REVISION	DATE	DESCRIPTION	BY	APP.	DATE JULY 1987 COMM. 580/581	WILLIAMSON ROAD STORM DRAIN- PHASE 2 CONTRACT II-A ROANOKE, VIRGINIA	SHEET 5
	CHECKED: SHM			1	0/14/87	SANITARY SIZE CHANGE	ARB	SWH			
	APPROVED:			2	DEC 89	RECORD DRAWINGS	JLJ	SWH			