
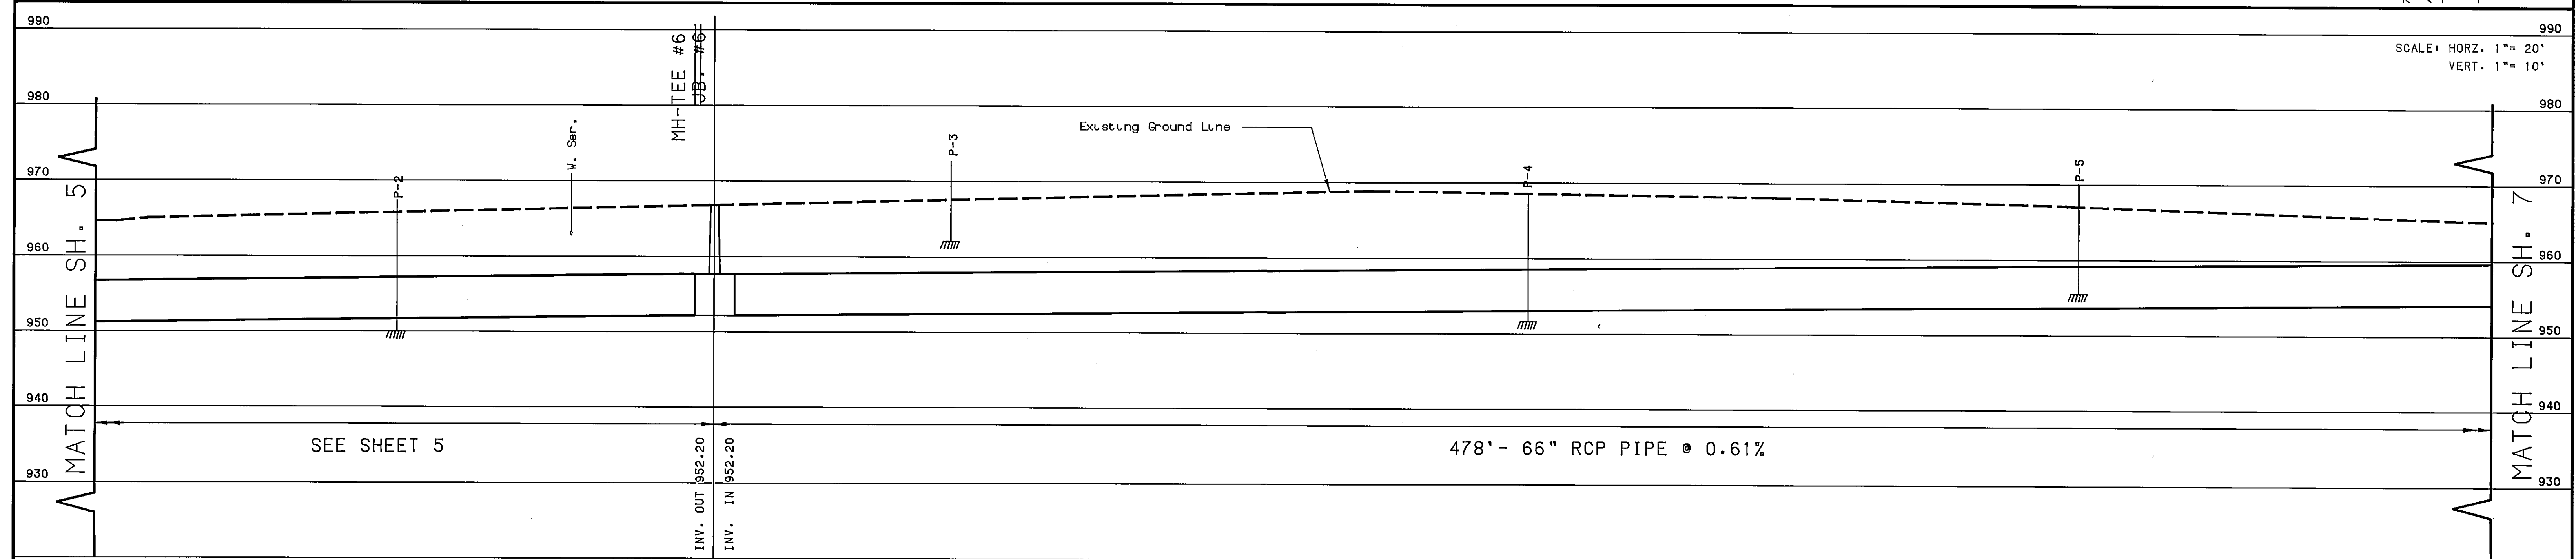


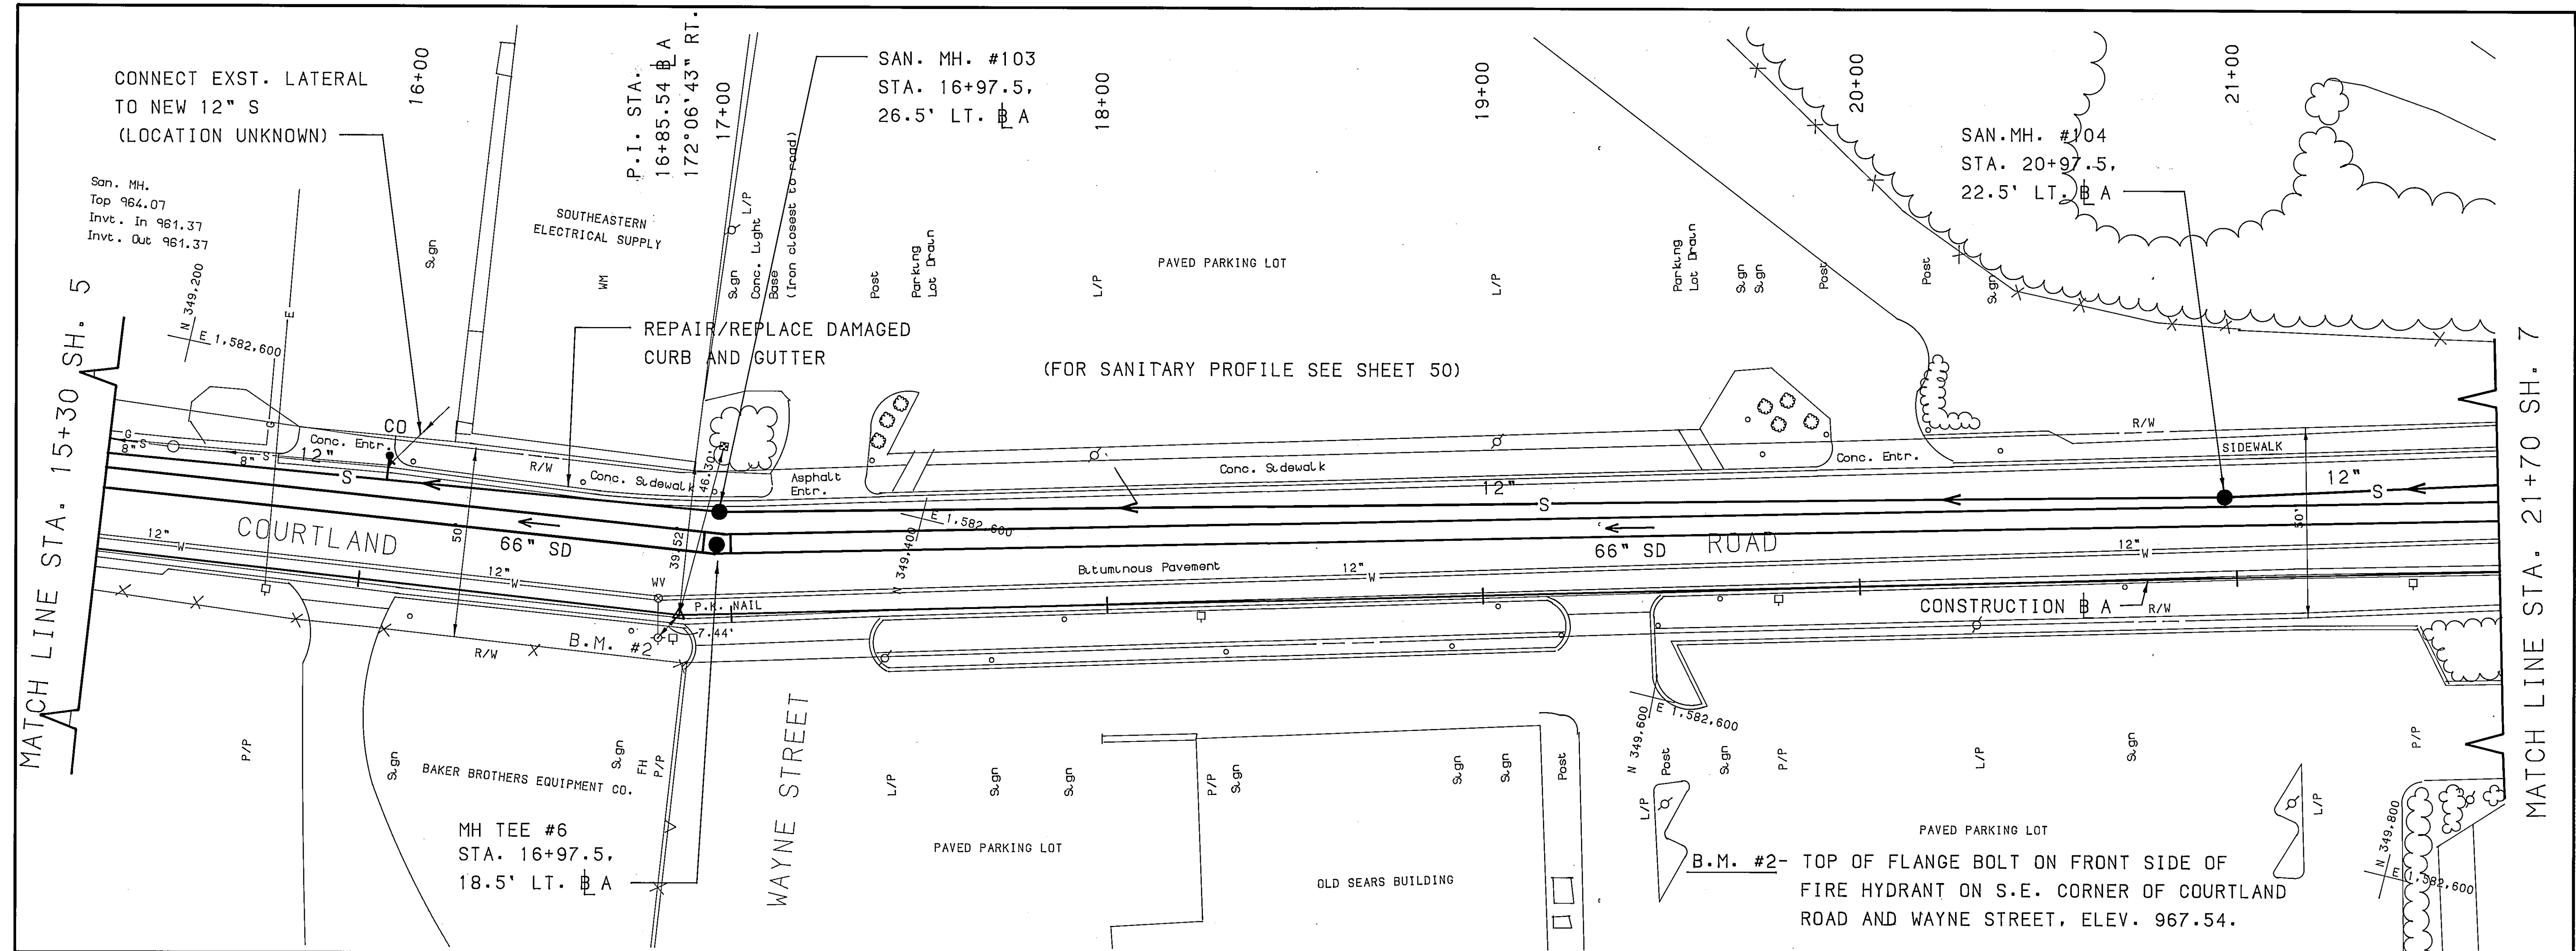

 Mattern & Craig CONSULTING ENGINEERS - SURVEYORS 701 FIRST STREET, ROANOKE, VIRGINIA 24010, (703) 345-9342	DESIGNED:	ARB/SWH			REVISION	DATE	DESCRIPTION	BY	APP.	DATE JULY 1987 COMM.	WILLIAMSON ROAD STORM DRAIN- PHASE 2 CONTRACT II-A ROANOKE, VIRGINIA	SHEET 6
	CHECKED:	SHM			1	DEC. 89	RECORD DRAWINGS	JLJ	SWH			
	APPROVED:											
	580/581											
PLAN AND PROFILE												