

NOTES:

1. CONNECT ALL EXST. SEWER LATERALS. CITY WILL PROVIDE A TV LOG FOR LOCATIONS.


SAN. MH #127
STA. 50+53

SAN. MH.
Top 1007.62
Inv. In 1003.62
Inv. Out 1003.47
(ABANDON)

MATCH LINE STA. 50+50 SH. 20

MATCH LINE STA. 55+85 SH. 14

(FOR SANITARY PROFILE SEE SHEET 55)

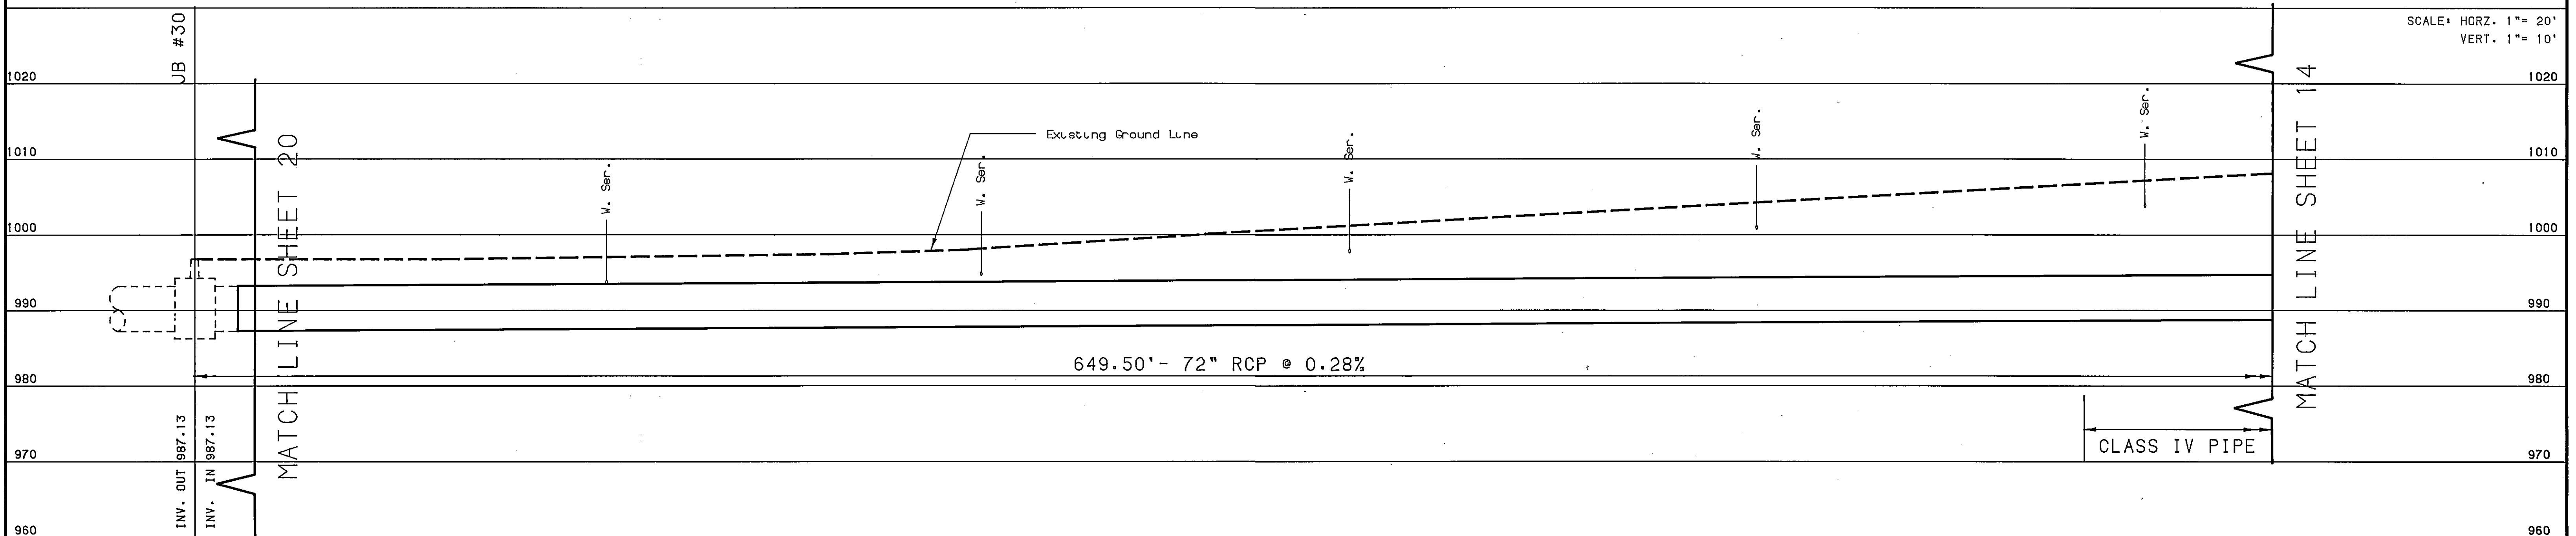

 Mattern & Craig CONSULTING ENGINEERS - SURVEYORS 701 FIRST STREET, ROANOKE, VIRGINIA 24016, (703) 345-9342	DESIGNED:	ARB/SWH			REVISION	DATE	DESCRIPTION	BY	APP.	DATE	WILLIAMSON ROAD STORM DRAIN- PHASE 2 CONTRACT II-A ROANOKE, VIRGINIA	SHEET 12
	CHECKED:	GRN			1	DEC. 89	RECORD DRAWING	JLJ	SWH	JULY 1987		
	APPROVED:									580/581		
	PLAN AND PROFILE											