



(FOR SANITARY PROFILE SEE SHEET 53)

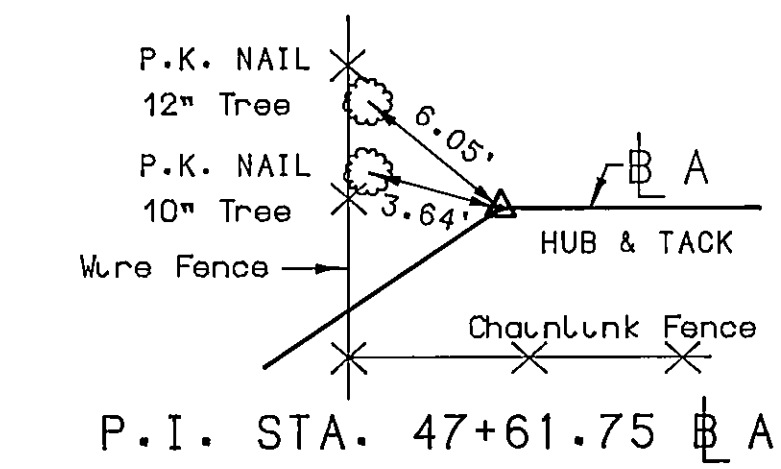


LOCATE AND CONNECT EXST.
SAN. LATERAL TO NEW
14\"/>

10' CONSTRUCTION EASEMENT	10'
15' PERMANENT EASEMENT	7.5'
10' CONSTRUCTION EASEMENT	7.5'

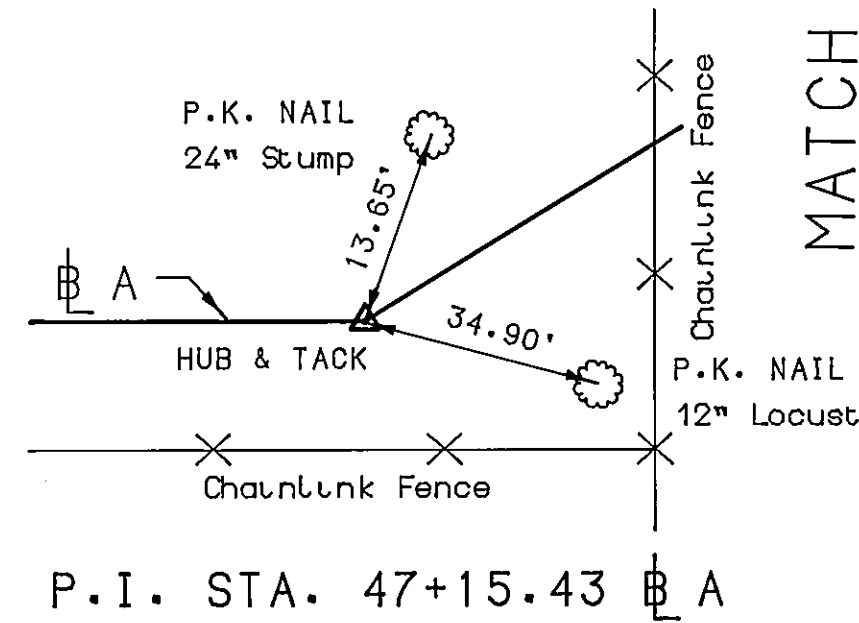

MATCH LINE STA. 46+60 SH. 19

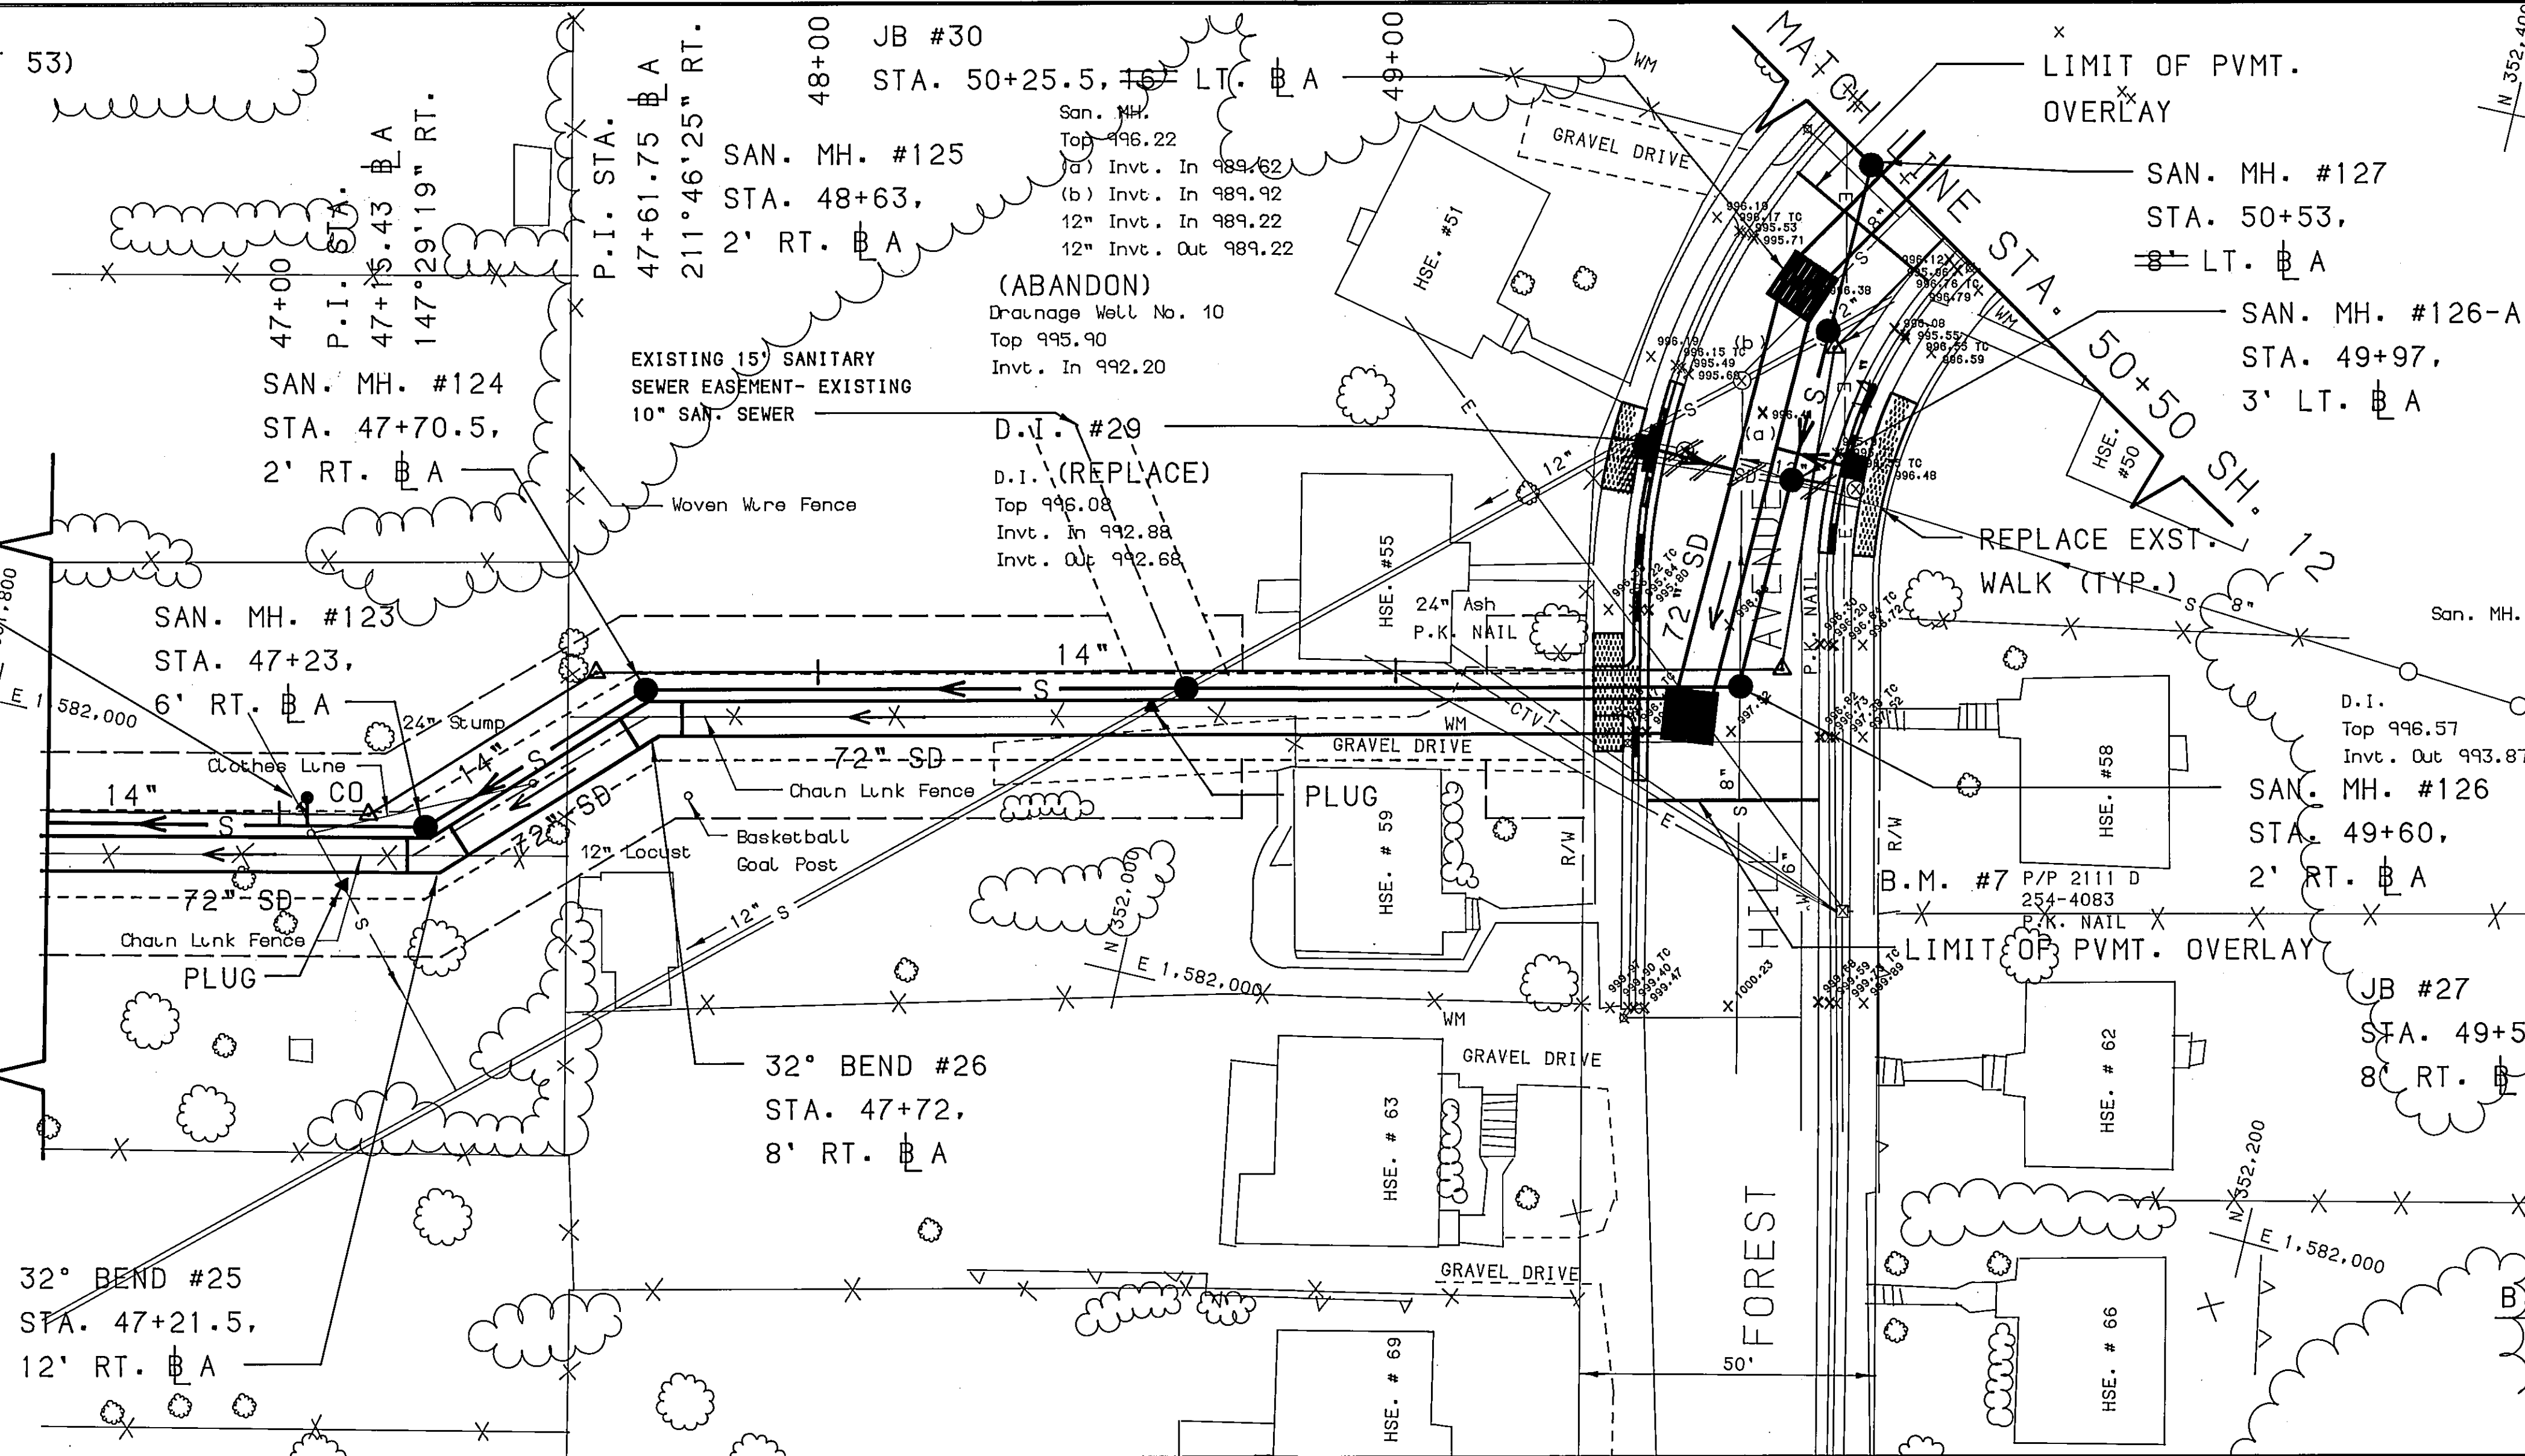

REMOVE EXST. INLETS, CAP DRAINAGE
WELL AND PLUG PIPES.


REPLACE EXST. WALKS AND CURB AND GUTTER,
REPLACE FULL SECTIONS.

P.I. STA.
50+23.20
215°24'36\"/>

P.I. STA.
49+67.06
99°34'42\"/>

D.I. #28
STA. 50+04

P.I. STA. 49+67.06
B.M. #7
P.P. 2111 D
254-4083
ELEV. 1002.52

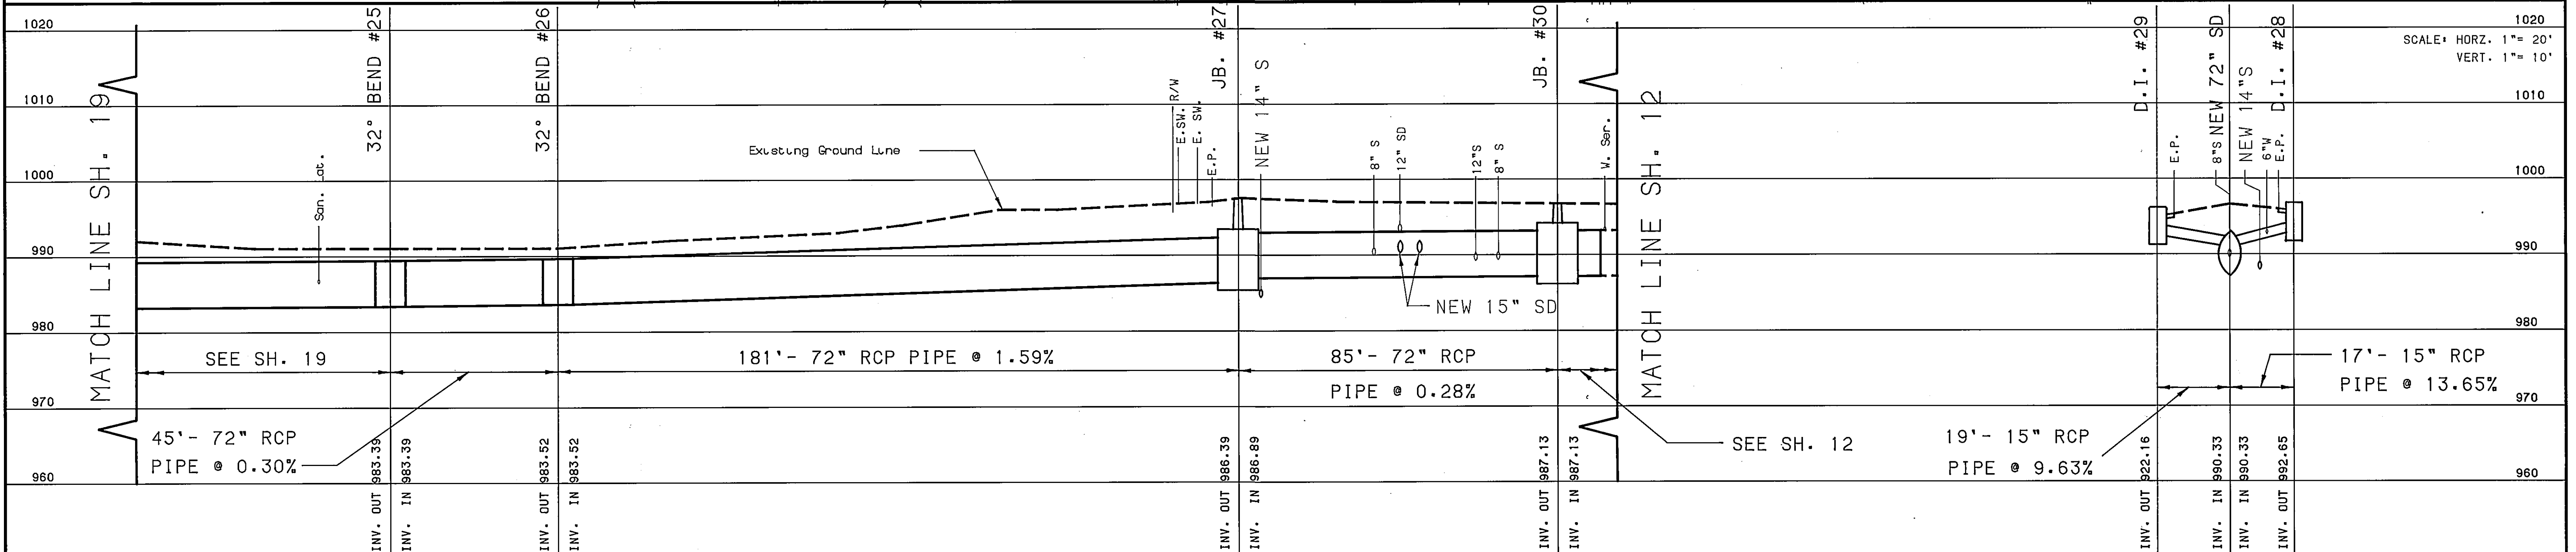

 Mattern & Craig CONSULTING ENGINEERS - SURVEYORS 701 FIRST STREET, ROANOKE, VIRGINIA 24016, (703) 345-9342	DESIGNED: ARB/SWH			REVISION 1	DATE DEC. 89	DESCRIPTION RECORD DRAWING	BY JLJ	APP. SWH	DATE JULY 1987 COMM.	580/581	WILLIAMSON ROAD STORM DRAIN- PHASE 2 CONTRACT II-A ROANOKE, VIRGINIA	SHEET 20	
	CHECKED: SHM												
	APPROVED:												