

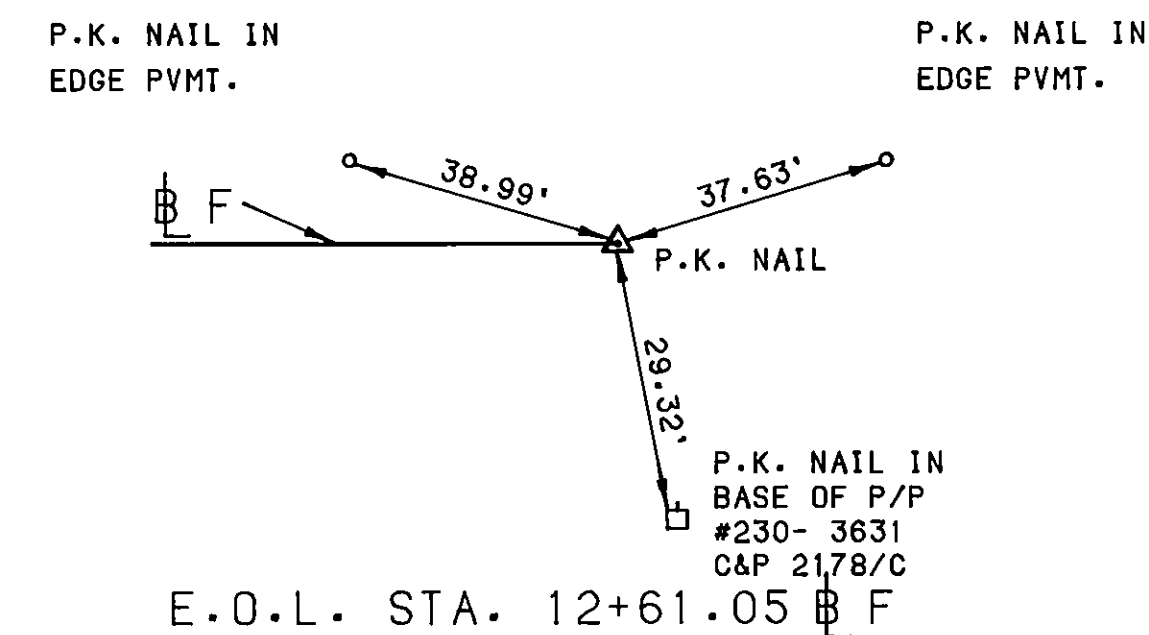
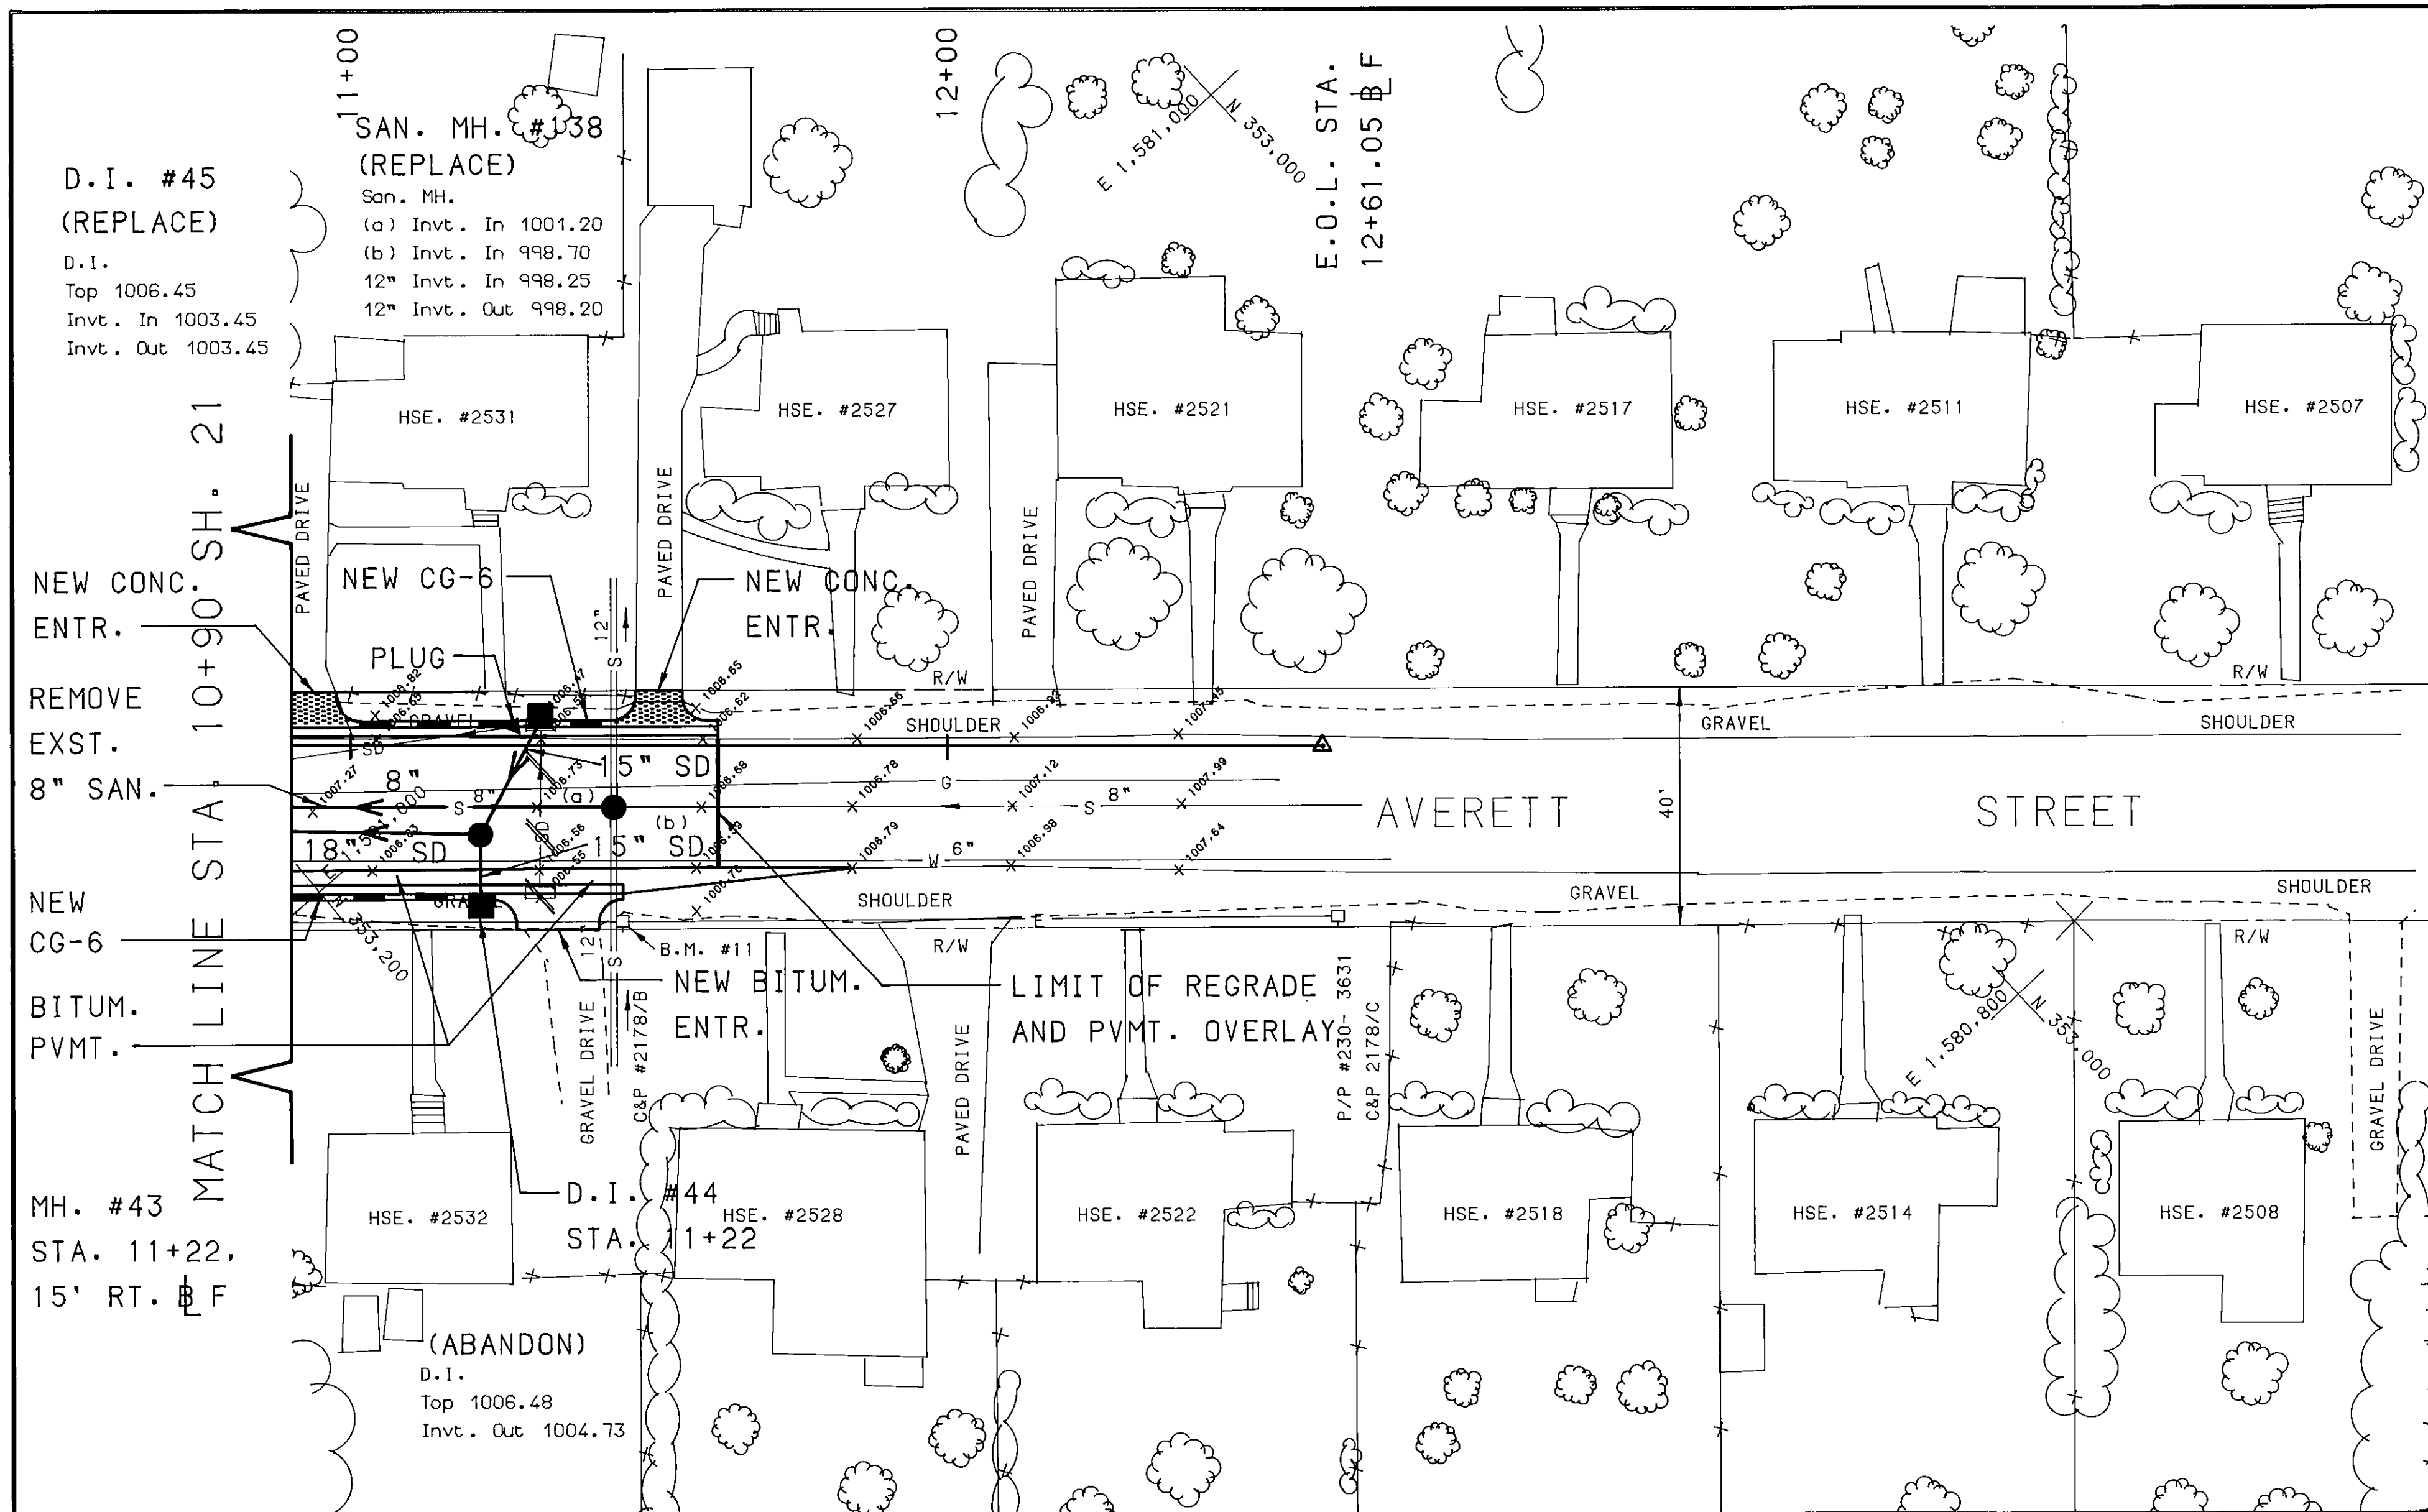
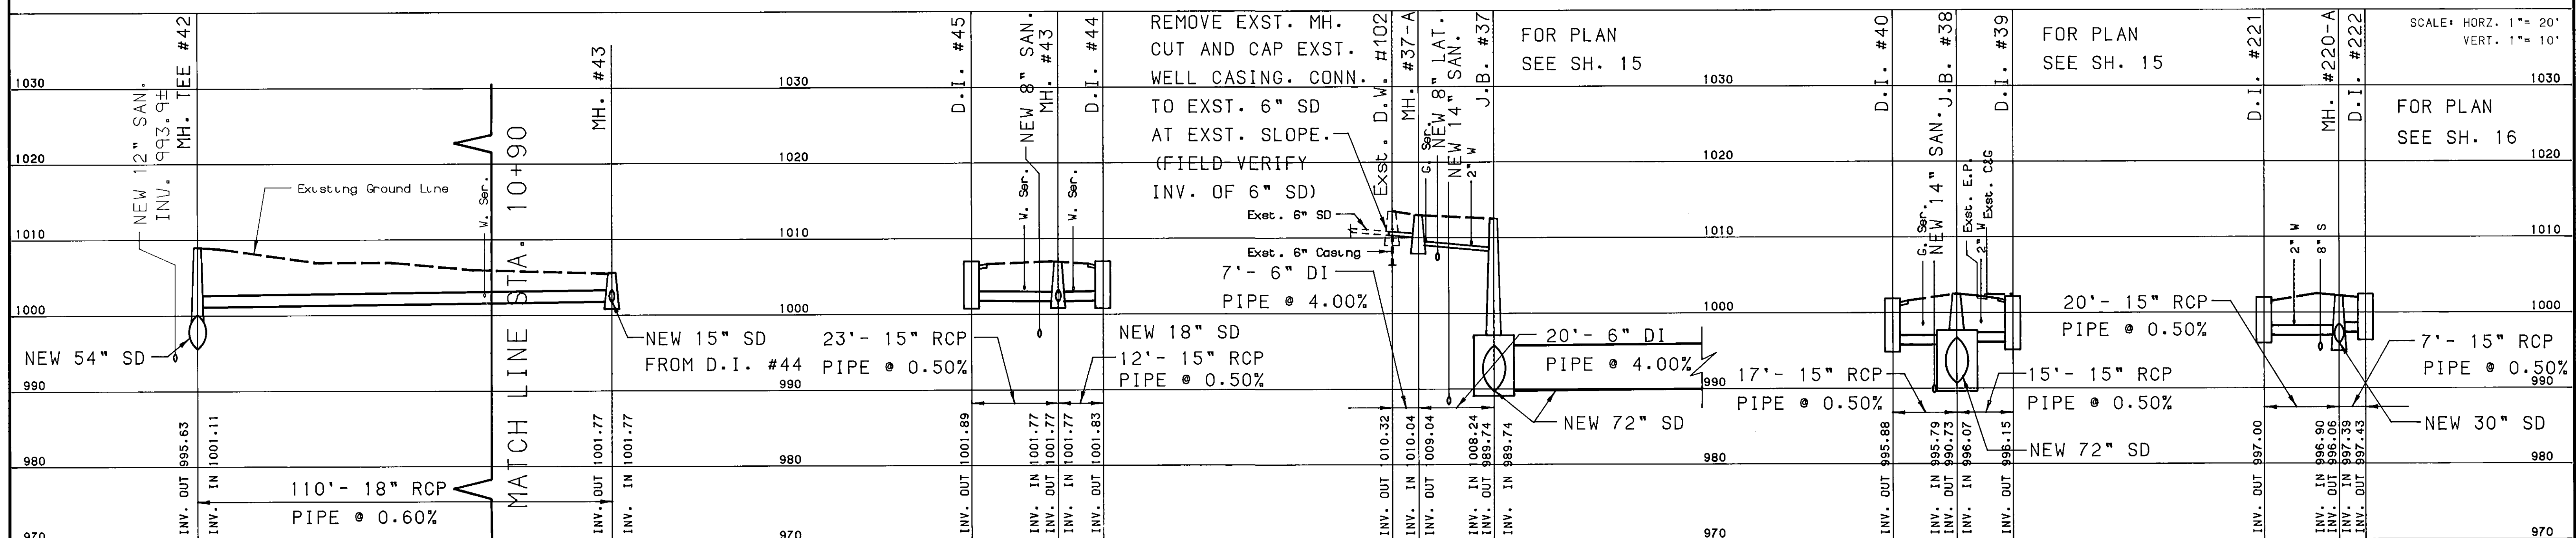
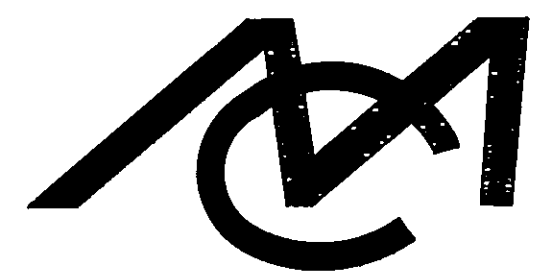


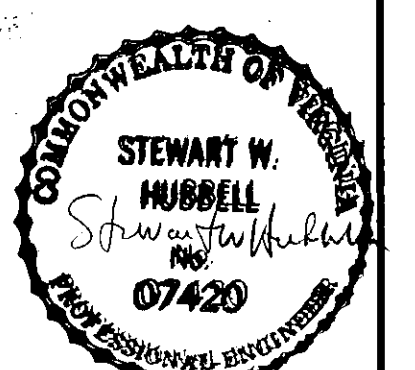

B.M. #11- R.R. SPIKE SET IN BASE OF C&P POLE
#2178/B ON NORTH SIDE OF AVERETT STREET
BETWEEN HSE. #2532 AND HSE. #2528, ELEV. 1008.10.

(FOR SANITARY PROFILE SEE SHEET 58)

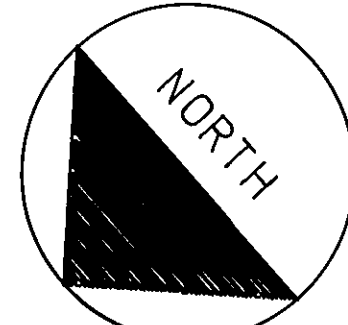

 Mattern & Craig CONSULTING ENGINEERS - SURVEYORS 701 FIRST STREET, ROANOKE, VIRGINIA 24010, (703) 345-9342	DESIGNED: ARB/SWH			REVISION	DATE	DESCRIPTION	BY	APP.	DATE JULY 1987 COMM. 580/581	WILLIAMSON ROAD STORM DRAIN- PHASE 2 CONTRACT II-A ROANOKE, VIRGINIA	SHEET 32
	CHECKED: GRN			1	DEC. 89	RECORD DRAWING	JLJ	SWH			
	APPROVED:										