



SAN. MH. #140
(REPLACE)
San. MH.
Top 1007.77
(a) Invt. In 1000.17
(b) Invt. In 1000.27
12" Invt. In 999.87
12" Invt. Out 999.77

MATCH LINE STA. 10+85 SH. 22

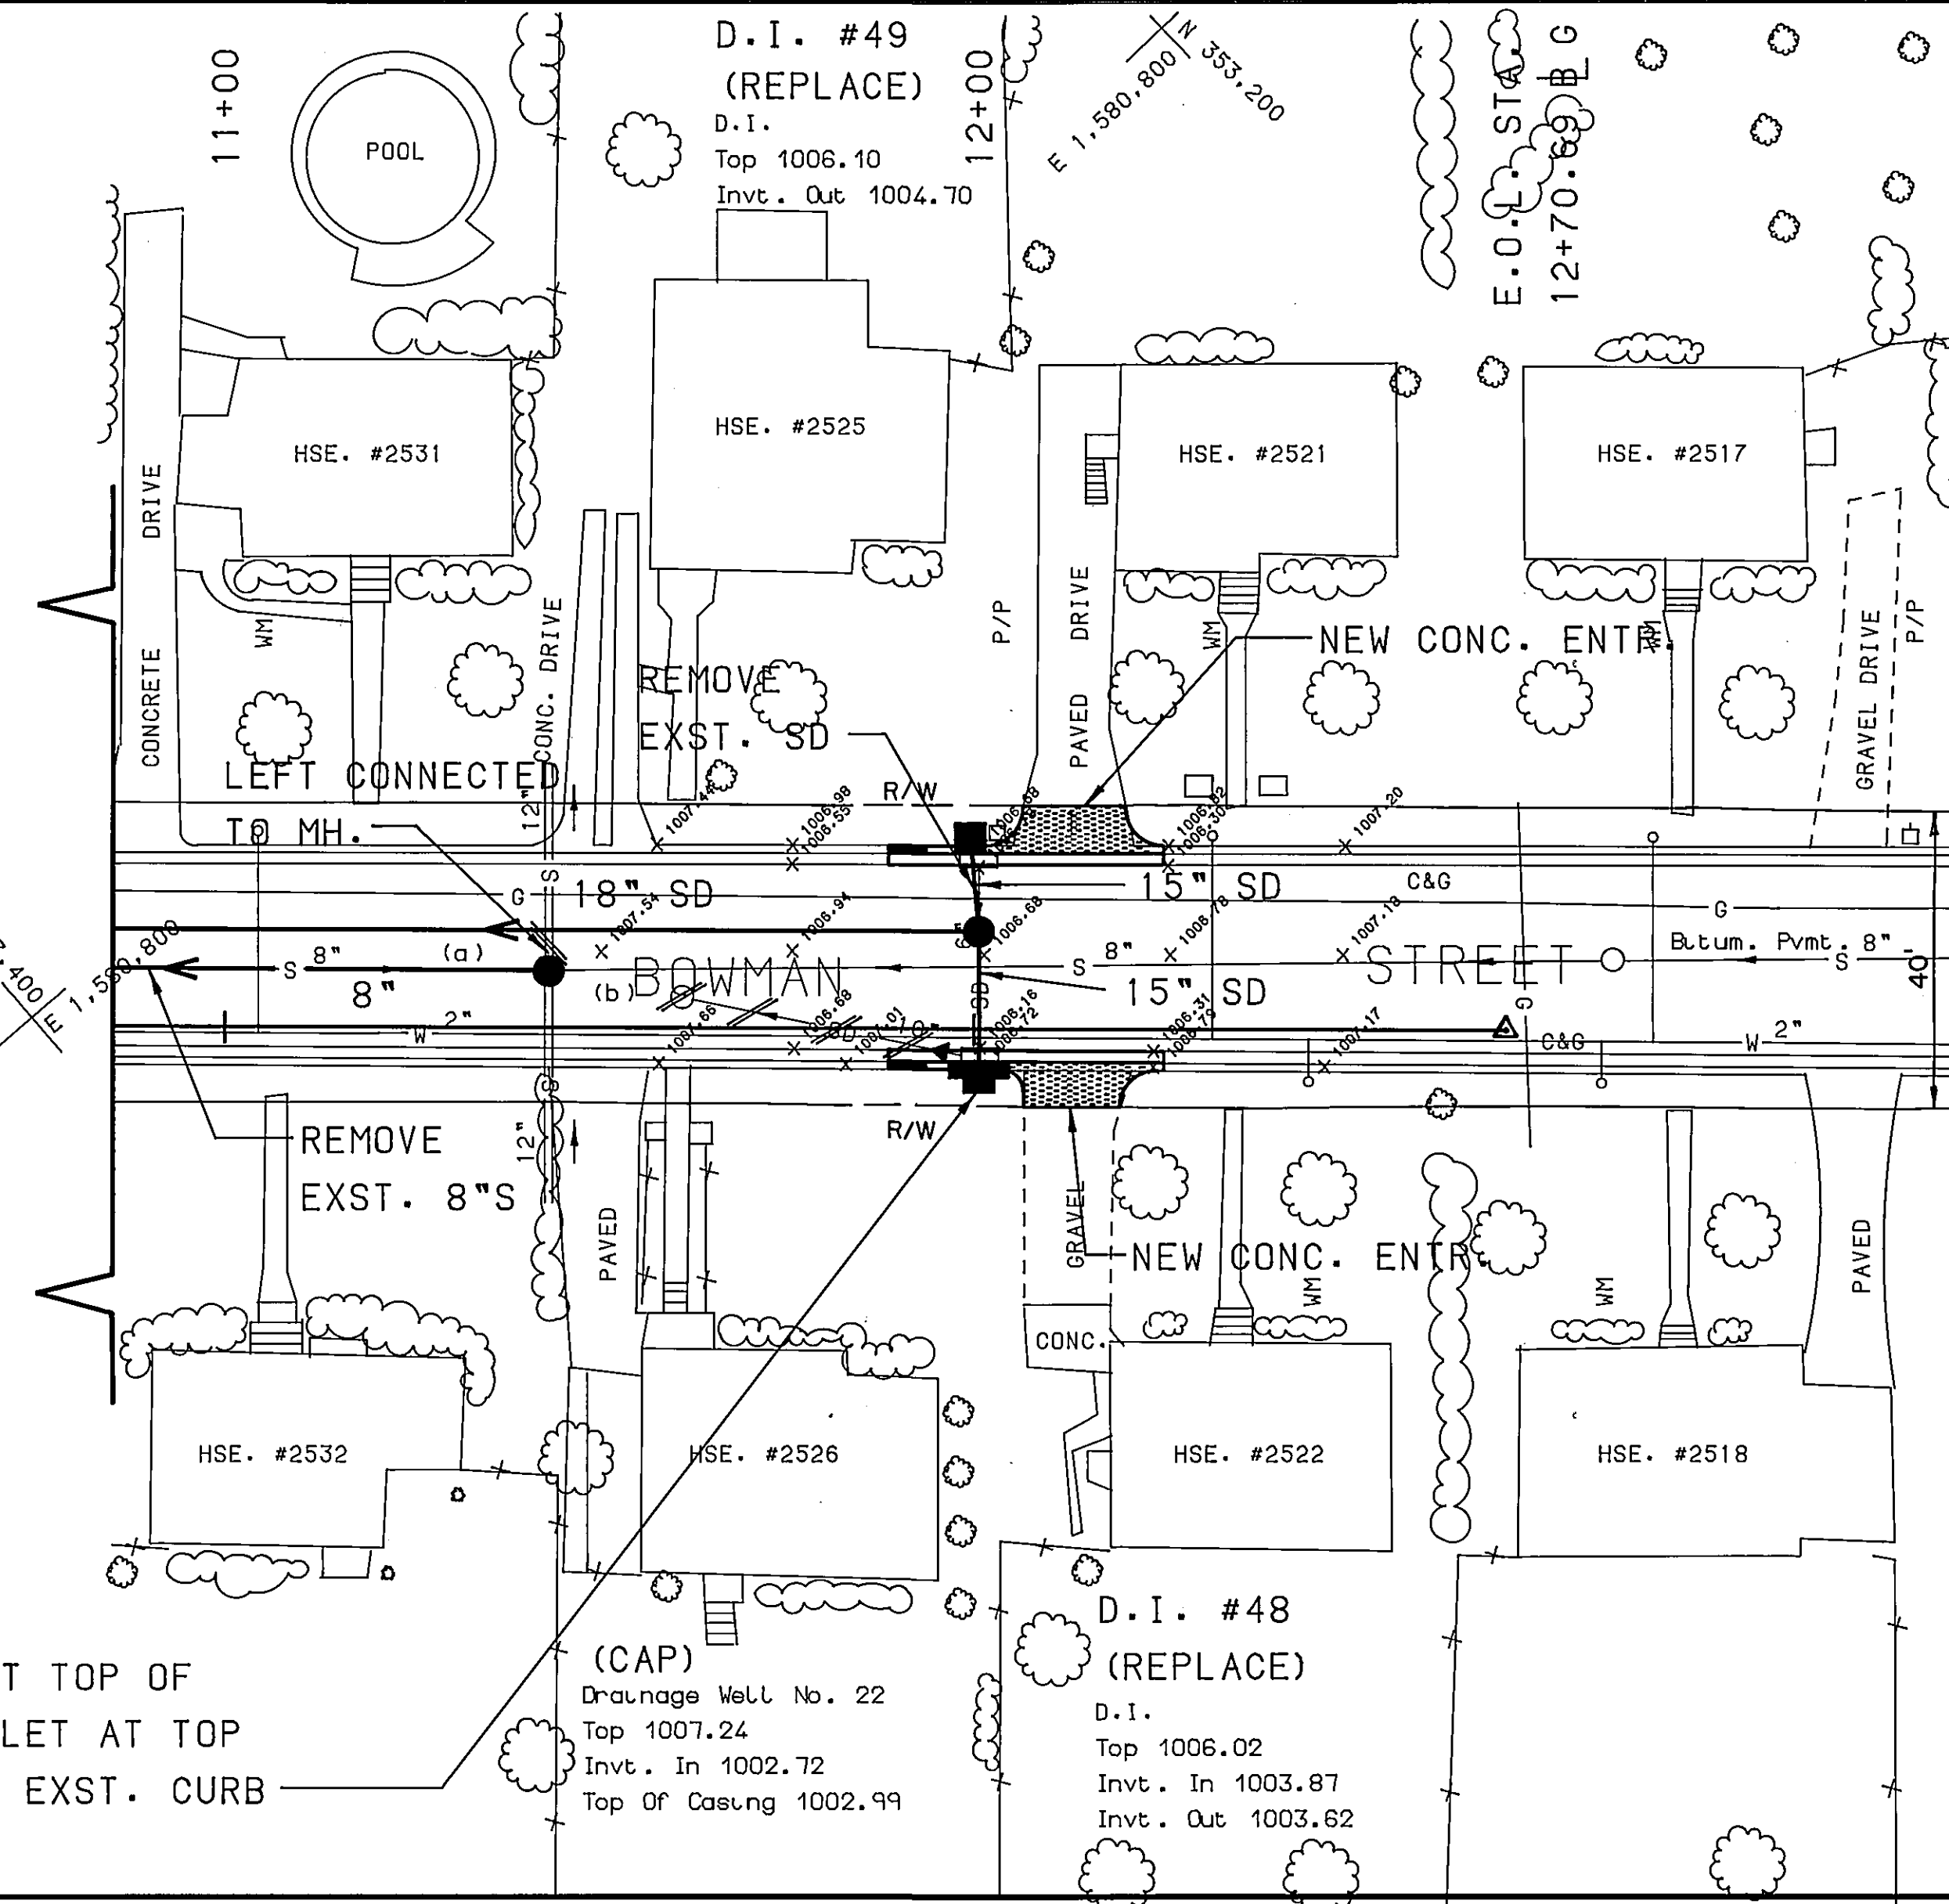


San. MH.
Top 1008.44
Invt. In 1001.24
Invt. Out 1001.21

MH. #47
STA. 12+01,
13' LT. G

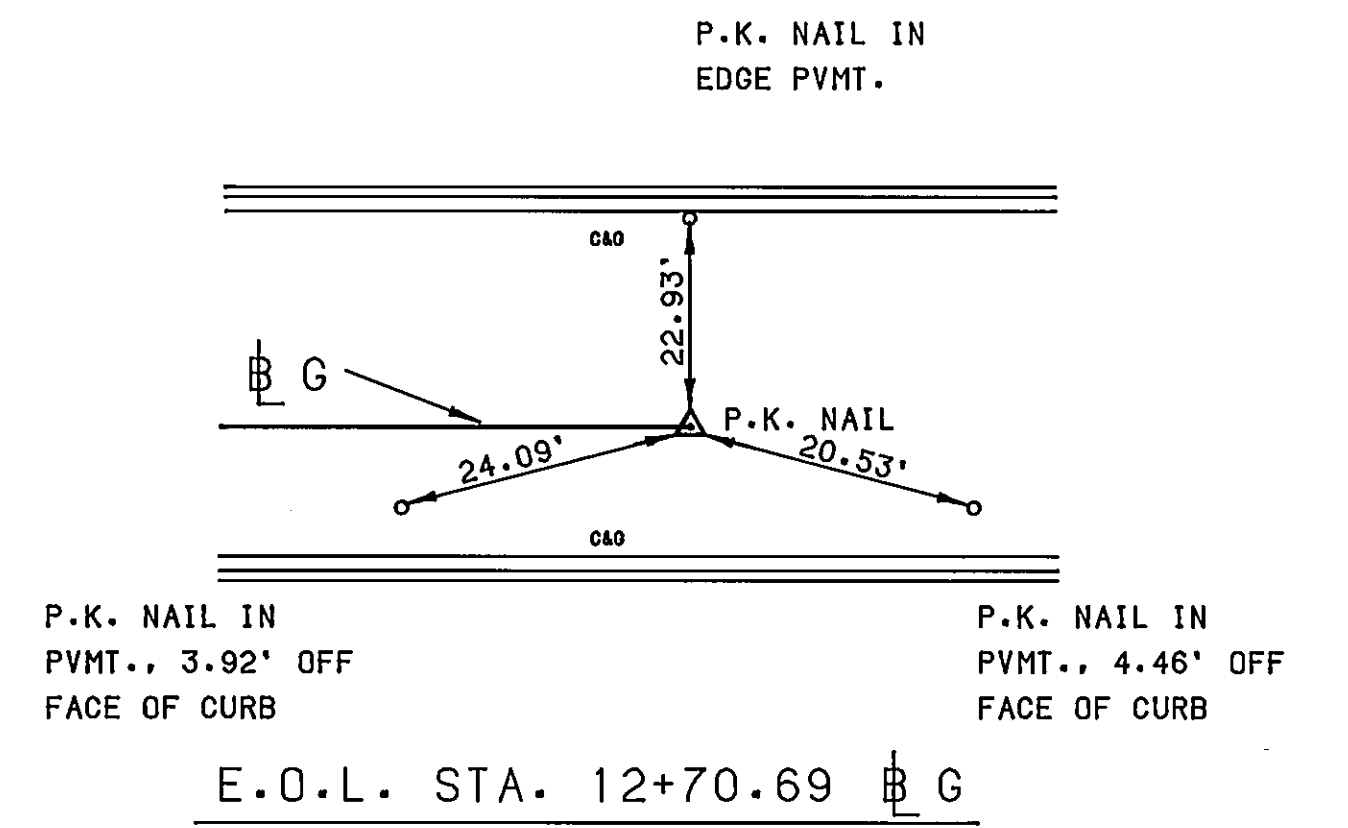

SET TOP OF
INLET AT TOP
OF EXST. CURB

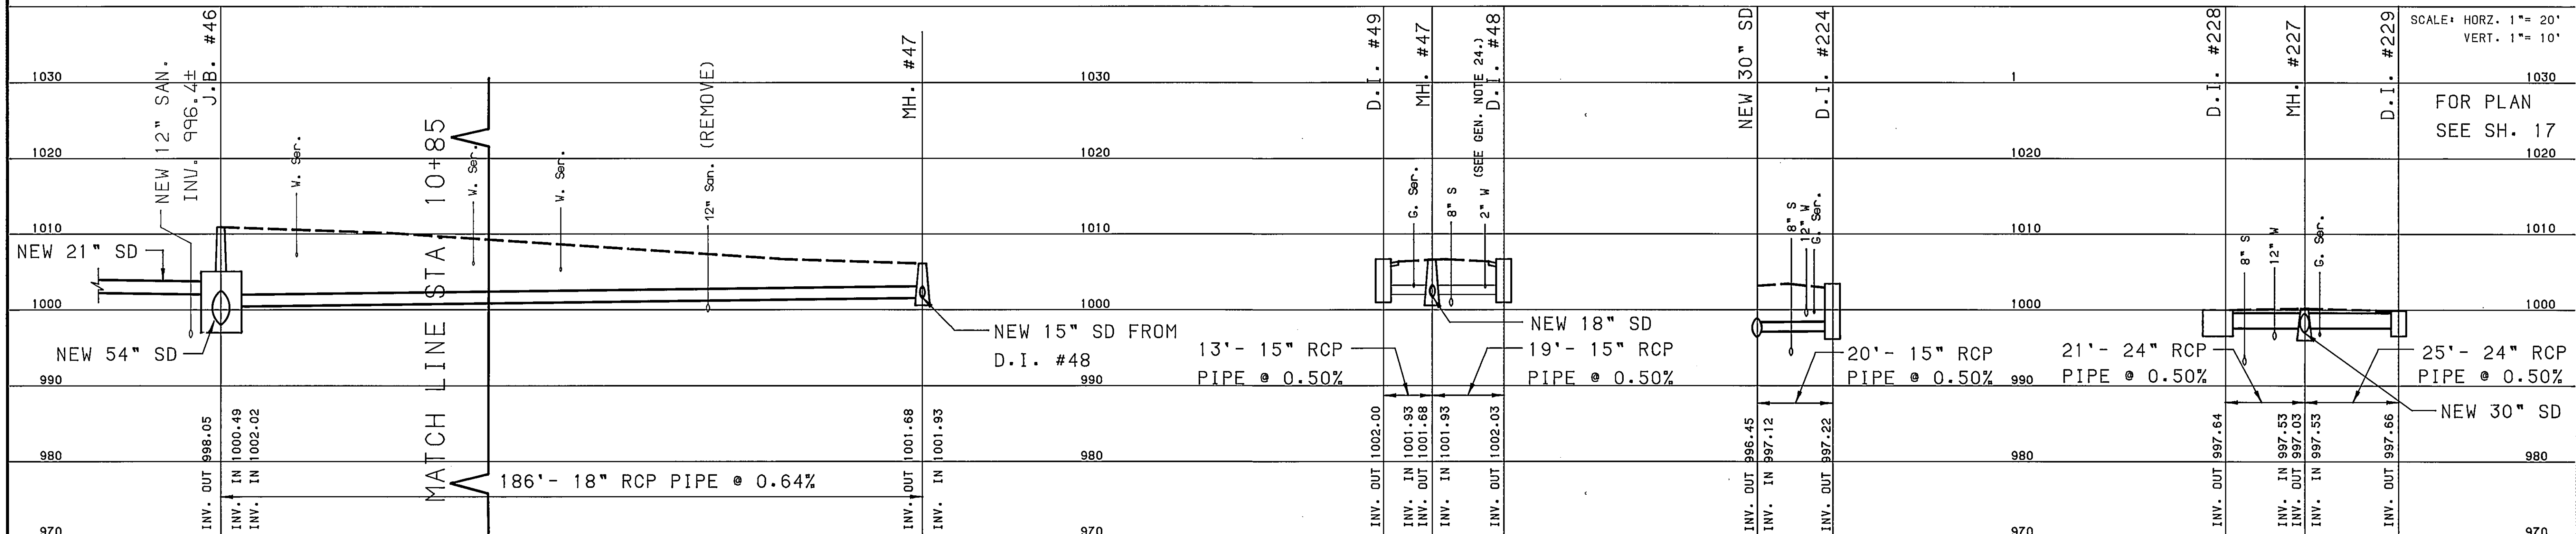

701 FIRST STREET, ROANOKE, VIRGINIA 24016. (703) 345-0342	DESIGNED:	ARB/SWH			REVISION	DATE	DESCRIPTION	BY	APP.	DATE JULY 1987 COMM. 580/581	WILLIAMSON ROAD STORM DRAIN- PHASE 2 CONTRACT II-A ROANOKE, VIRGINIA PLAN AND PROFILE	SHEET 33
	CHECKED:	GRN			1	DEC. 89	RECORD DRAWING	JLJ	SWH			
	APPROVED:											