
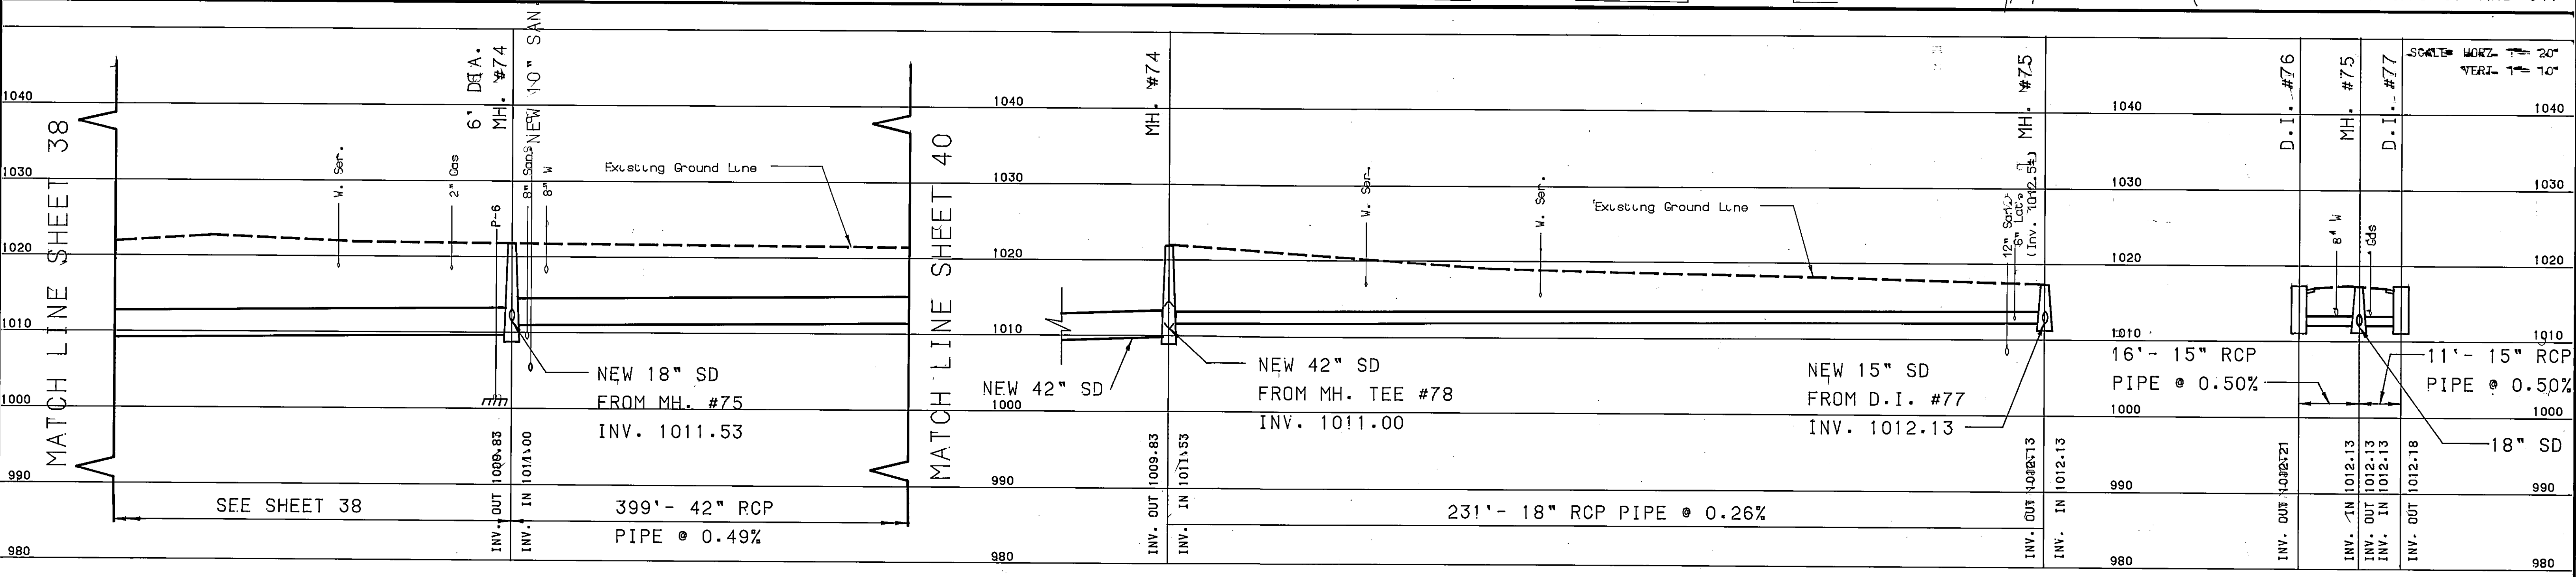
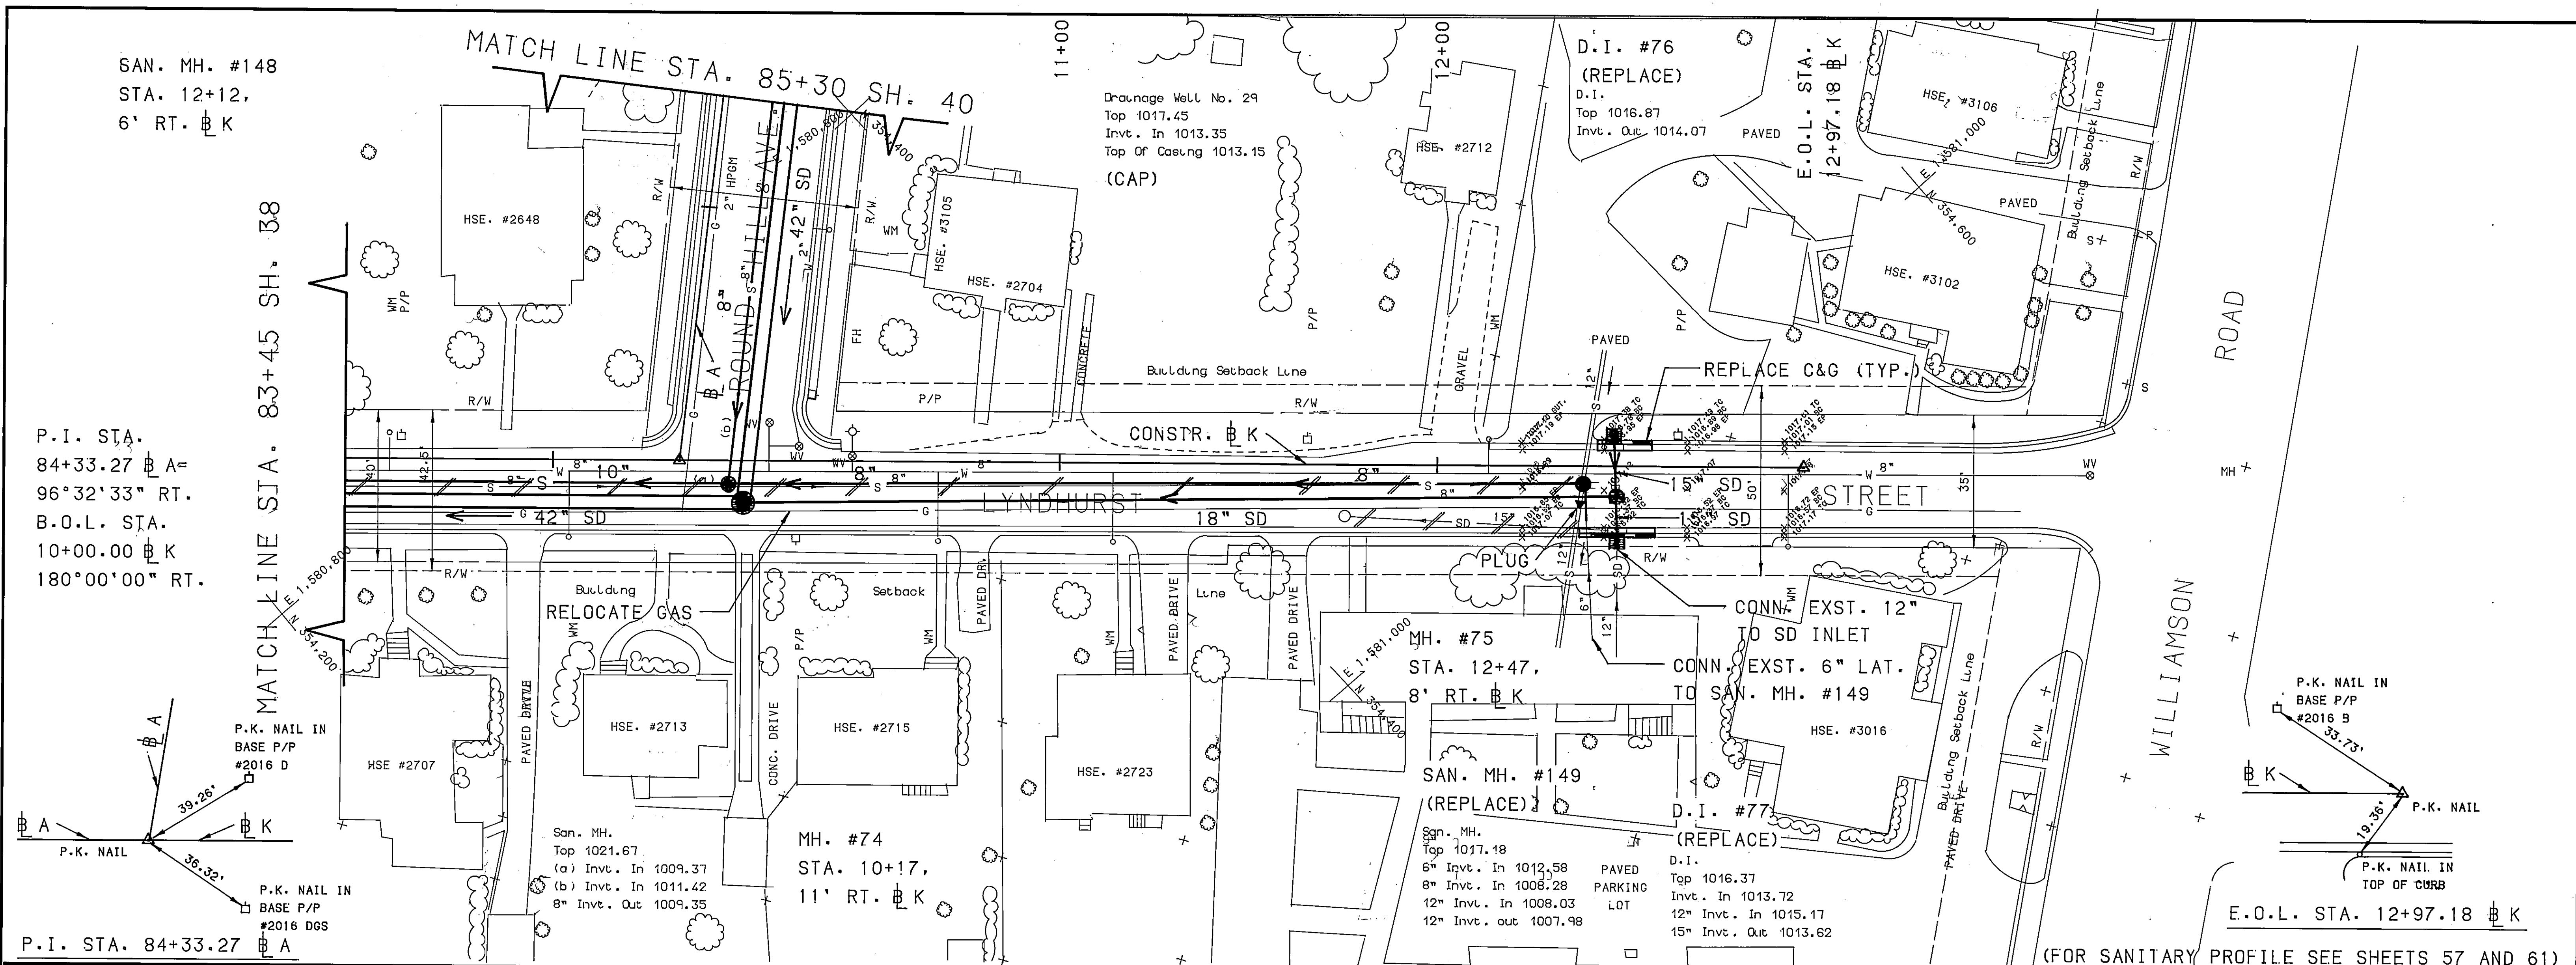
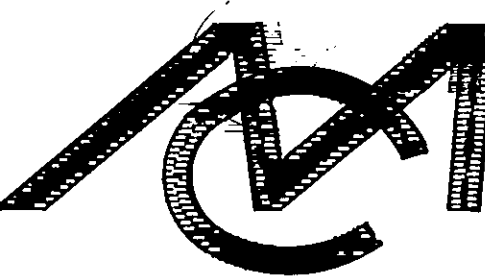


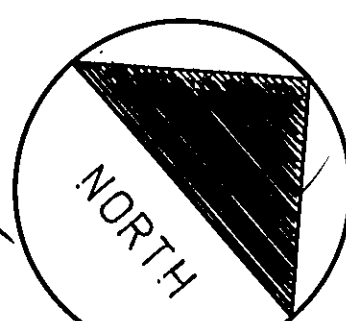

 Mattern & Craig CORPORATE ENGINEERS & SURVEYORS 701 FIRST STREET, ROANOKE, VIRGINIA 24010, (703) 345-8342	DESIGNED:	ARB/SWH			REVISION	DATE	DESCRIPTION	BY	APP.	DATE	WILLIAMSON ROAD STORM DRAIN- PHASE 2 CONTRACT II-A ROANOKE, VIRGINIA	SHEET 39
	CHECKED:	GRN			1	DEC. 89	RECORD DRAWING	JLJ	SWH	JULY 1987		
	APPROVED:									580/581		
	PLAN AND PROFILE											