


P.O.T. STA. 92+97.17 Δ A =
180°00'00" RT.
B.O.L. STA. 10+00.00 Δ O
269°55'15" RT.

P.O.T. STA. 95+21.27 Δ A =
180°00'00" RT.
B.O.L. STA. 10+00.00 Δ P =
264°15'45" RT.
B.O.L. STA. 10+00.00 Δ Q
85°07'46" RT.


MATCH LINE STA. 91+40 SH. 40

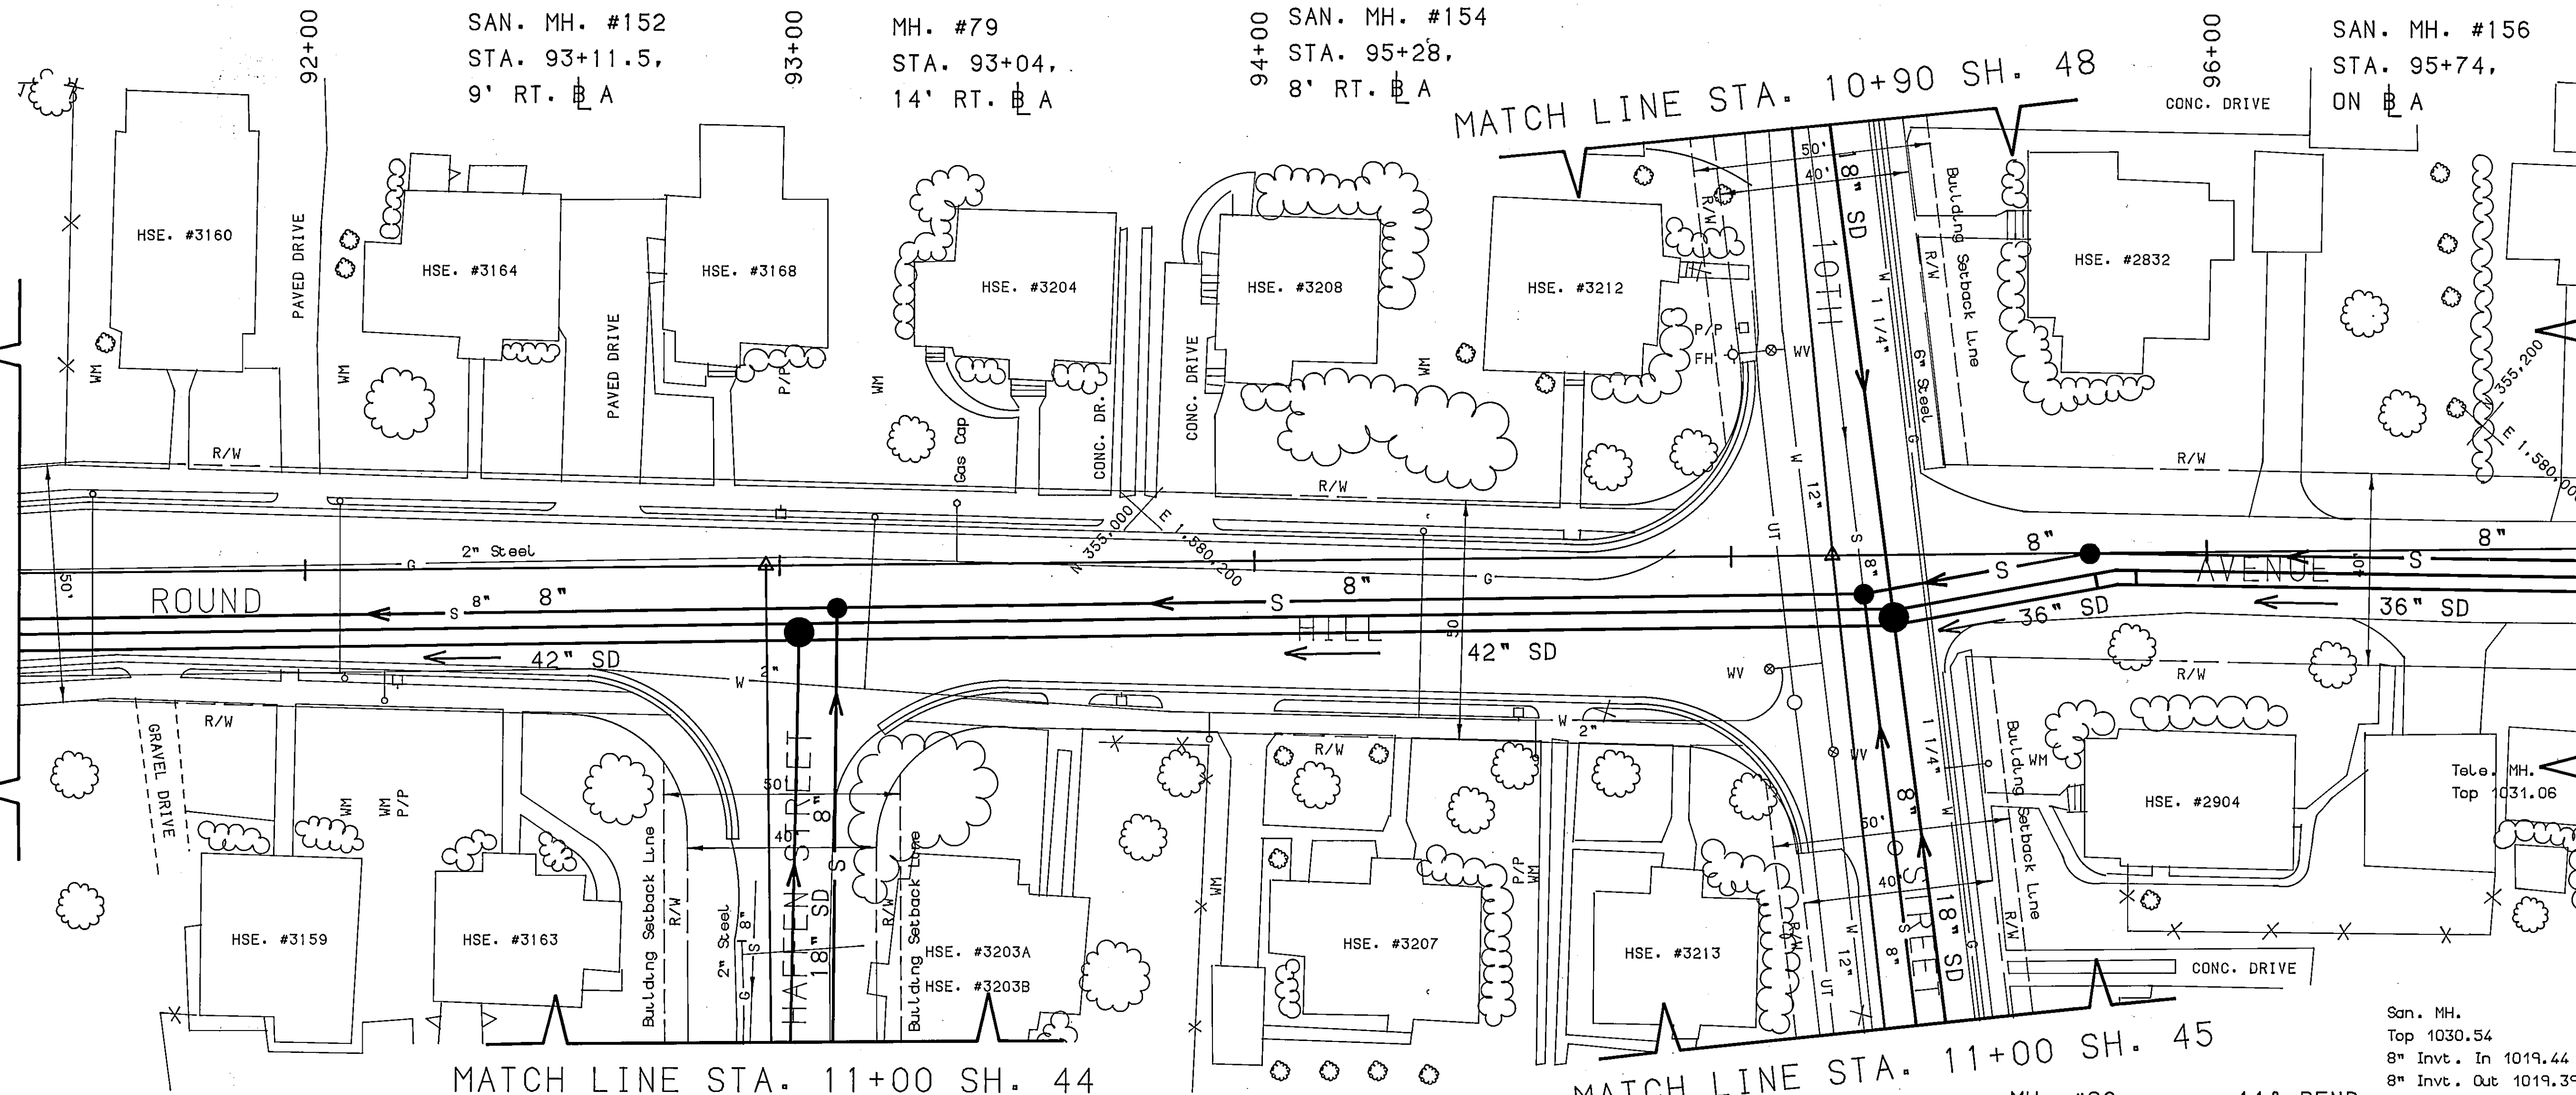

MATCH LINE STA. 11+00 SH. 44

MATCH LINE STA. 11+00 SH. 45
MH. #80 11° BEND
STA. 95+34, STA. 95+81,
13' RT. Δ A 5' RT. Δ A

(FOR SANITARY PROFILE SEE SHEET 59)

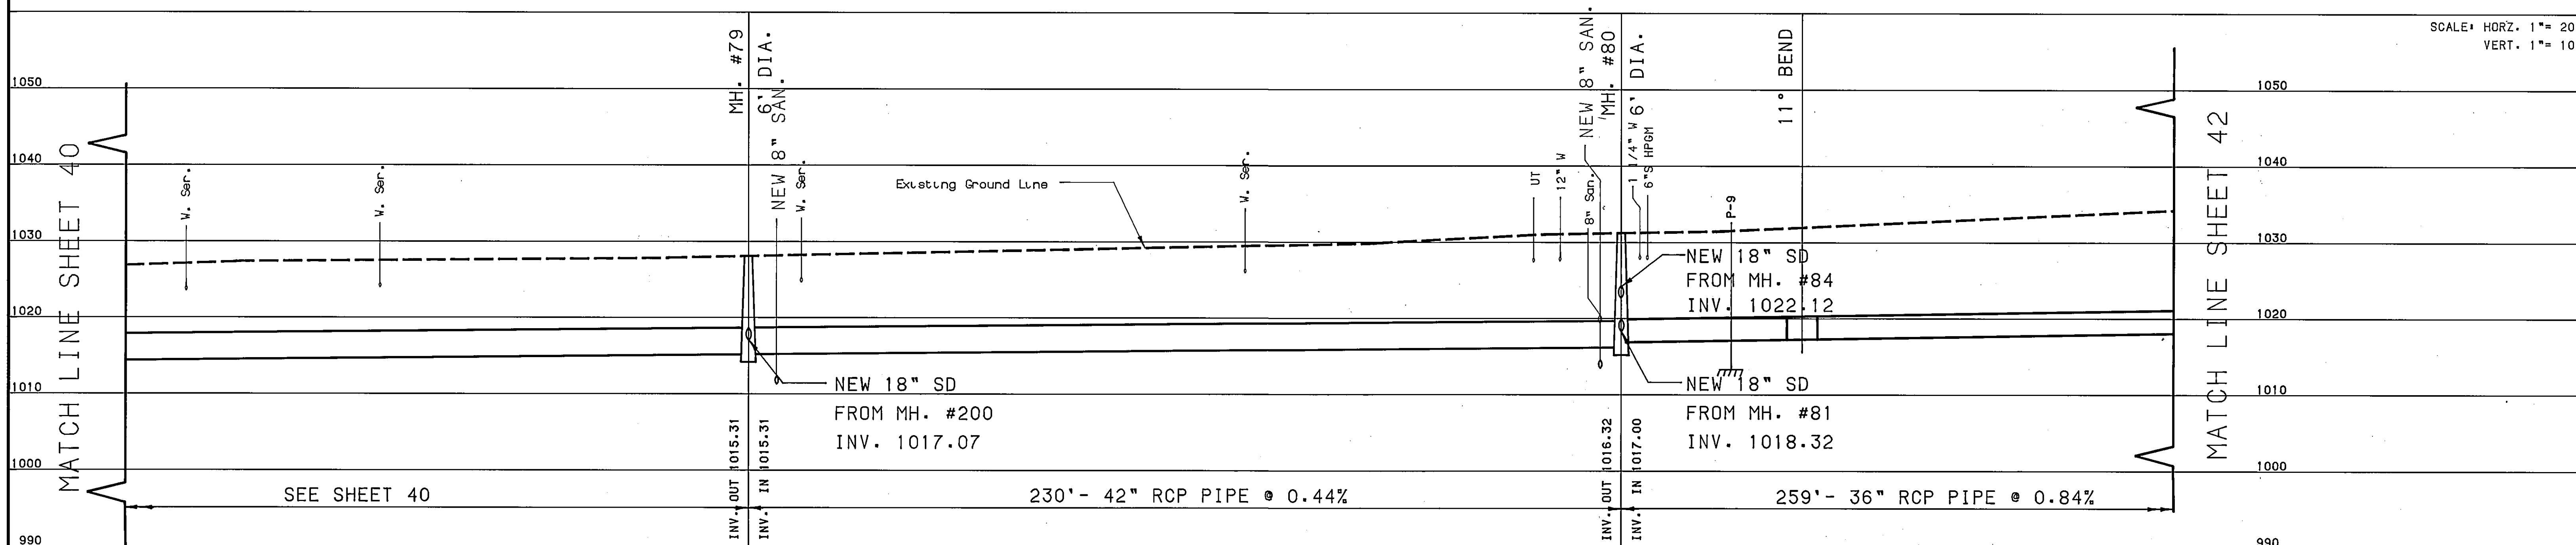

 Mattern & Craig CONSULTING ENGINEERS - SURVEYORS 701 FIRST STREET, ROANOKE, VIRGINIA 24016, (703) 345-9342	DESIGNED:	ARB/SWH			REVISION	DATE	DESCRIPTION	BY	APP.	DATE JULY 1987 COMM. 580/581	WILLIAMSON ROAD STORM DRAIN- PHASE 2 CONTRACT 11-A ROANOKE, VIRGINIA	SHEET 41
	CHECKED:	GRN			1	DEC. 89	RECORD DRAWING	JLJ	SWH			
	APPROVED:											
	PLAN AND PROFILE											