
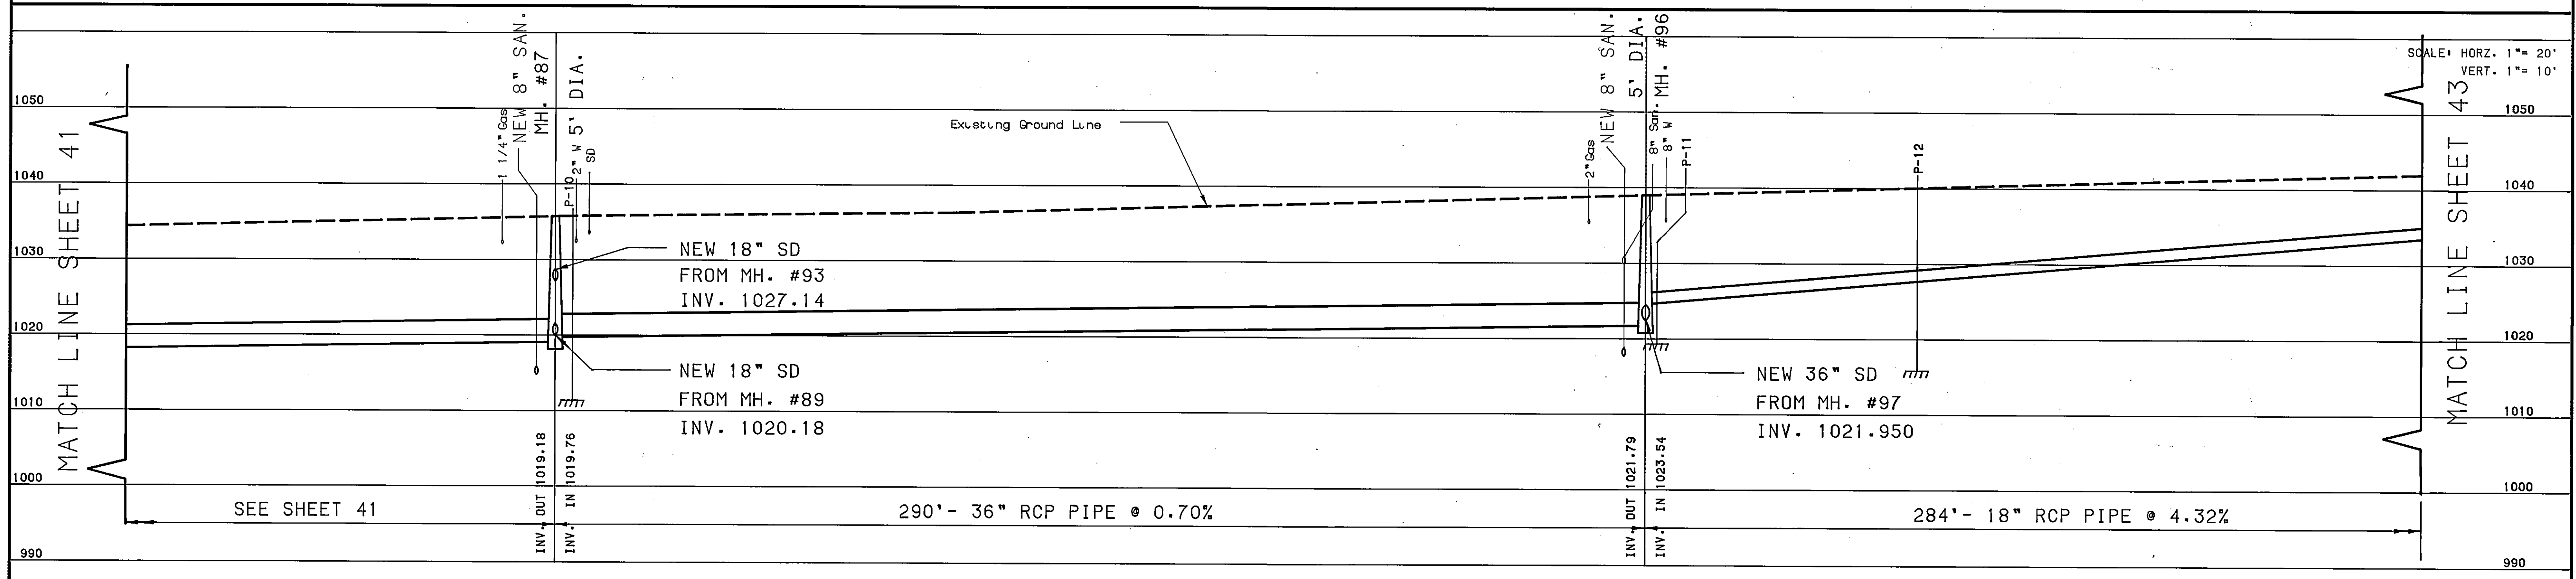


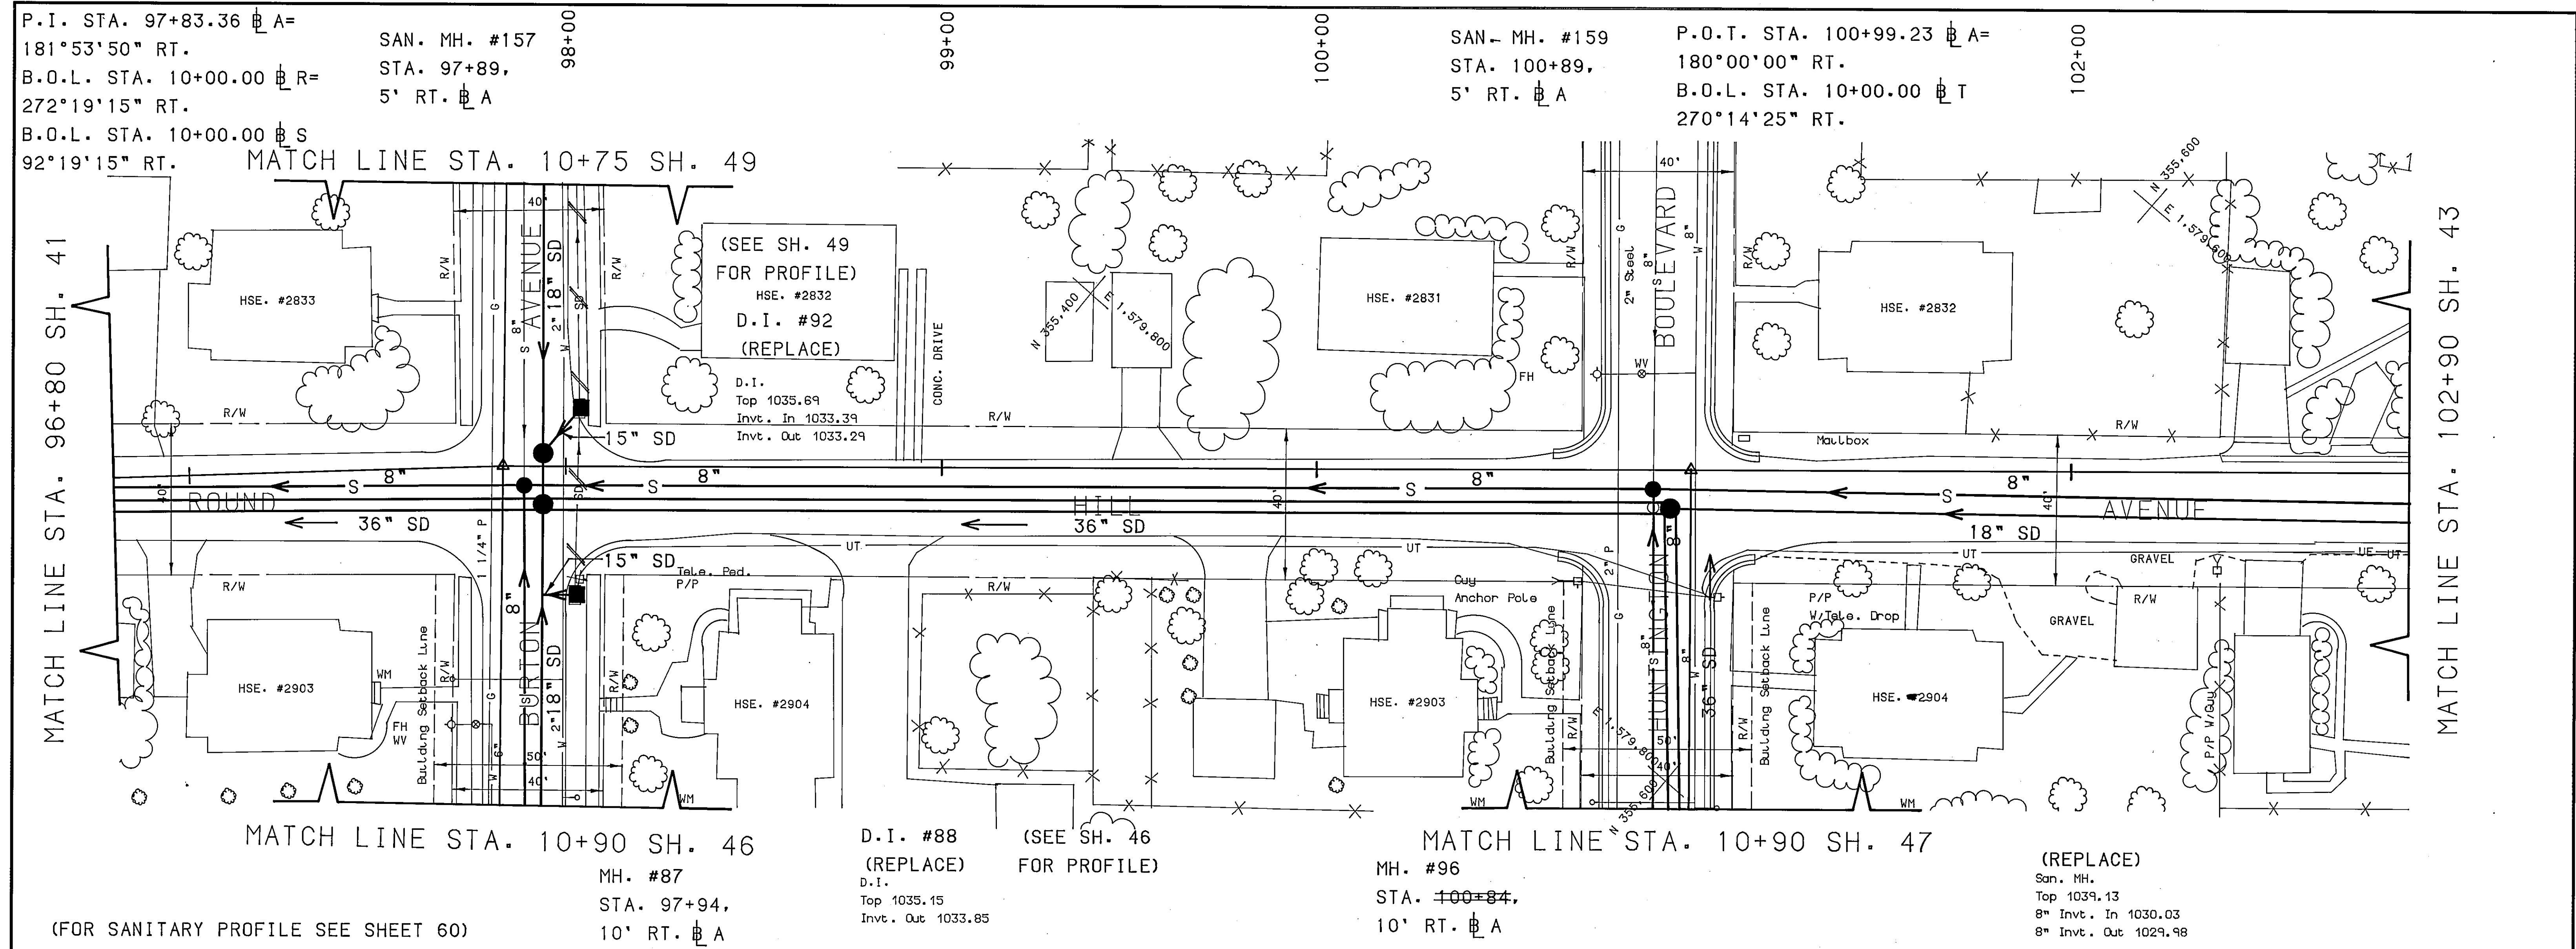

 Mattern & Craig CONSULTING ENGINEERS - SURVEYORS 701 FIRST STREET, ROANOKE, VIRGINIA 24016, (703) 345-9342	DESIGNED: ARB/SWH			REVISION	DATE	DESCRIPTION	BY	APP.	DATE	WILLIAMSON ROAD STORM DRAIN- PHASE 2 CONTRACT II-A ROANOKE, VIRGINIA	SHEET 42
	CHECKED: GRN			1	DEC. 89	RECORD DRAWING	JLJ	SWH	JULY 1987		
	APPROVED:								580/581		
	PLAN AND PROFILE										