
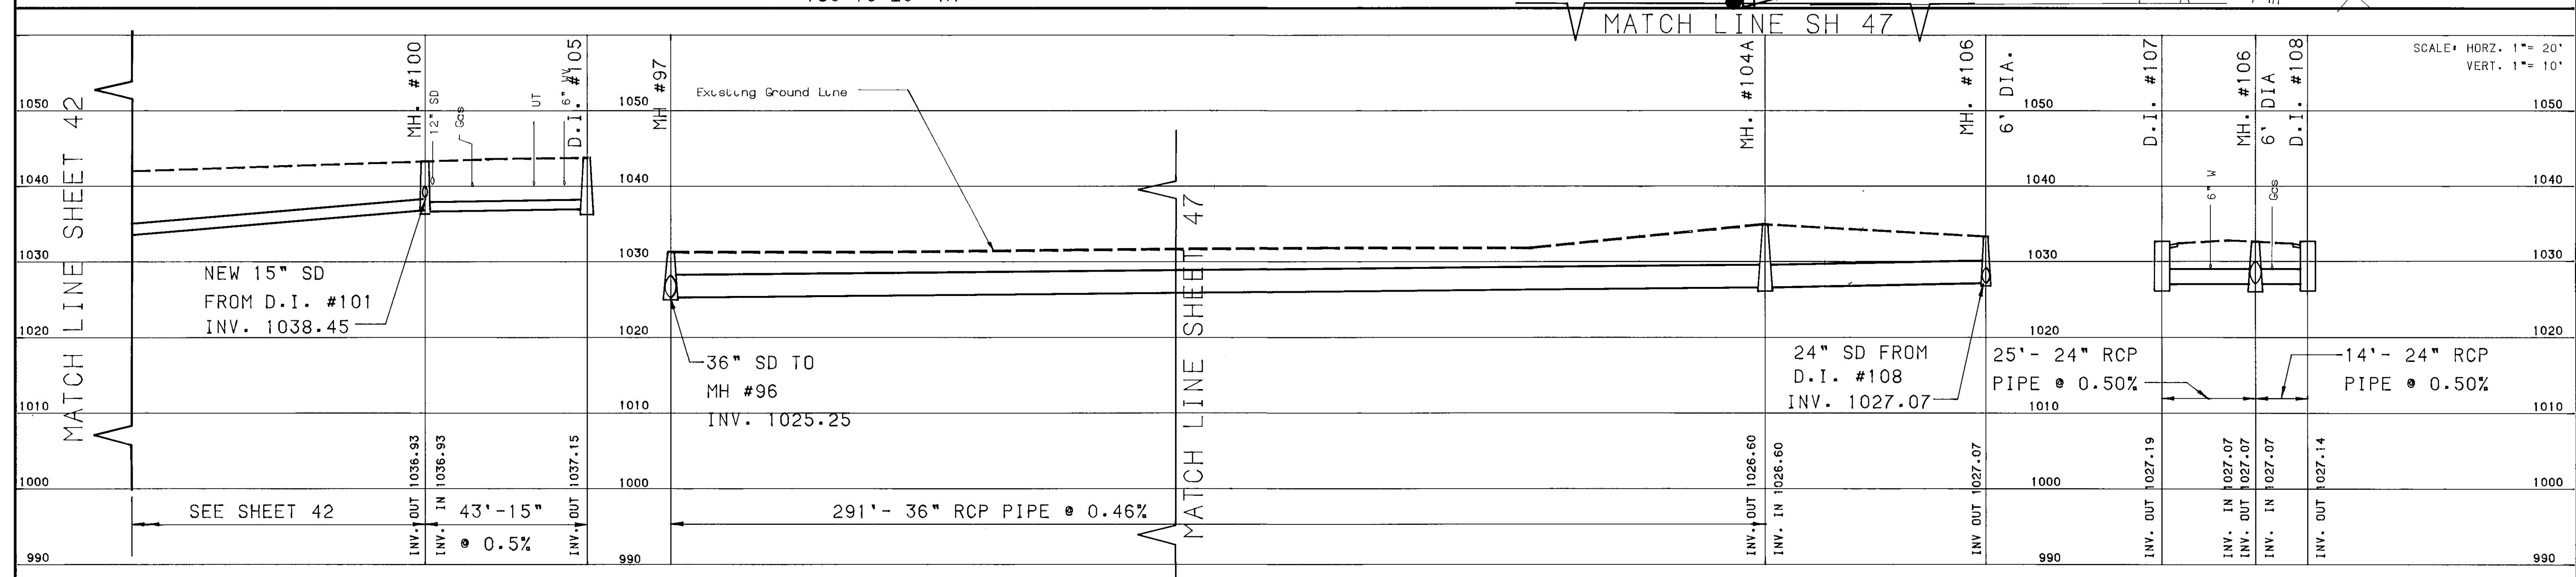


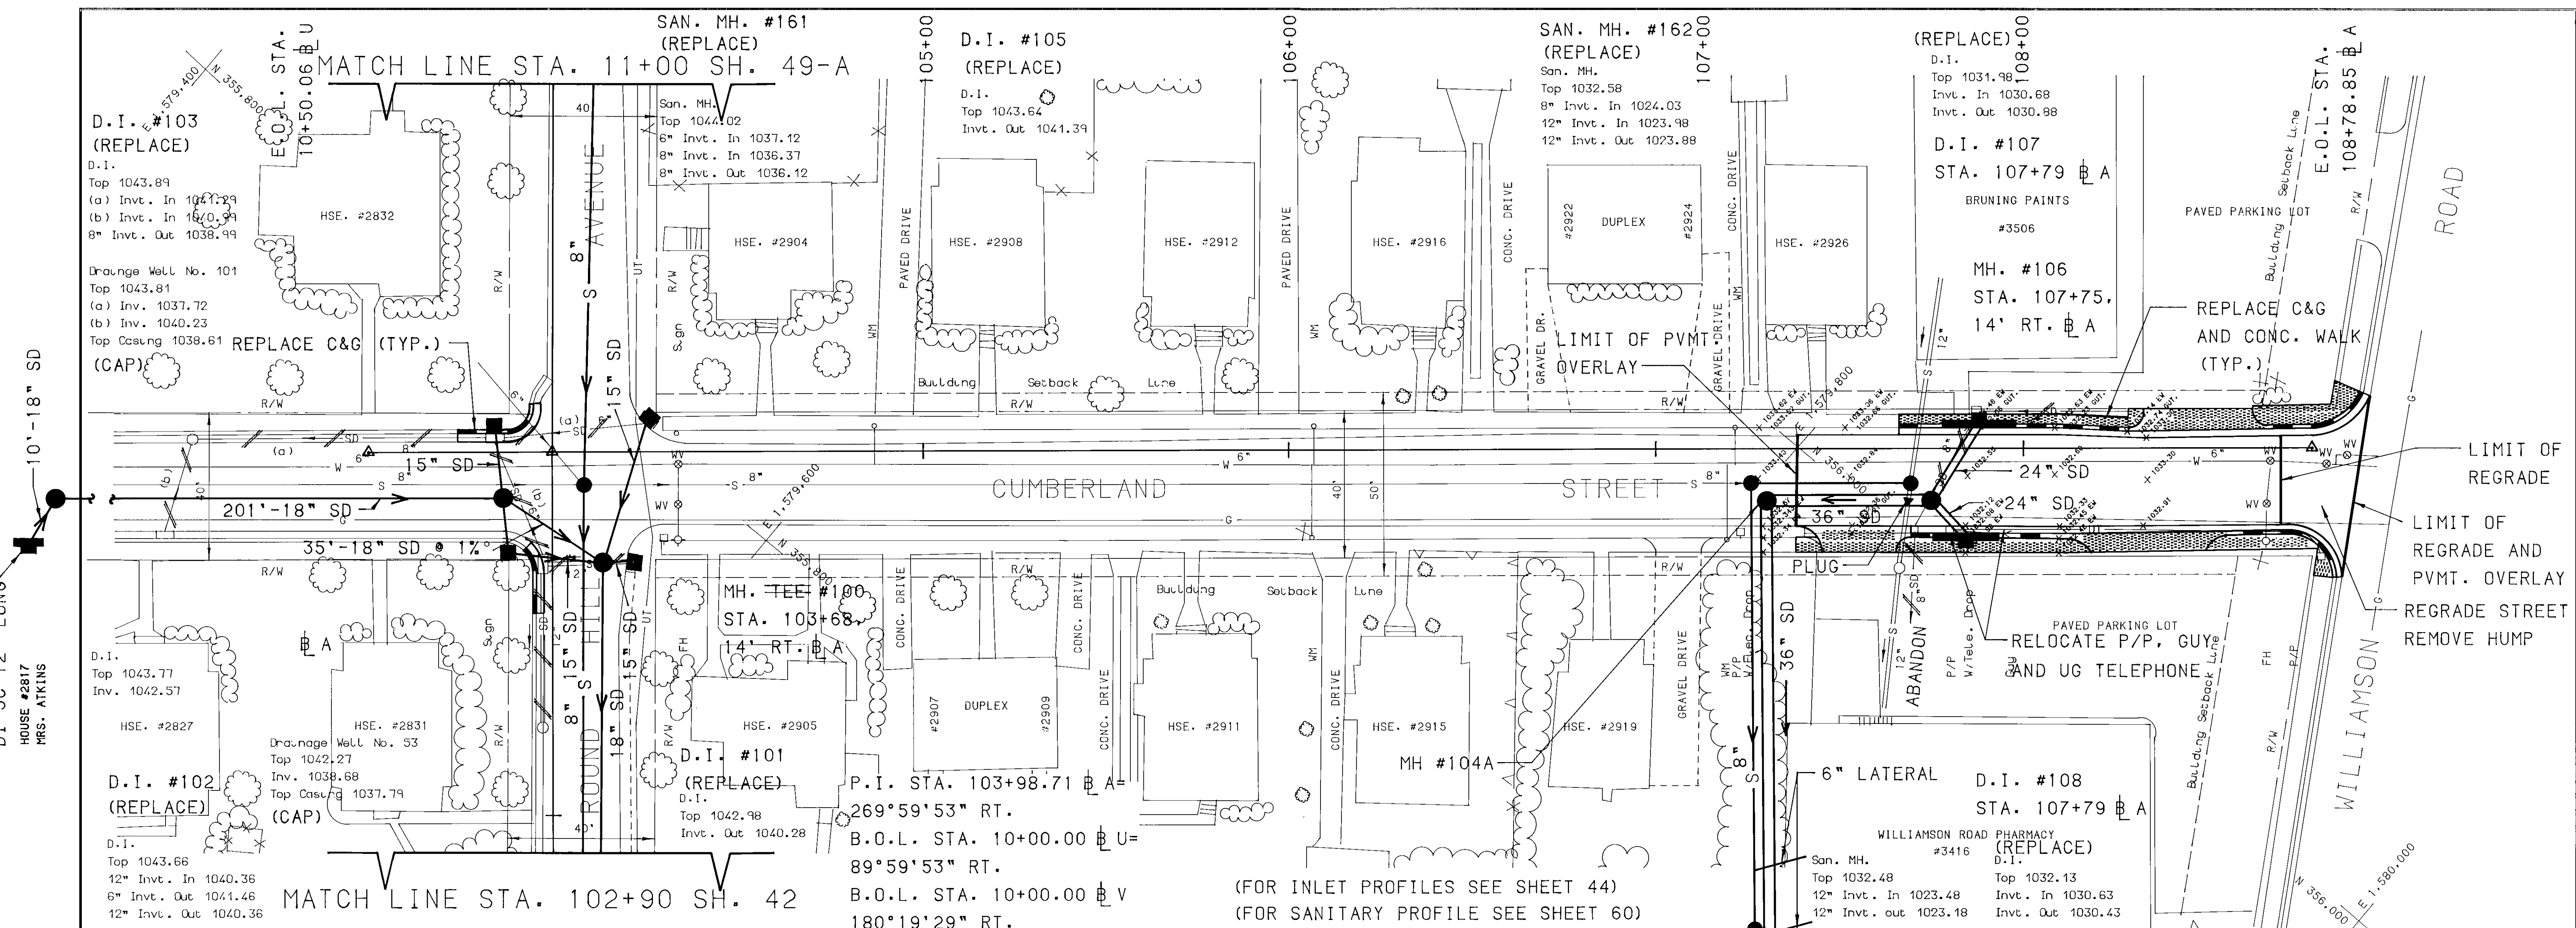

Mattern & Craig CONSULTING ENGINEERS - SURVEYORS 701 FIRST STREET, ROANOKE, VIRGINIA 24016 (703) 349-8342	DESIGNED*	ARB/SWH			REVISION	DATE	DESCRIPTION	BY	APP.	DATE	WILLIAMSON ROAD STORM DRAIN- PHASE 2 CONTRACT II-A ROANOKE, VIRGINIA	SHEET 43
	CHECKED*	GRN			1	DEC. 89	RECORD DRAWING	JLJ	SWH	JULY 1987		
	APPROVED*									580/581		
	PLAN AND PROFILE											