



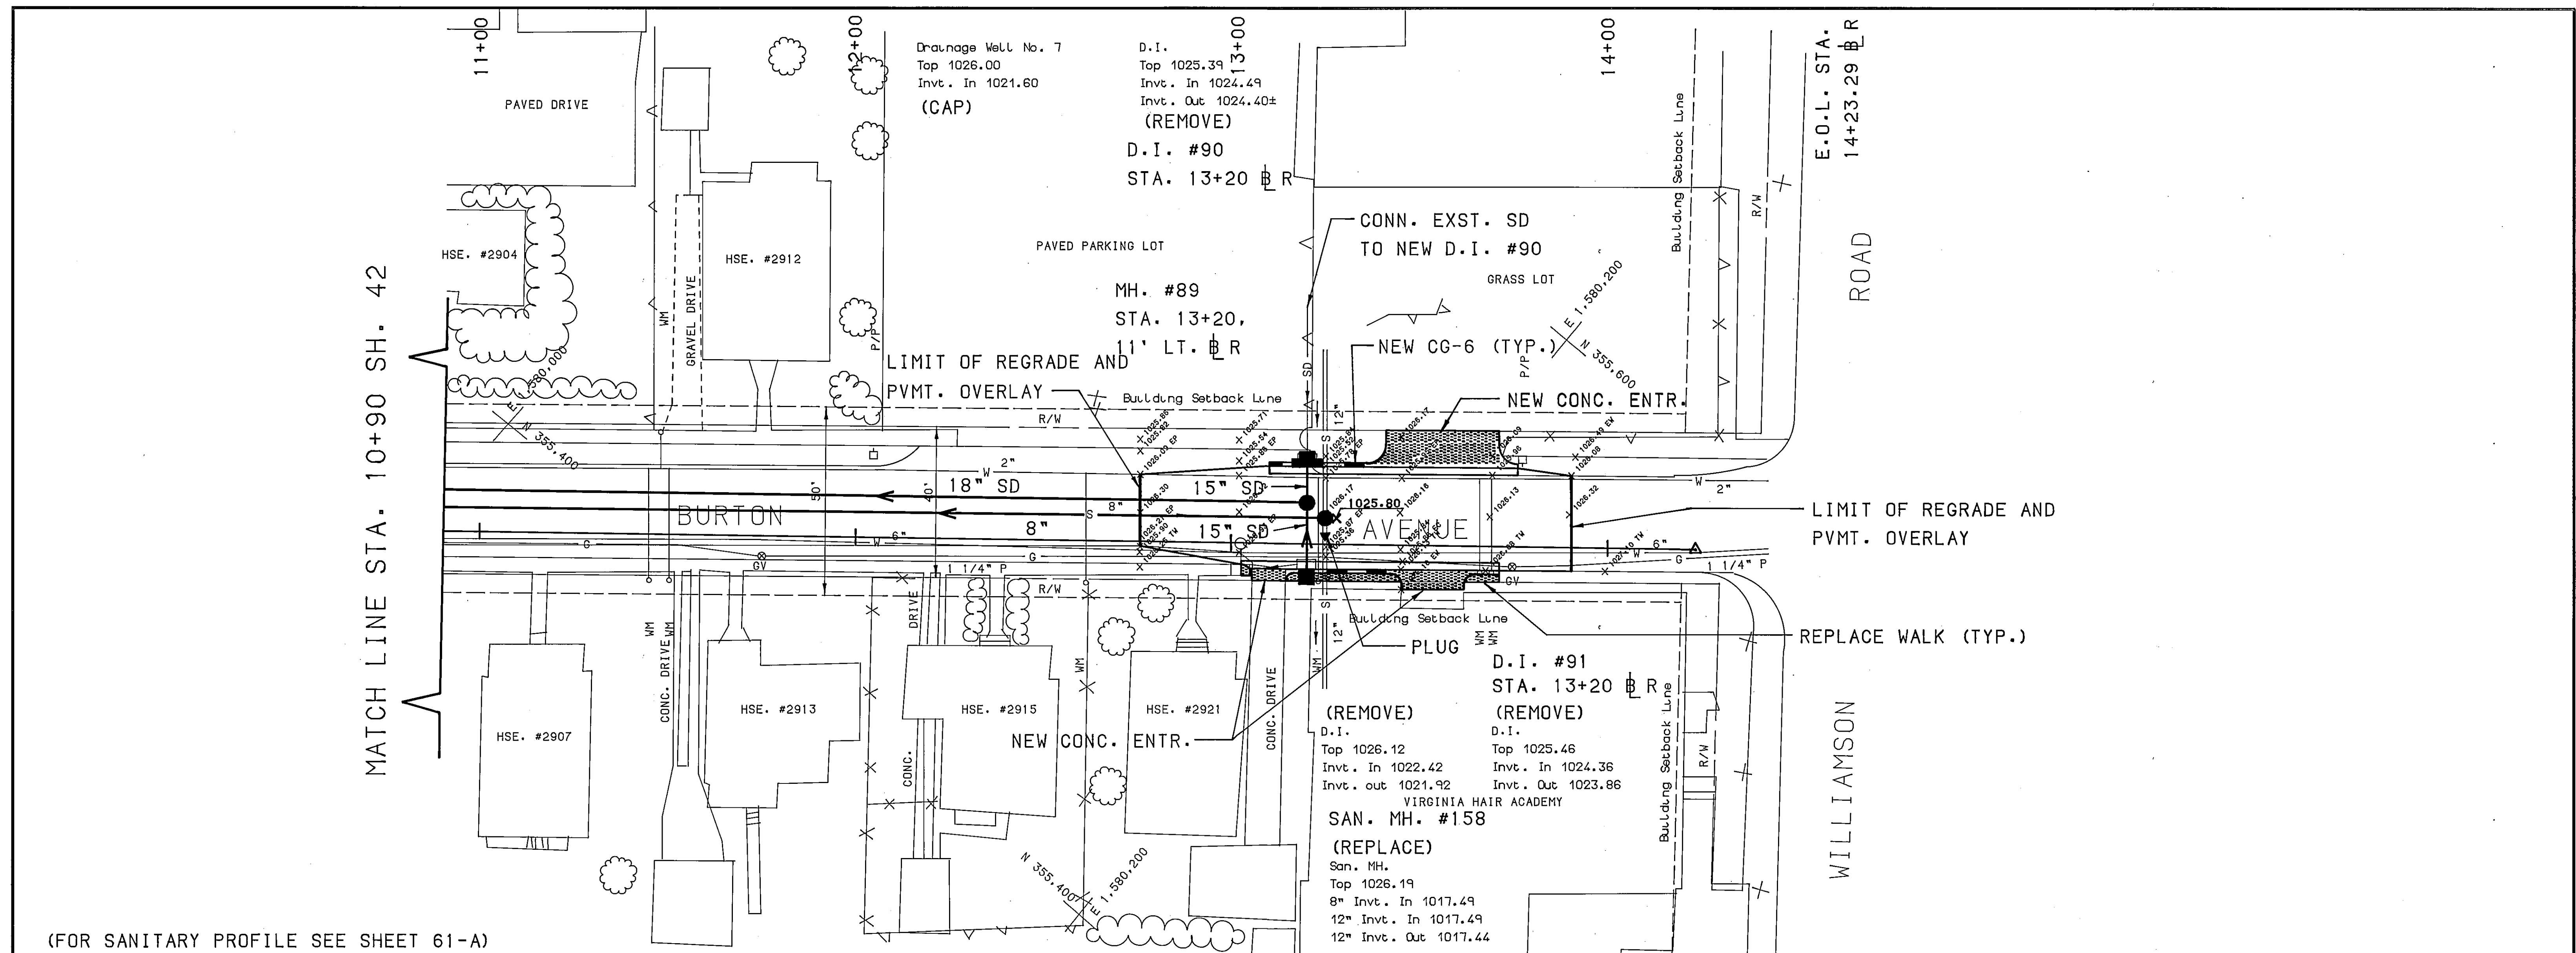

(FOR SANITARY PROFILE SEE SHEET 61-A)

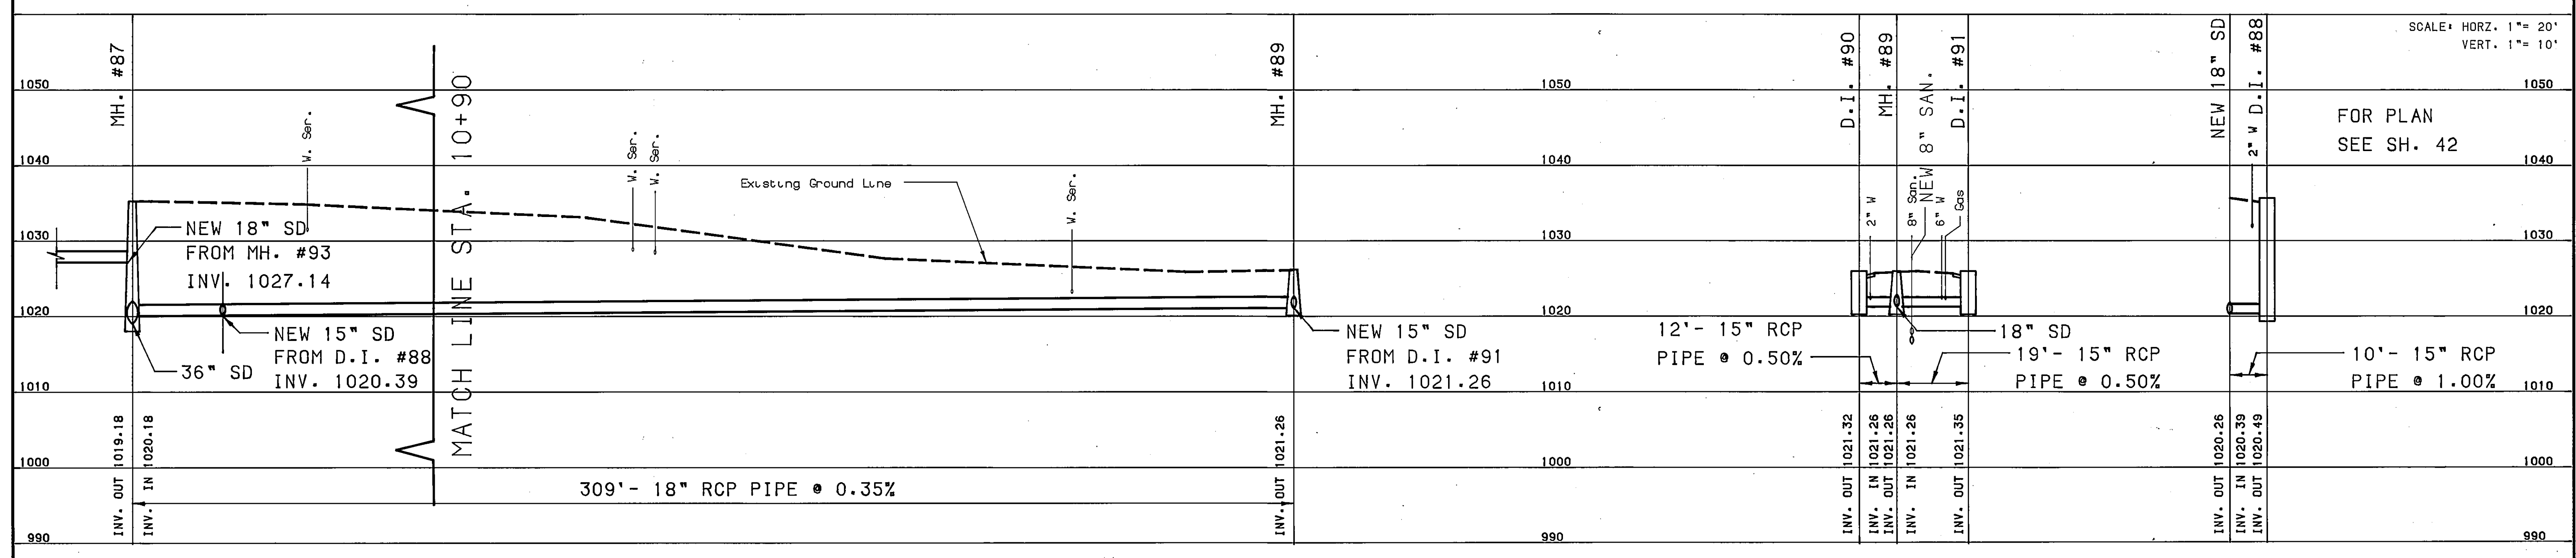

Mattern & Craig CONSULTING ENGINEERS - SURVEYORS 701 FIRST STREET, ROANOKE, VIRGINIA 24016, (703) 345-8342	DESIGNED:	ARB/SWH			REVISION	DATE	DESCRIPTION	BY	APP.	DATE JULY 1987 COMM.	WILLIAMSON ROAD STORM DRAIN- PHASE 2 CONTRACT II-A ROANOKE, VIRGINIA	SHEET 46
	CHECKED:	GRN			1	DEC. 89	RECORD DRAWING	JLJ	SWH			
	APPROVED:											
	PLAN AND PROFILE											