
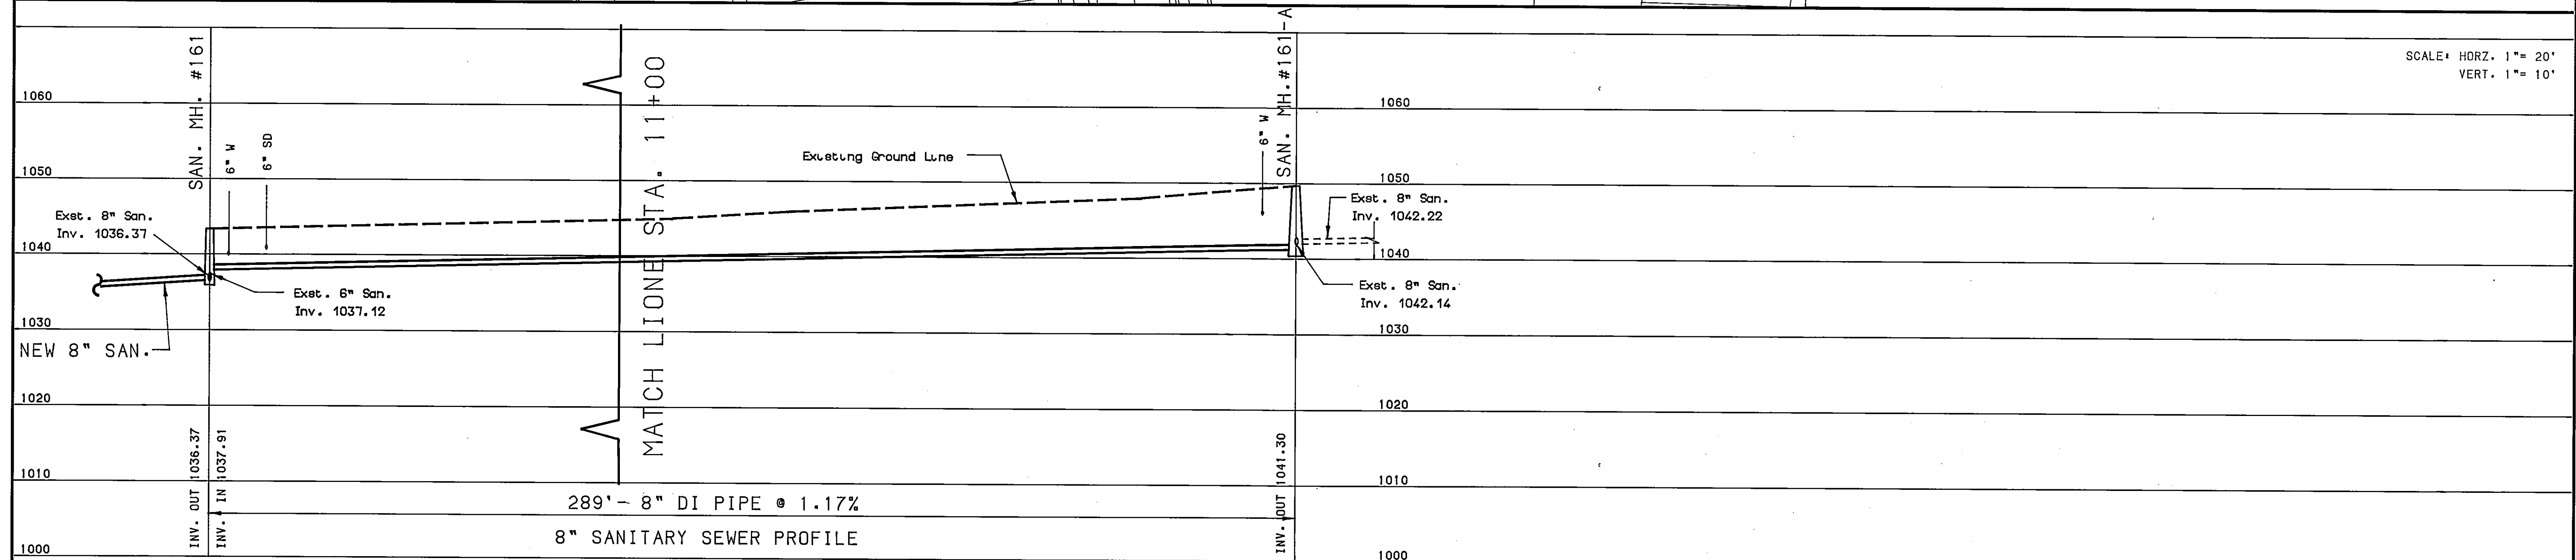
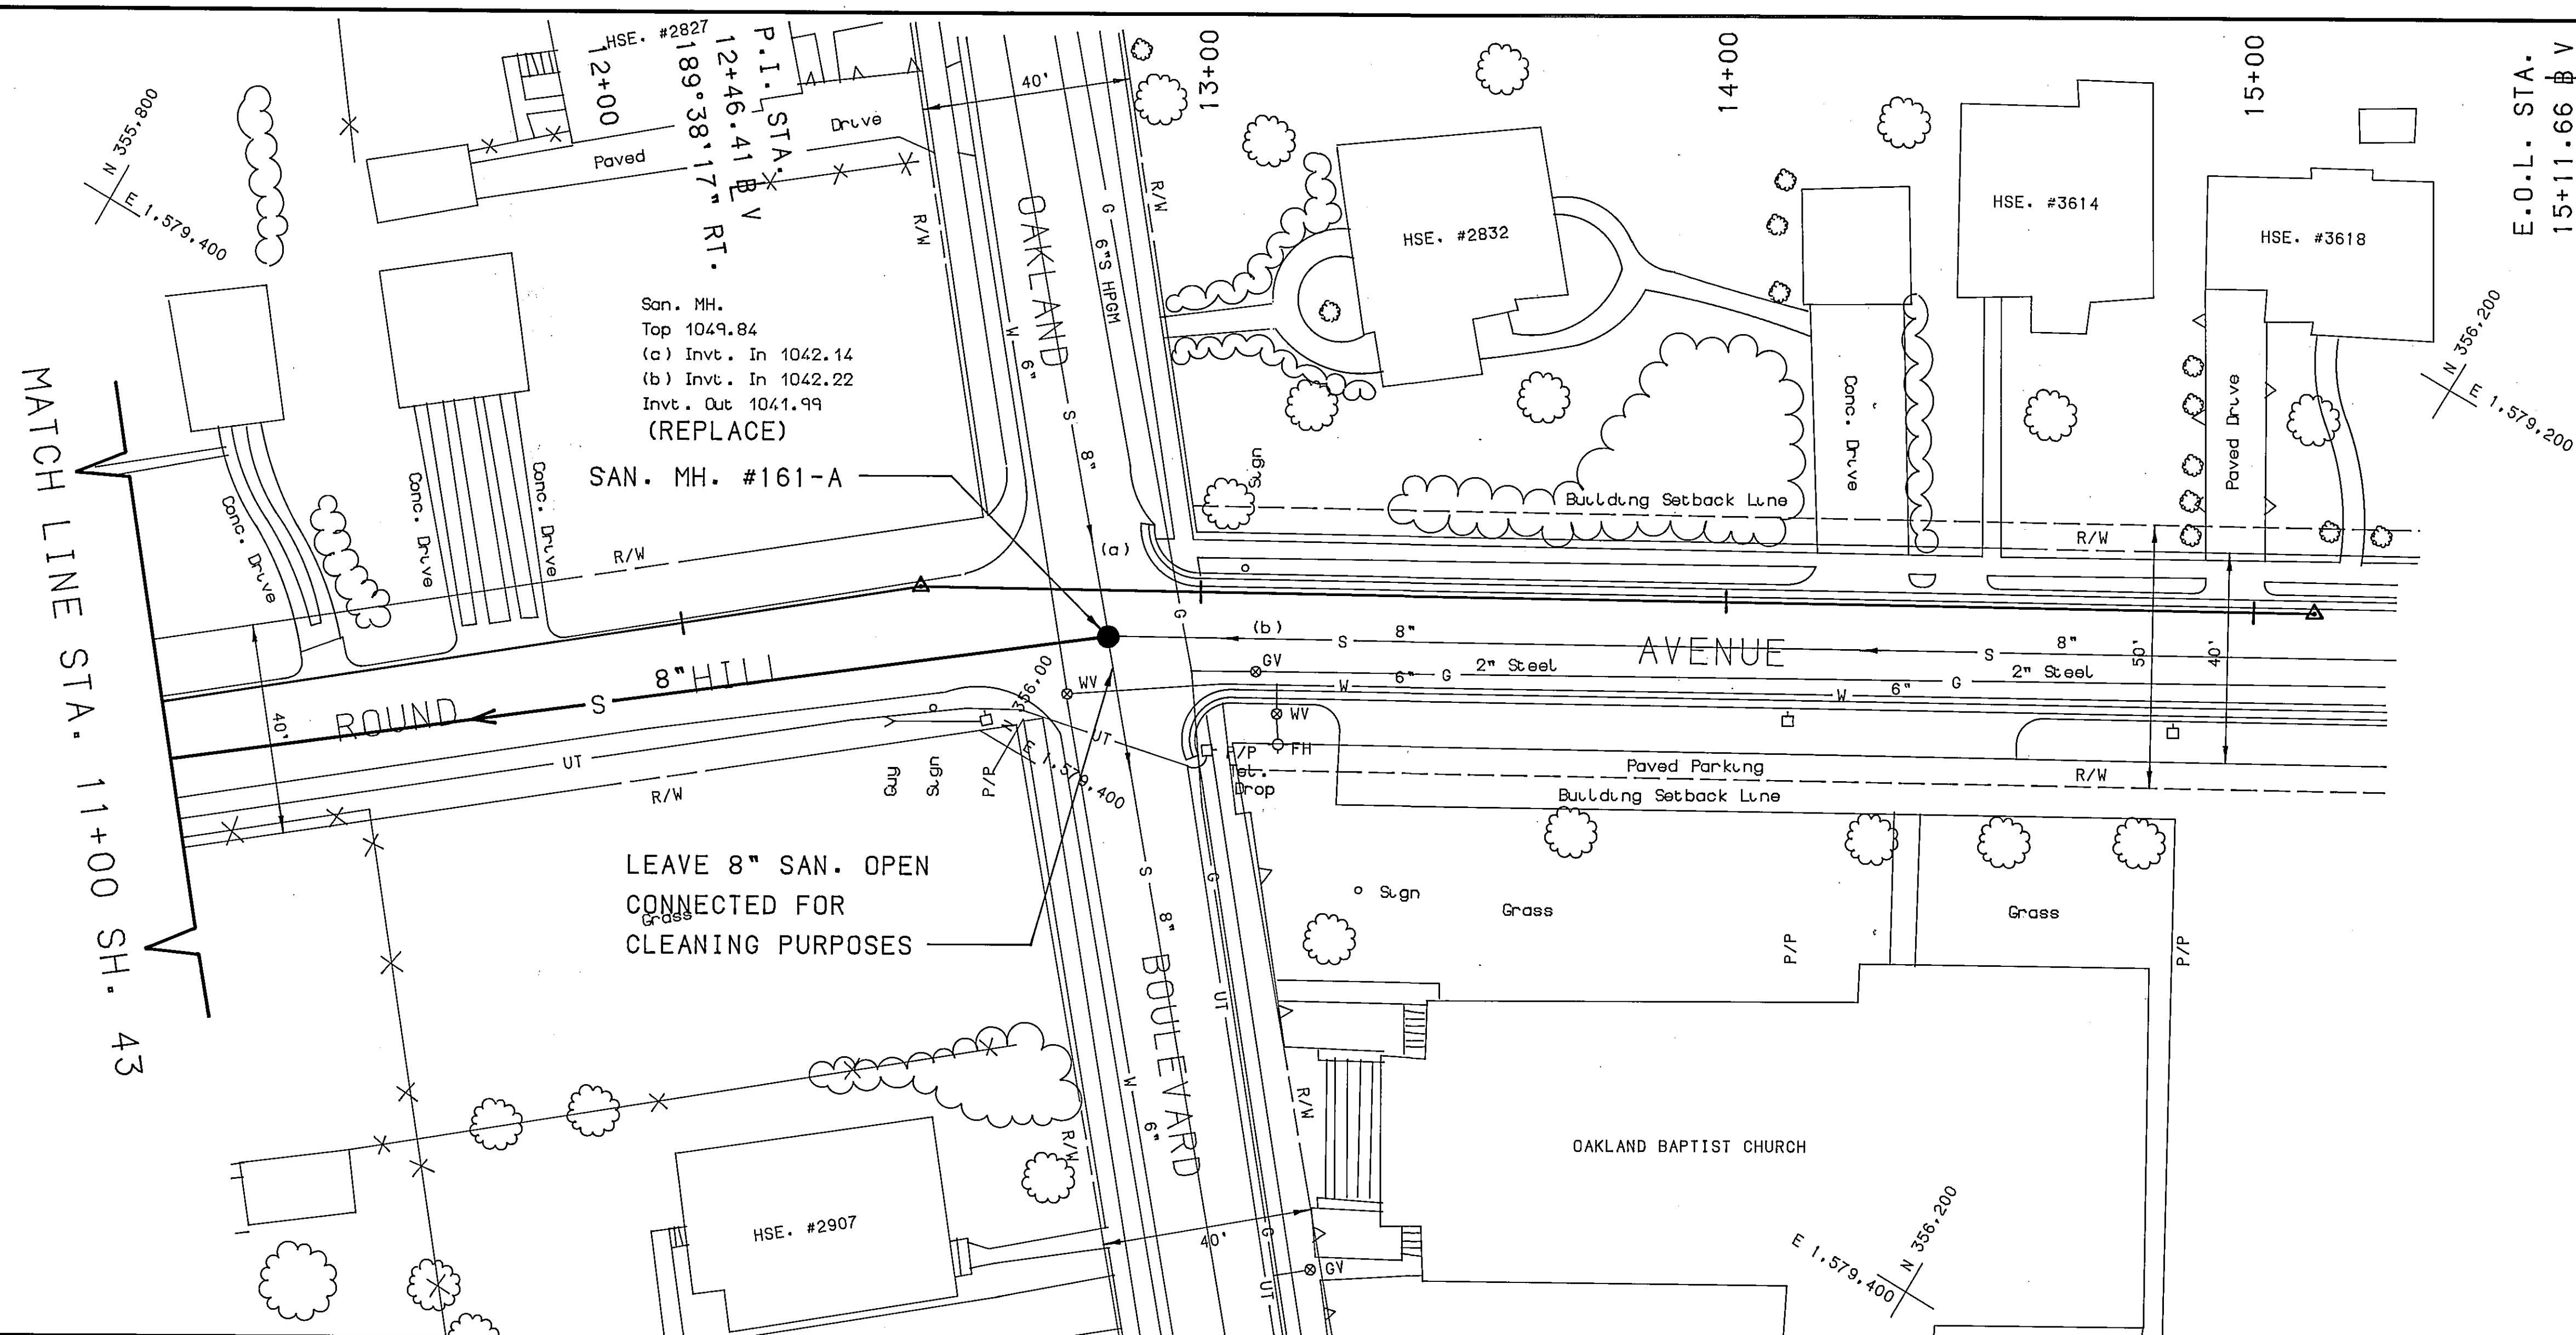
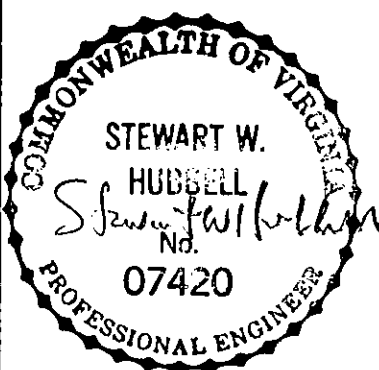


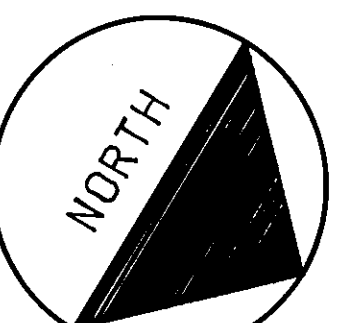

 Mattern & Craig CONSULTING ENGINEERS - SURVEYORS 701 FIRST STREET, ROANOKE, VIRGINIA 24016 (703) 345-9342	DESIGNED*	ARB/SWH			REVISION	DATE	DESCRIPTION	BY	APP.	DATE JULY 1987 COMM.	WILLIAMSON ROAD STORM DRAIN- PHASE 2 CONTRACT II-A ROANOKE, VIRGINIA	SHEET 49-A
	CHECKED*	GRN			1	DEC. 89	RECORD DRAWING	JLJ	SWH			
	APPROVED*											

580/581
PLAN AND PROFILE