



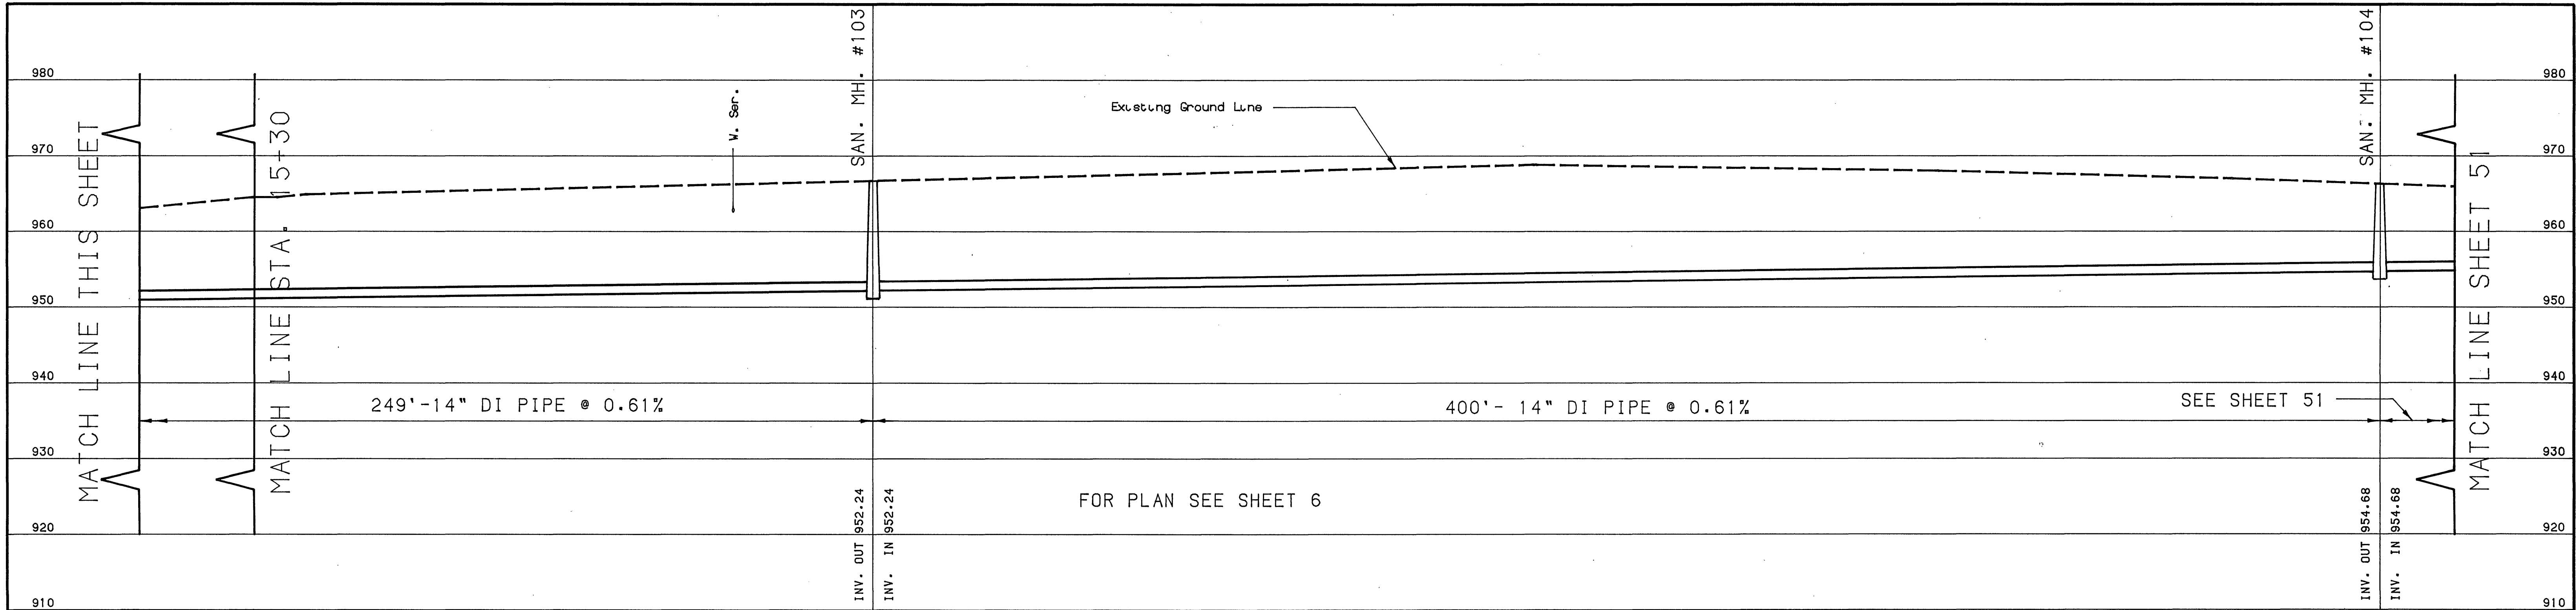


SCALE: HORZ. 1" = 20'
VERT. 1" = 10'

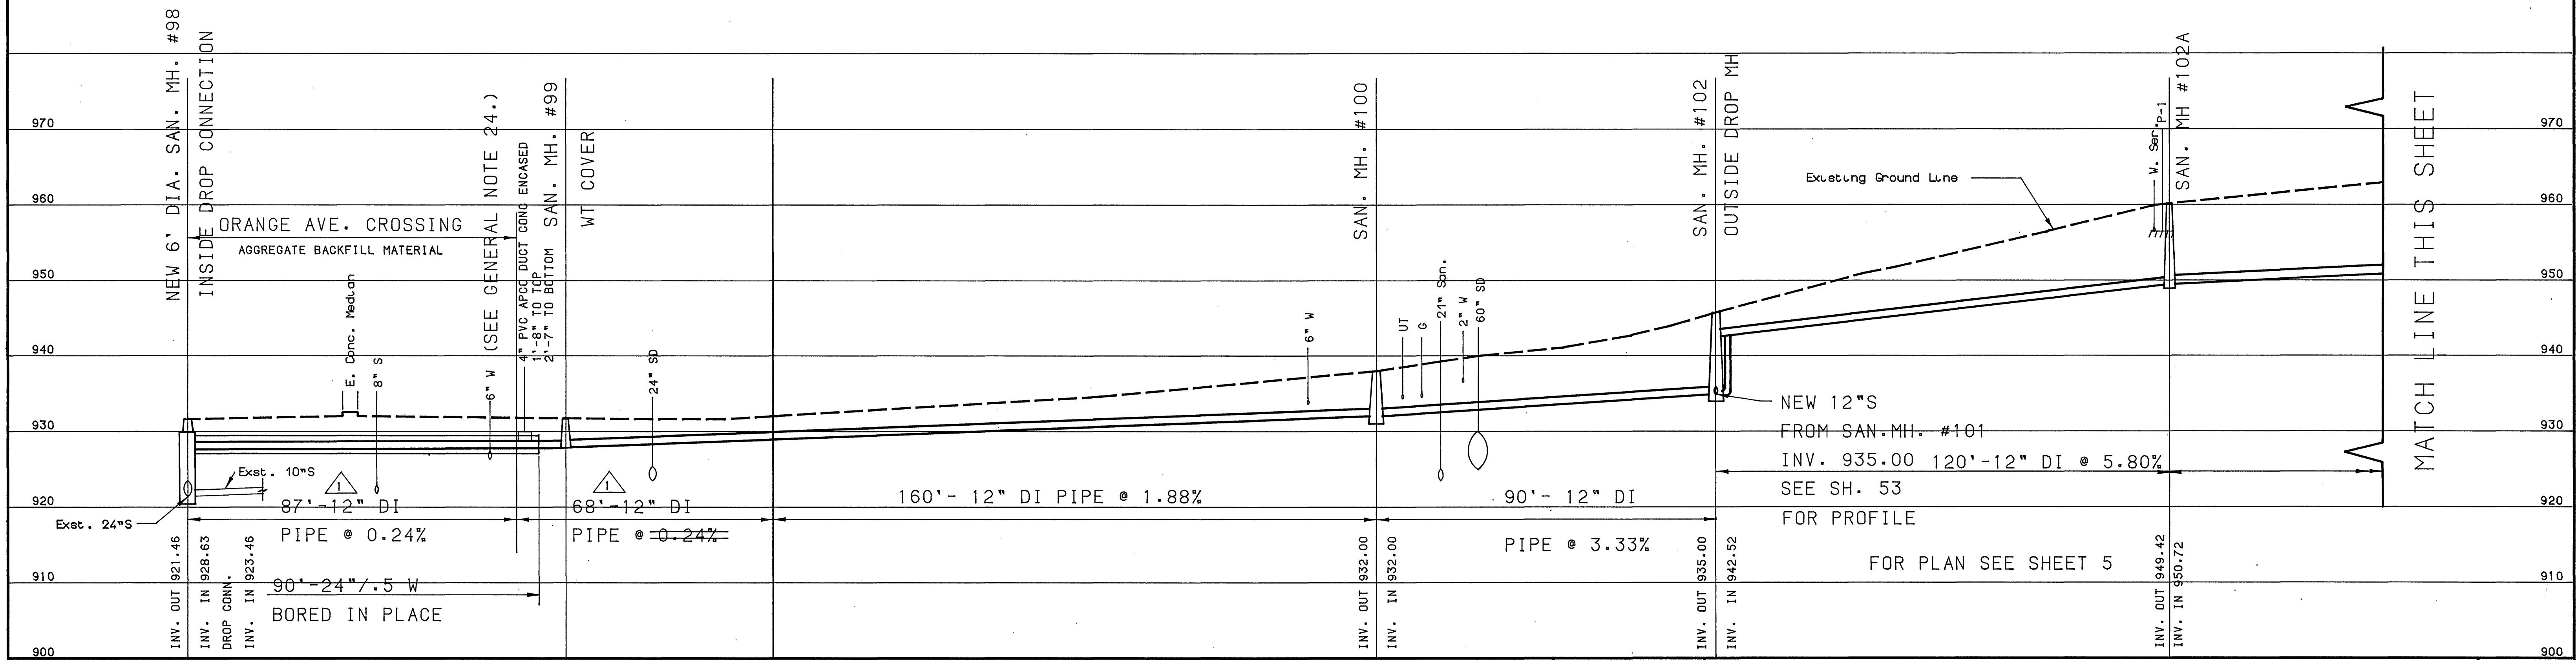

Mattern & Craig
CONSULTING ENGINEERS - SURVEYORS
701 FIRST STREET, ROANOKE, VIRGINIA 24016, (703) 345-8342

DESIGNED: ARB/SWH
CHECKED: GRN
APPROVED:

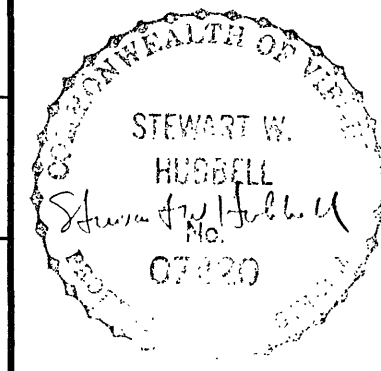

REVISION	DATE	DESCRIPTION	BY	APP.
1	10/14/87	SANITARY SIZE CHANGE	ARB	SWH
2	DEC. 89	RECORD DRAWING	JLJ	SWH

DATE
JULY 1987
COMM.
581

WILLIAMSON ROAD STORM DRAIN- PHASE 2
CONTRACT II-A
ROANOKE, VIRGINIA
PROFILE- SANITARY SEWER

SHEET
50