

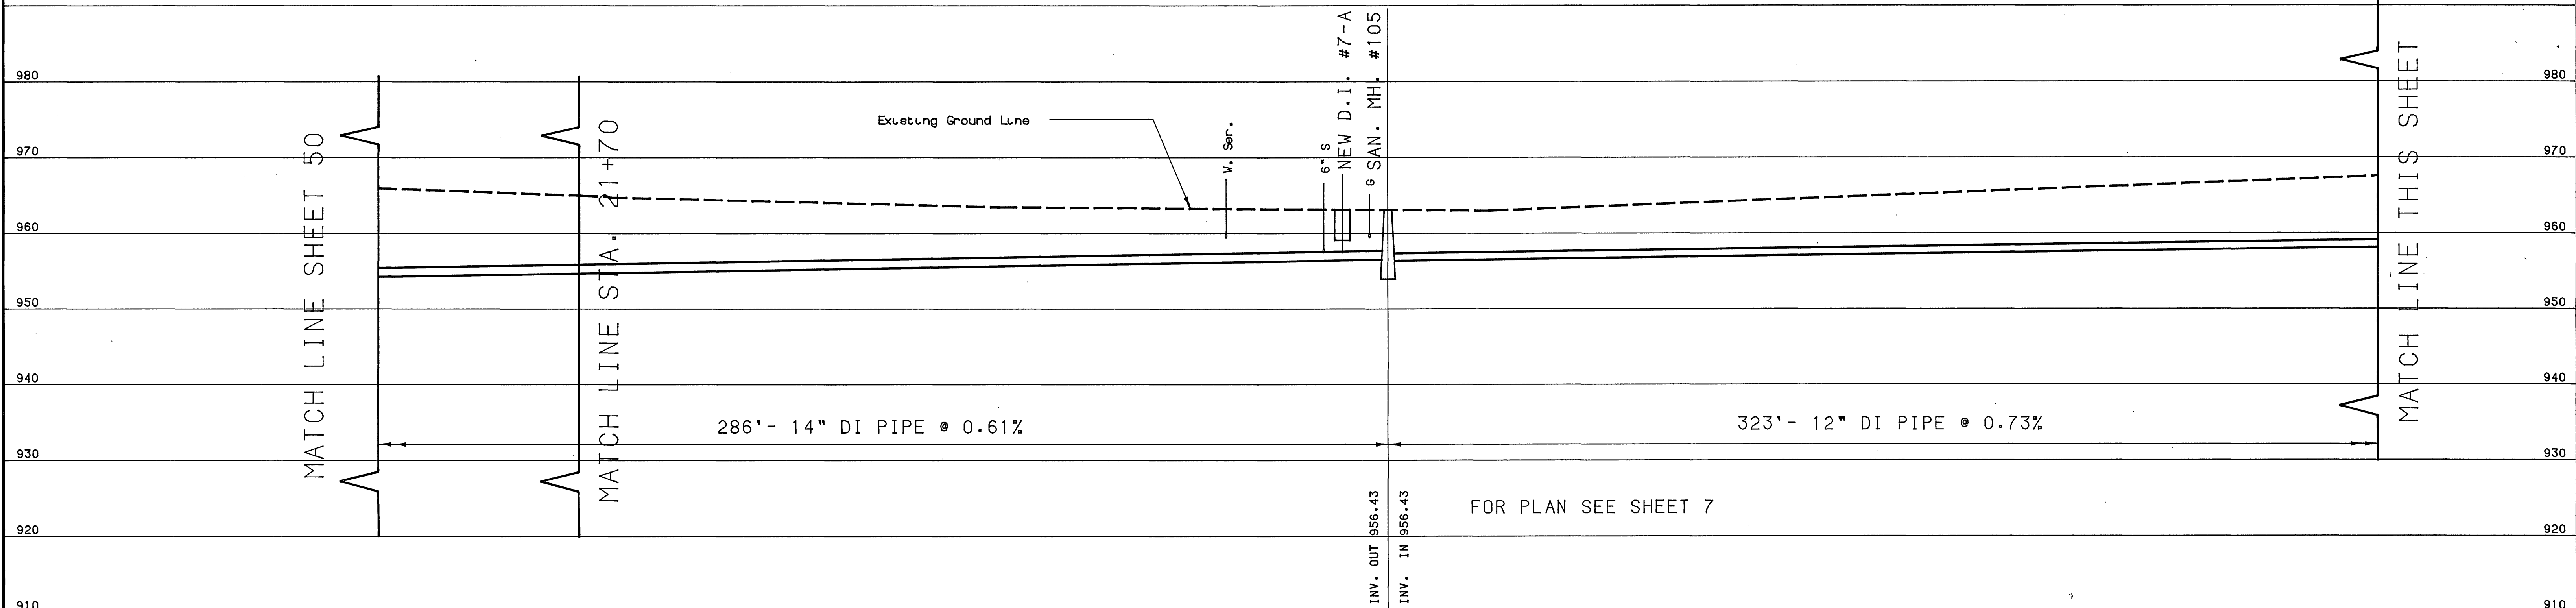


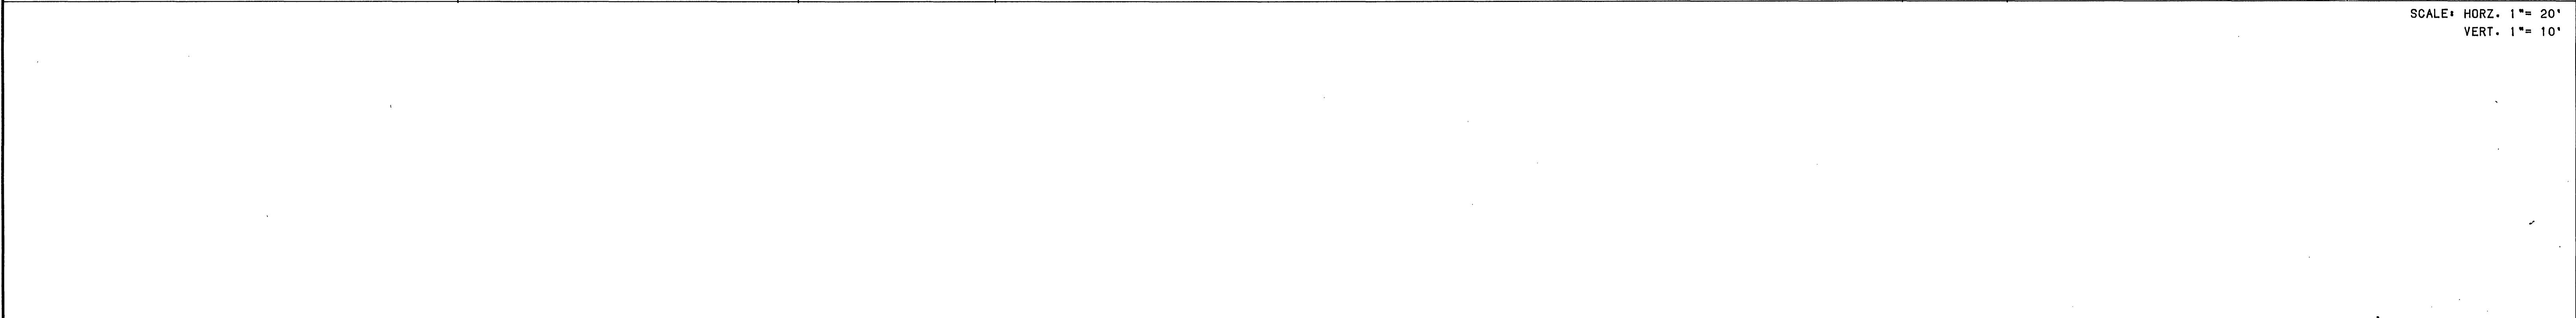

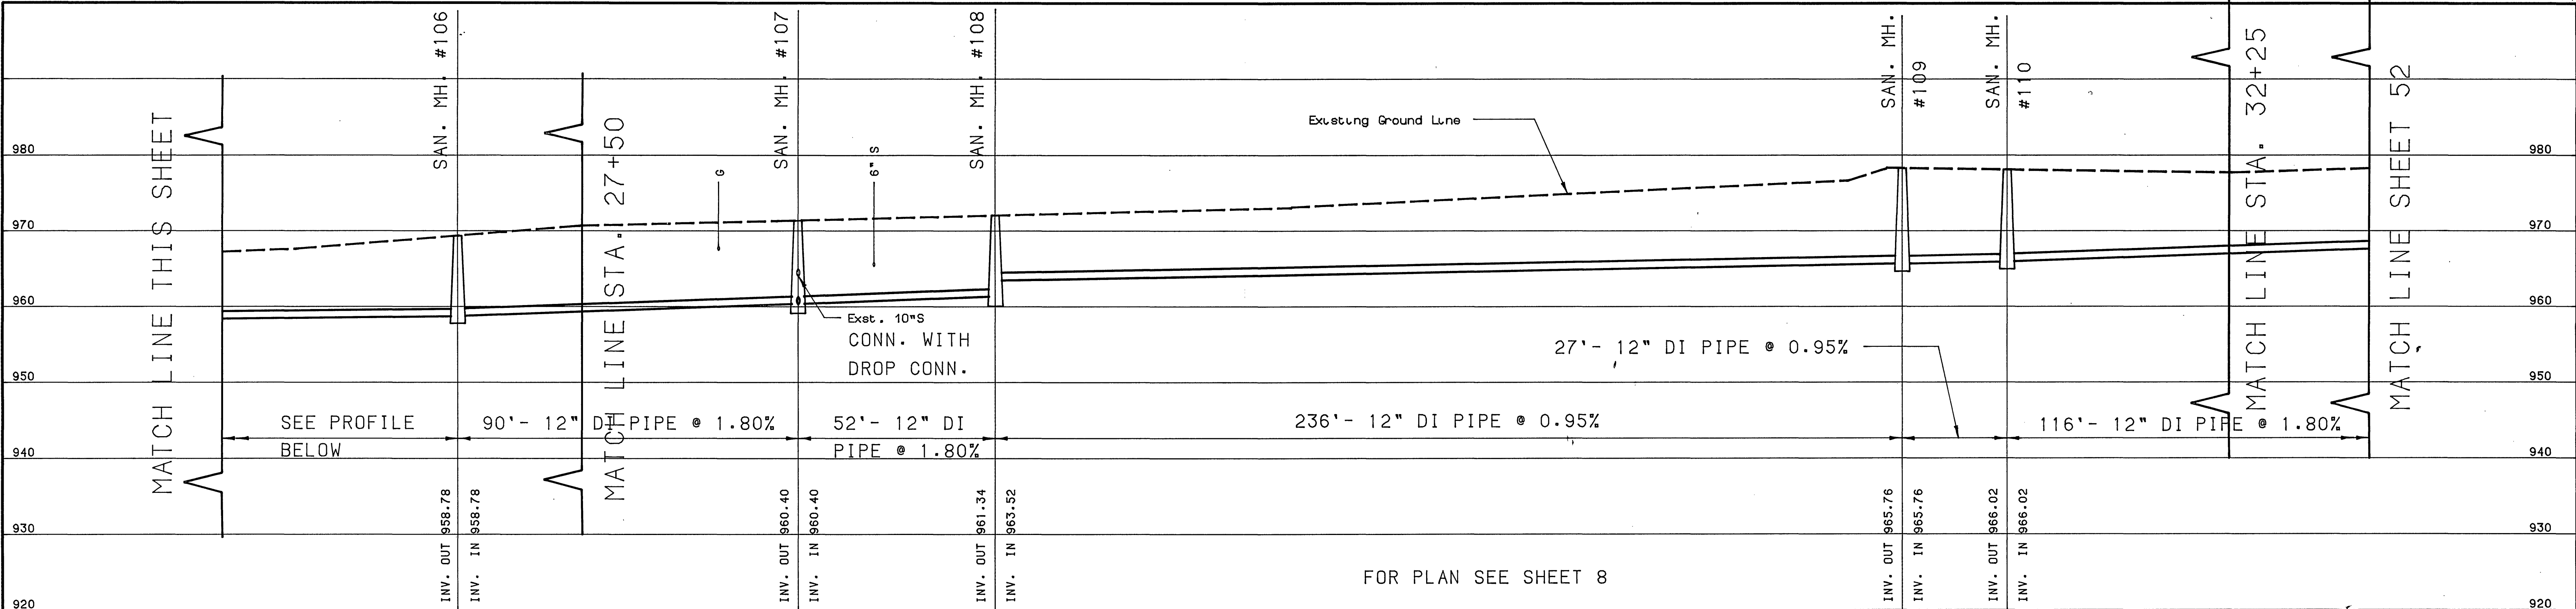


Mattern & Craig
CONSULTING ENGINEERS - SURVEYORS
701 FIRST STREET, ROANOKE, VIRGINIA 24016, (703) 345-9342

DESIGNED: ARB/SWH

CHECKED: GRN

APPROVED:

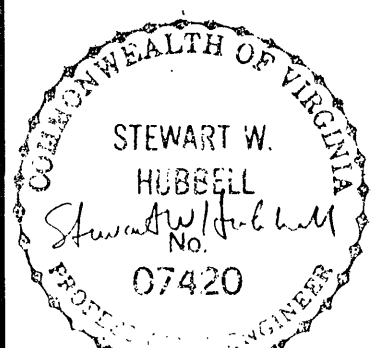

REVISION	DATE	DESCRIPTION	BY	APP.
1	DEC. 89	RECORD DRAWING	JLJ	SWH

DATE
JULY 1987
COMM.
581

WILLIAMSON ROAD STORM DRAIN- PHASE 2

CONTRACT II-A

ROANOKE, VIRGINIA

PROFILE- SANITARY SEWER

SHEET
51