




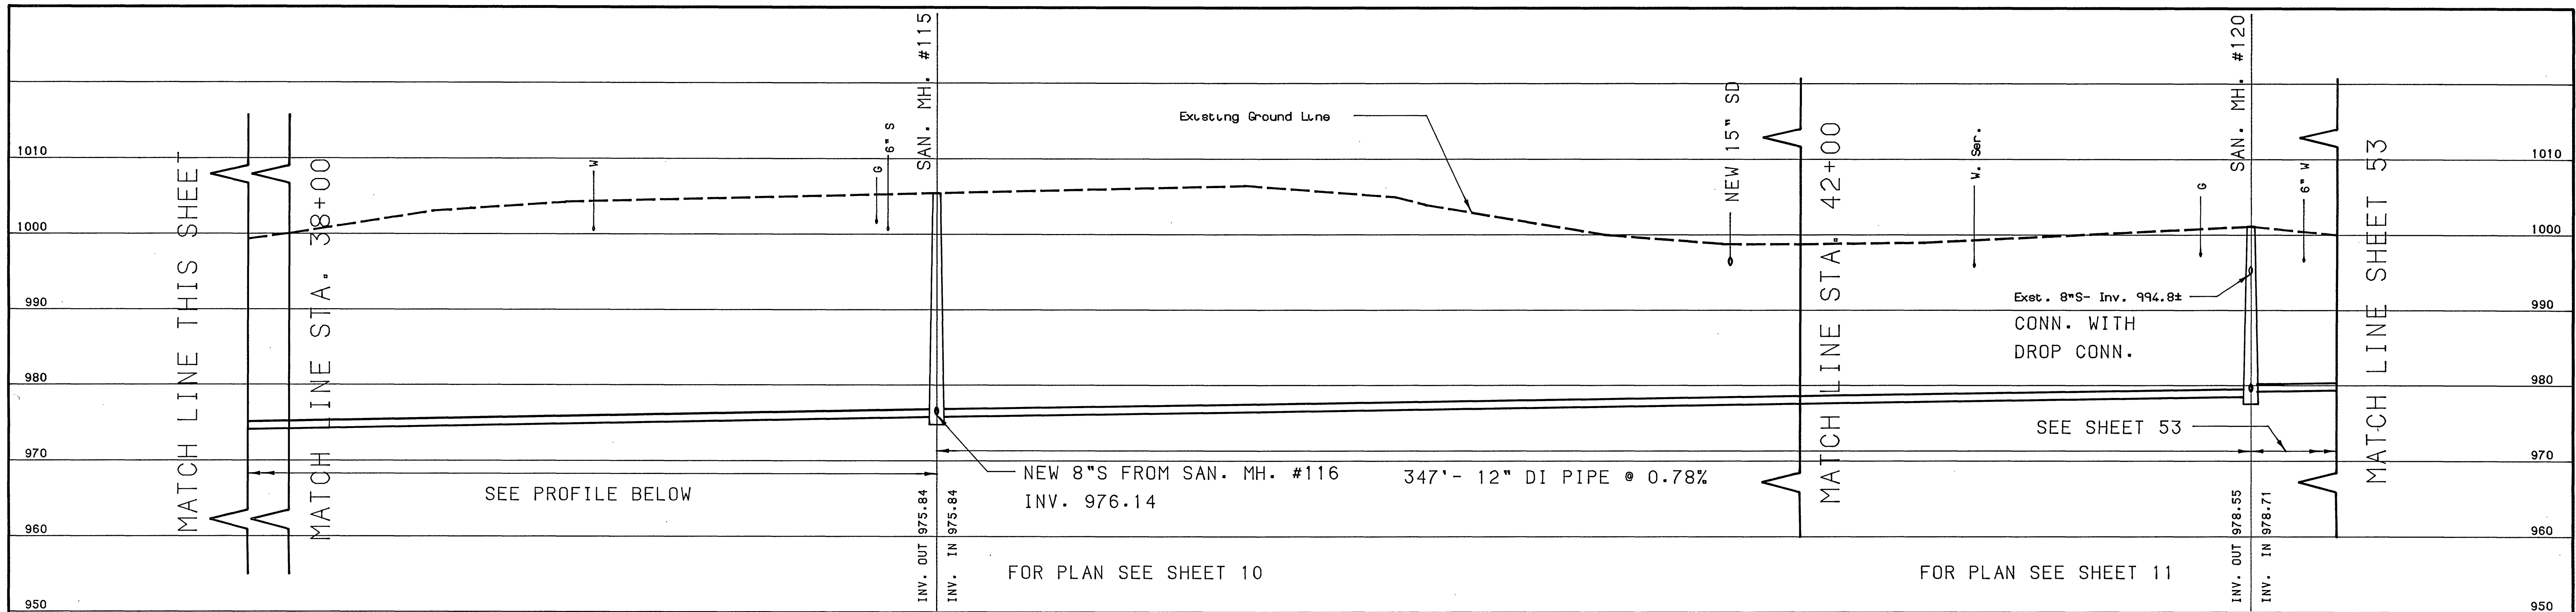

SCALE: HORIZ. 1"= 20'
VERT. 1"= 10'

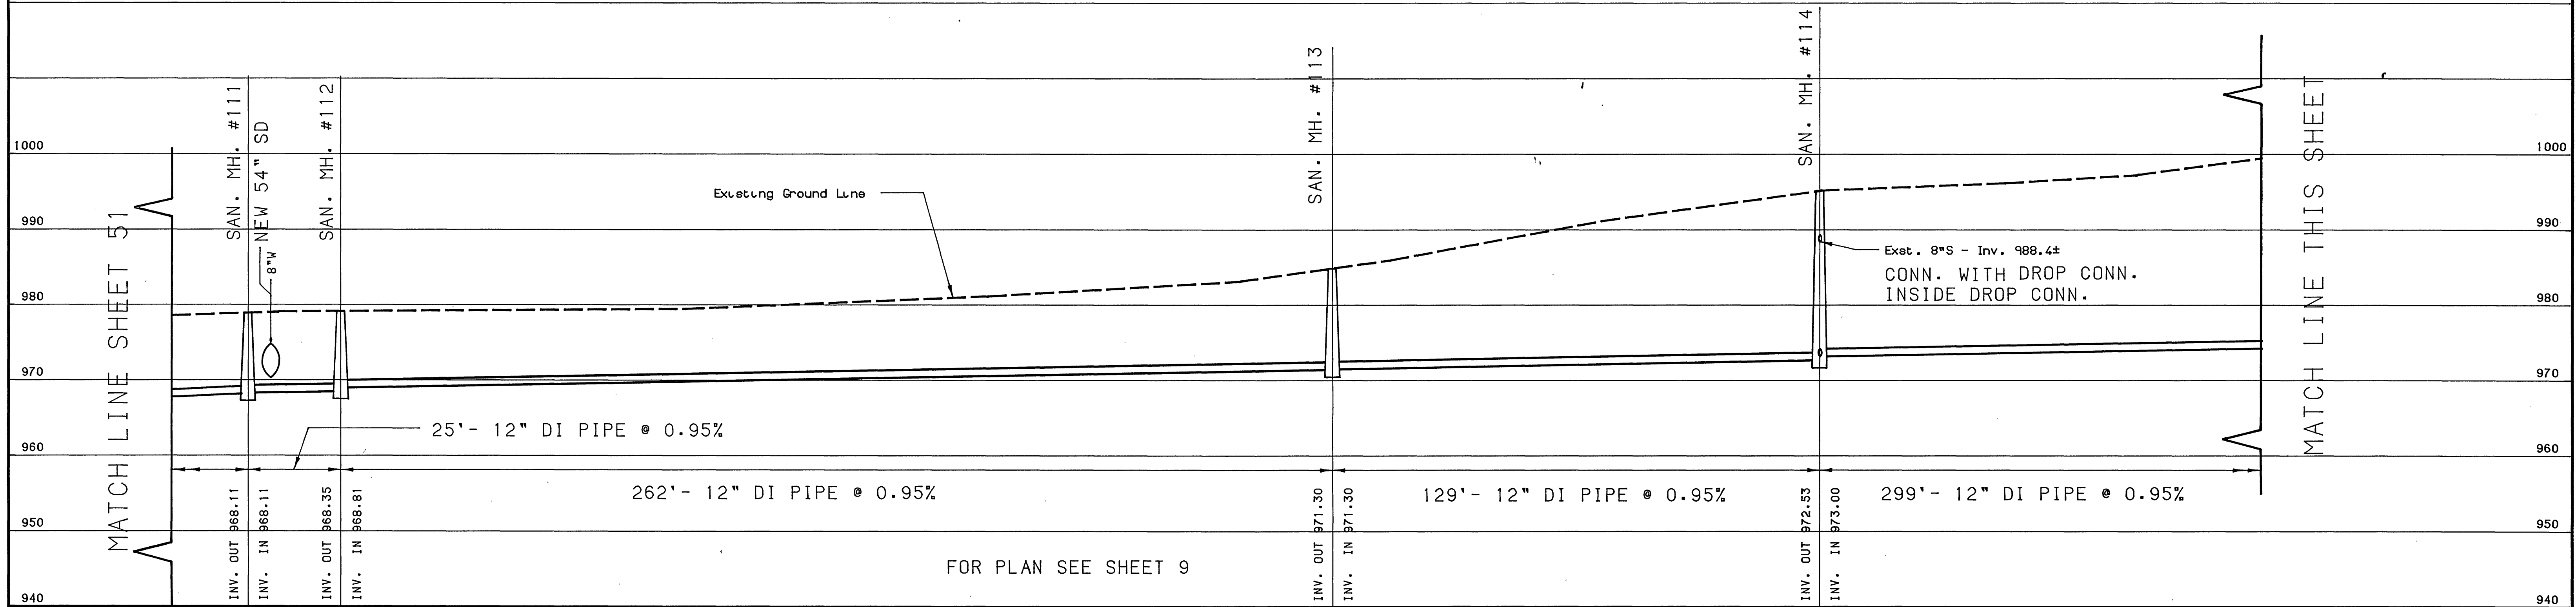

DESIGNED: ARB/SWH
CHECKED: GRN
APPROVED:

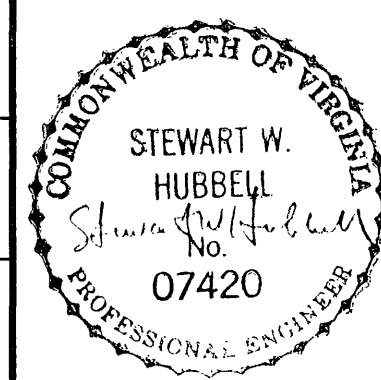

REVISION	DATE	DESCRIPTION	BY	APP.
1	DEC. 89	RECORD DRAWING	JLJ	SWH

DATE
JULY
1987
COMM.
581

WILLIAMSON ROAD STORM DRAIN- PHASE 2
CONTRACT II-A
ROANOKE, VIRGINIA
PROFILE- SANITARY SEWER

SHEET
52