




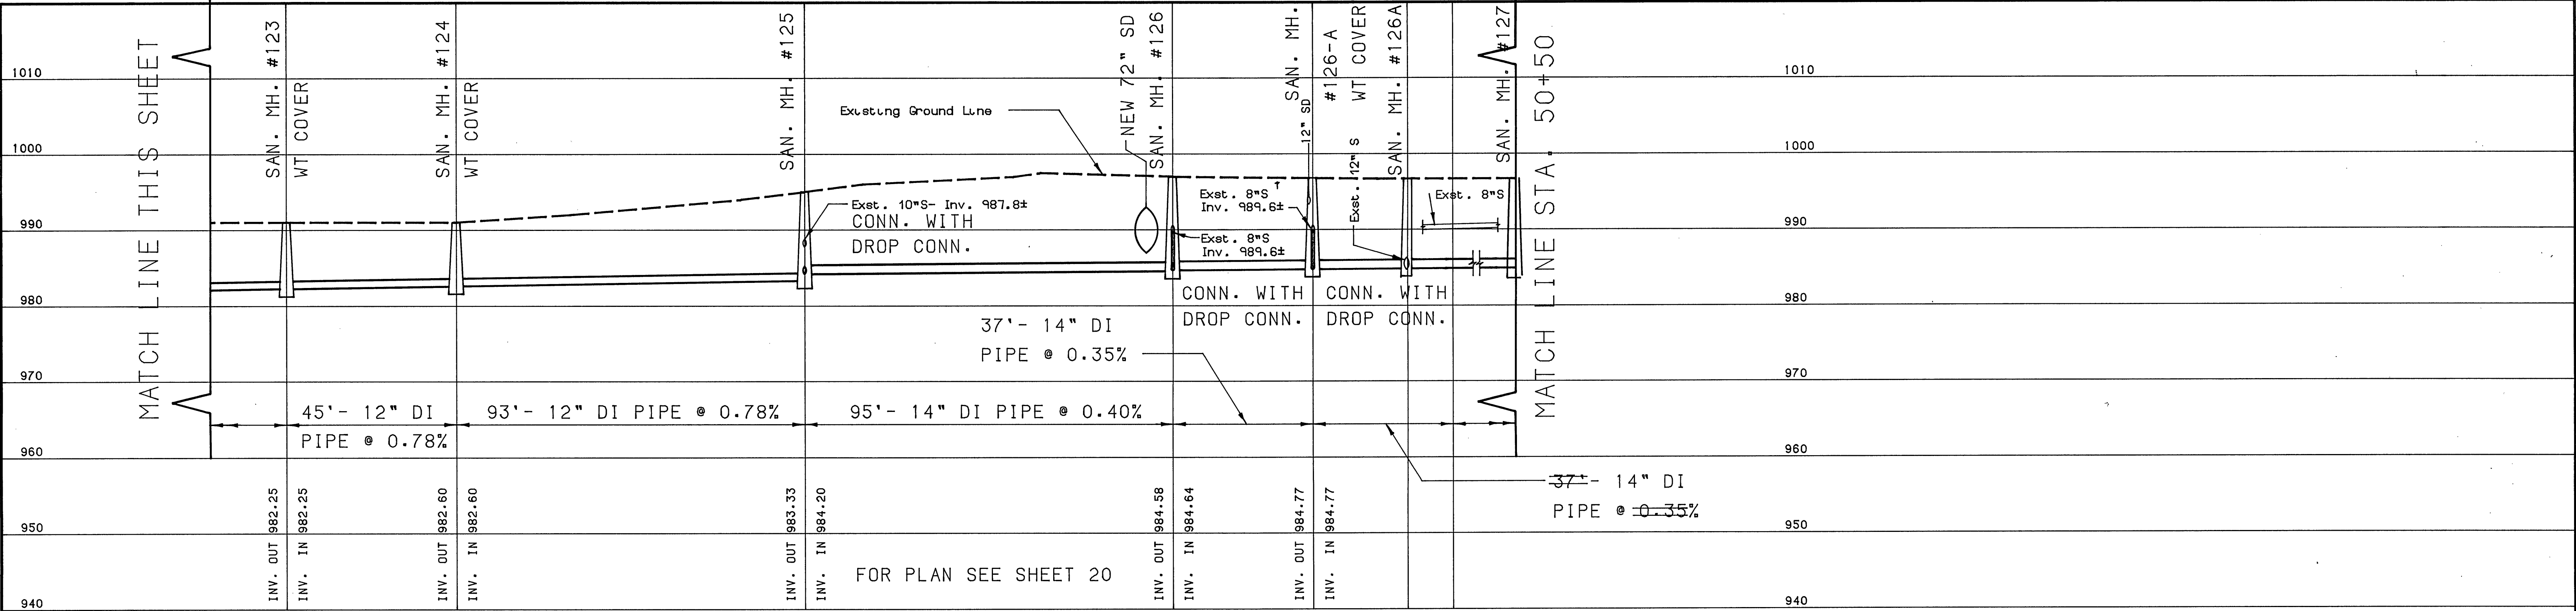

SCALE: HORIZ. 1"= 20'
VERT. 1"= 10'

- NOTES:
- 1. MANHOLE COVERS ARE STANDARD TYPE UNLESS SPECIFICALLY NOTED AS WATERTIGHT (WT).

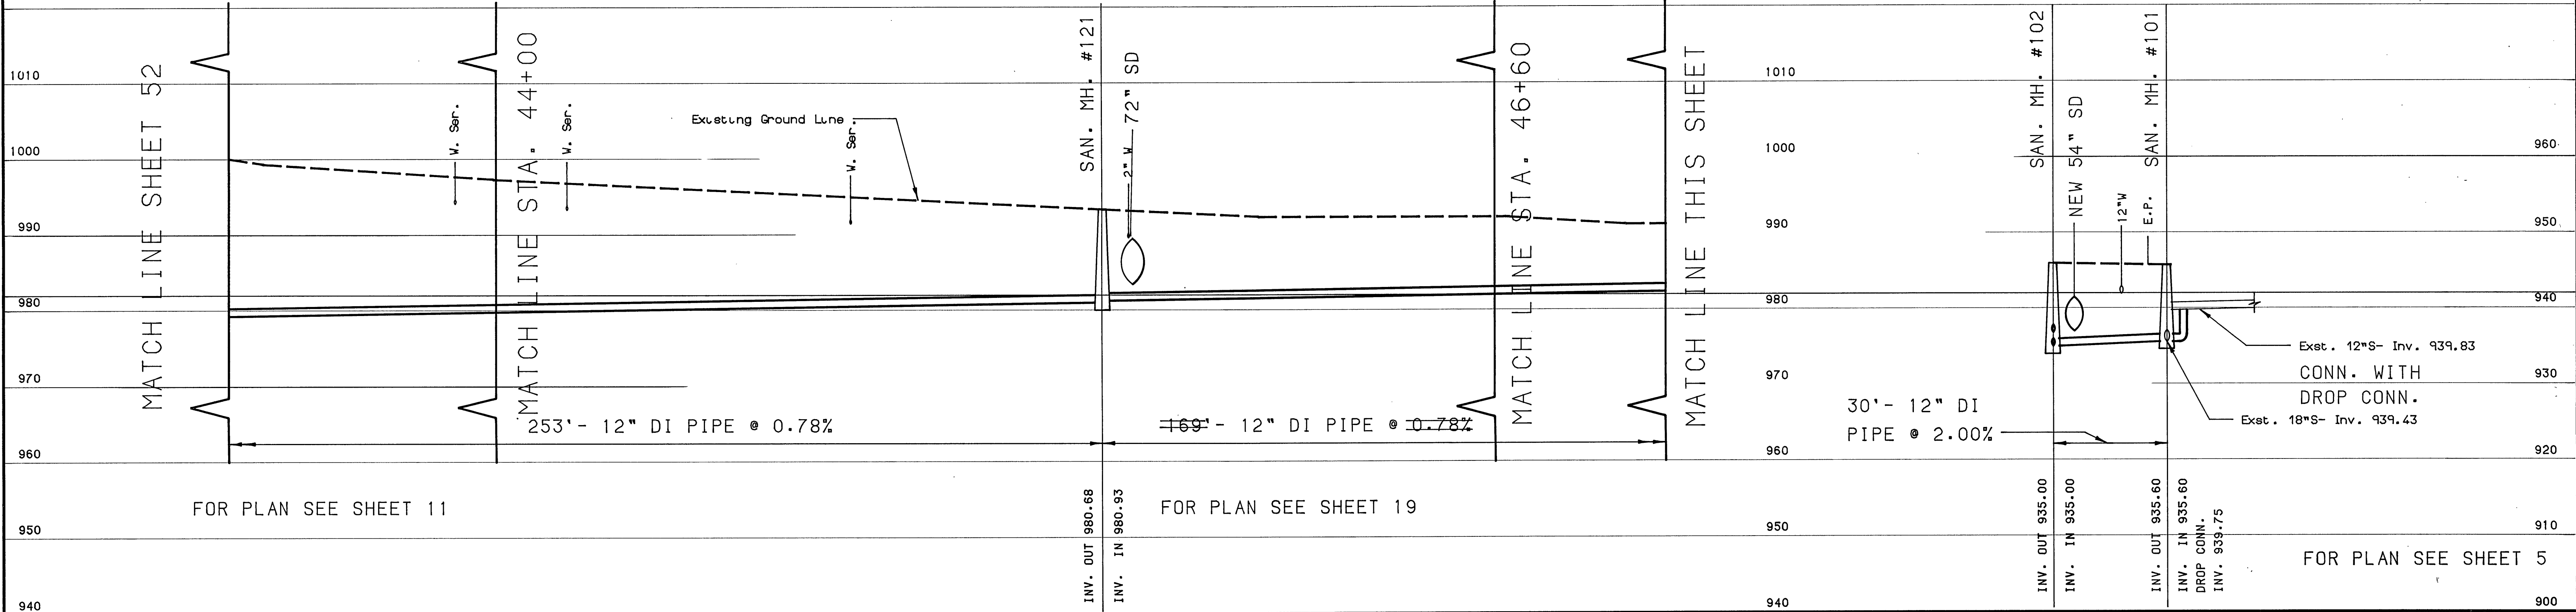

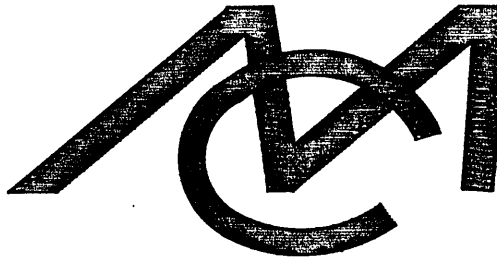


Mattern & Craig
CONSULTING ENGINEERS - SURVEYORS
701 FIRST STREET, ROANOKE, VIRGINIA 24016, (703) 345-9342

DESIGNED: ARB/SWH

CHECKED: GRN

APPROVED:

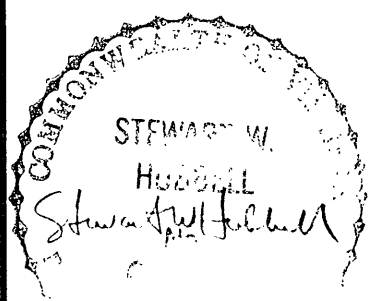

REVISION	DATE	DESCRIPTION	BY	APP.
1	DEC. 89	RECORD DRAWING	JLJ	SWH

DATE
JULY 1987
COMM.
581

WILLIAMSON ROAD STORM DRAIN- PHASE 2
CONTRACT II-A
ROANOKE, VIRGINIA

SHEET
53