

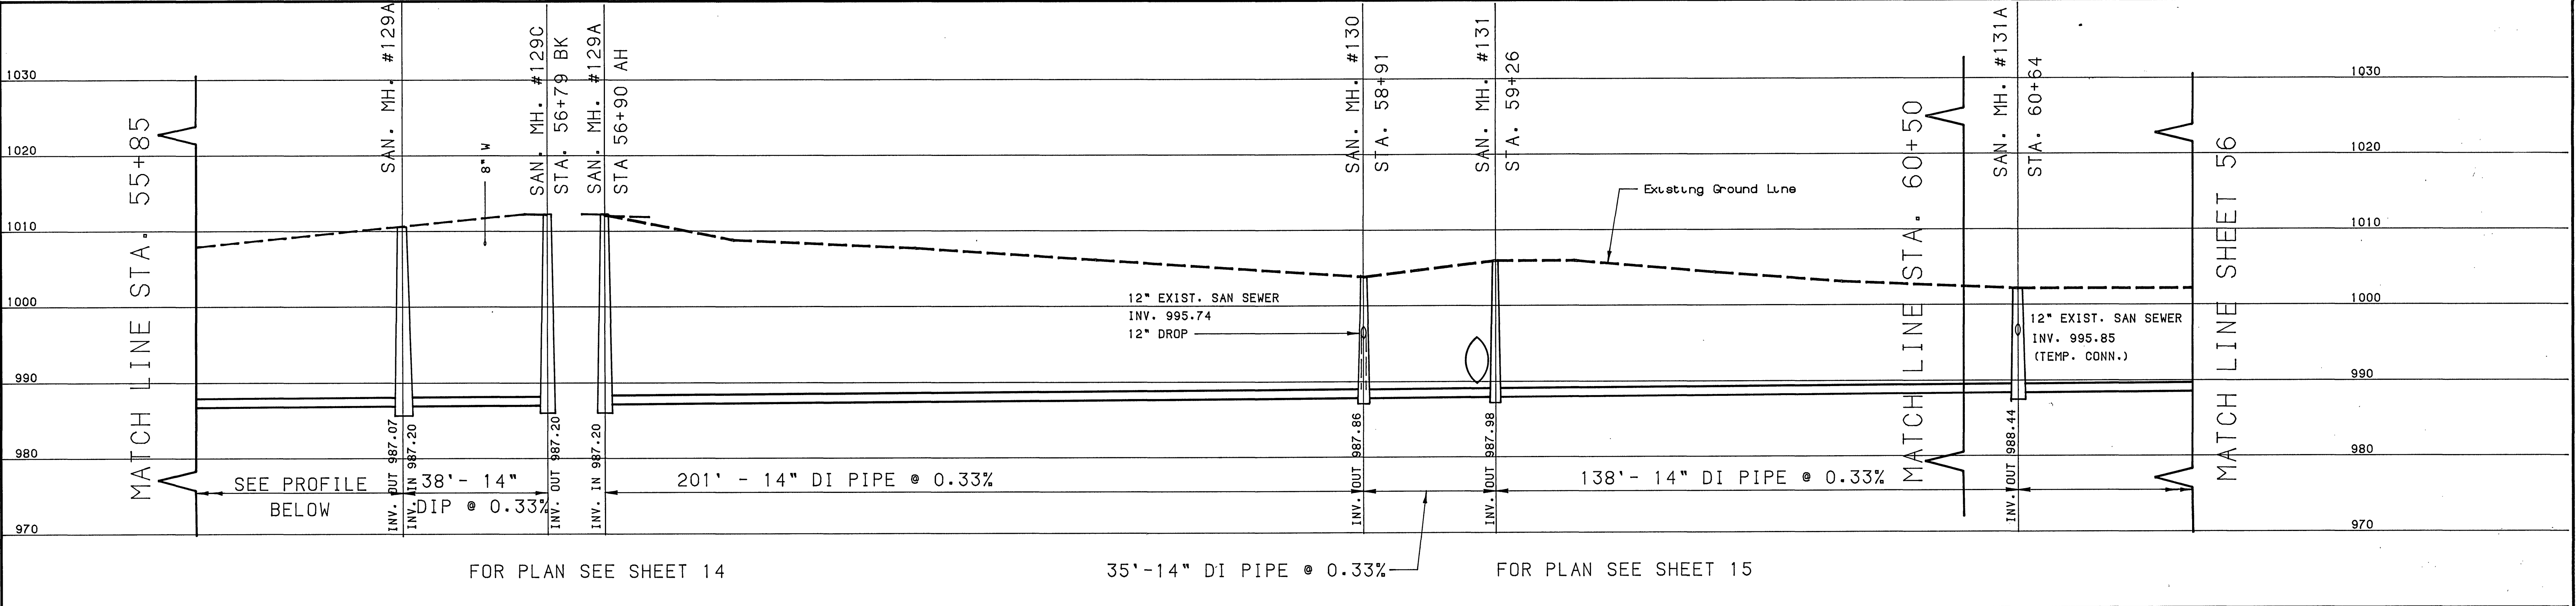
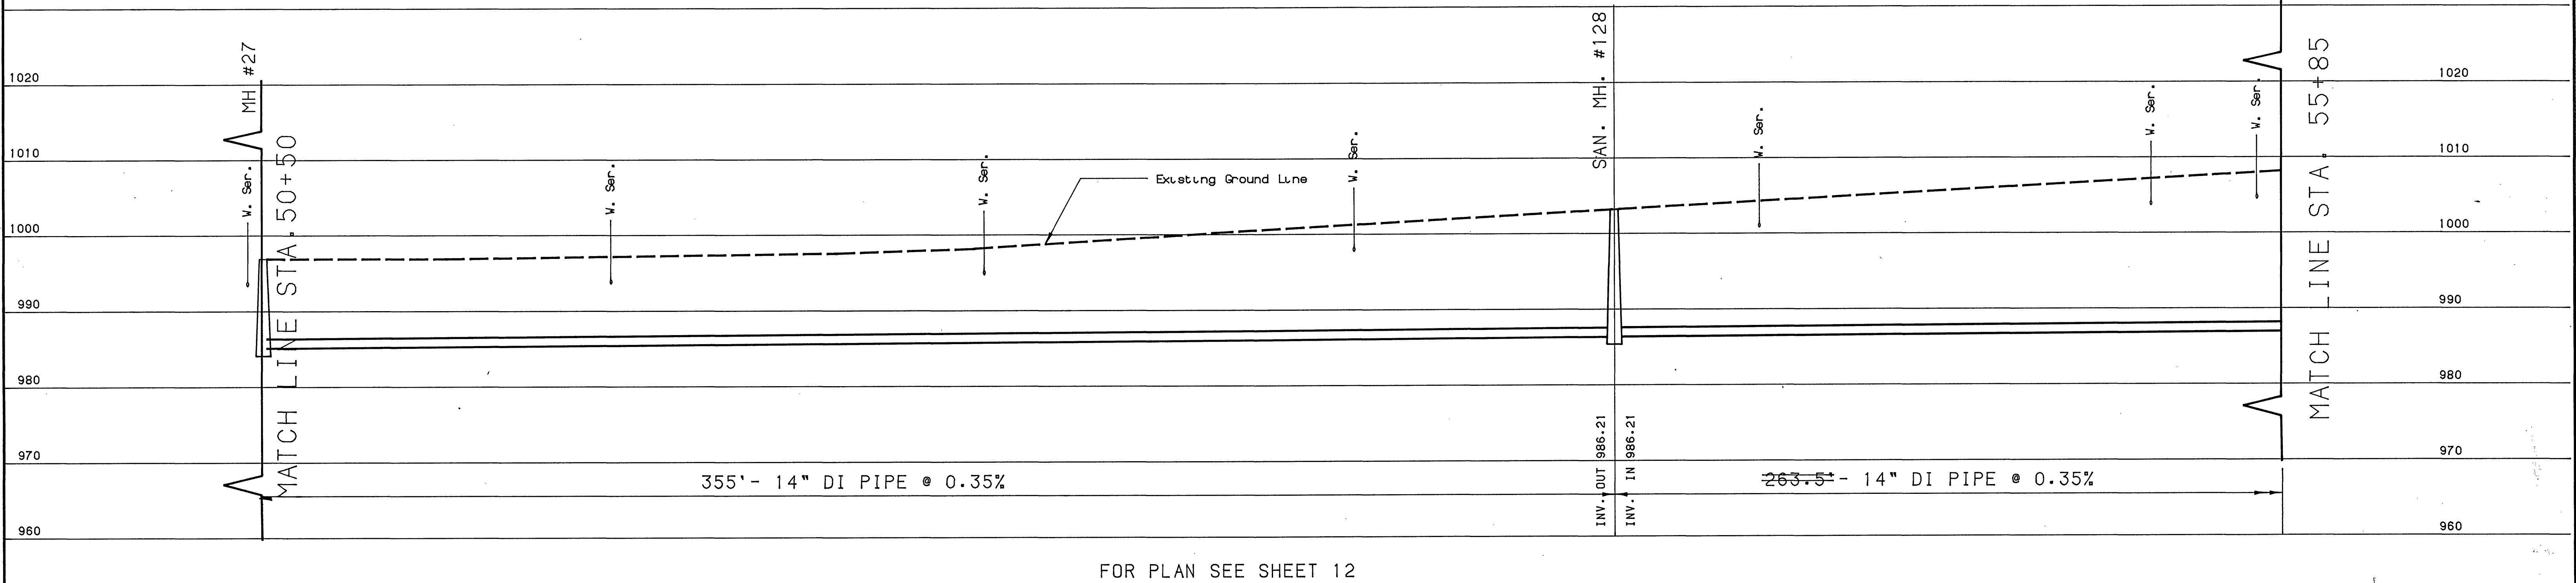


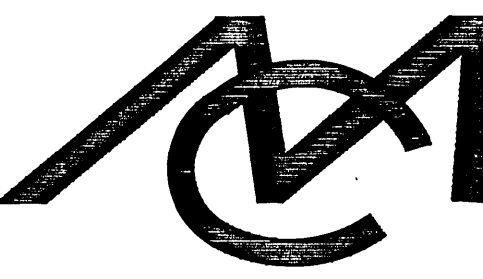

SCALE: HORZ. 1"= 20'
VERT. 1"= 10'

- NOTES:
- 1. MANHOLE COVERS ARE STANDARD TYPE UNLESS SPECIFICALLY NOTED AS WATERTIGHT (WT).

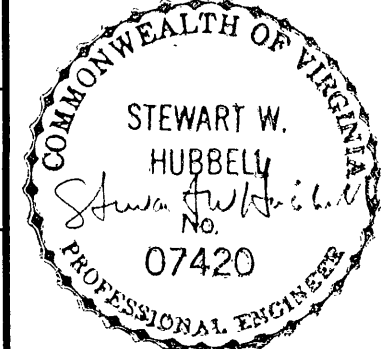

 Mattern & Craig CONSULTING ENGINEERS - SURVEYORS 701 FIRST STREET, ROANOKE, VIRGINIA 24016, (703) 345-9342	DESIGNED: ARB/SWH		REVISION	DATE	DESCRIPTION	BY	APP.	DATE JULY 1987 COMM. 581	WILLIAMSON ROAD STORM DRAIN- PHASE 2 CONTRACT II-A ROANOKE, VIRGINIA	SHEET 55
	CHECKED: GRN		1	DEC. 89	RECORD DRAWING	JLJ	SWH			
	APPROVED:									