



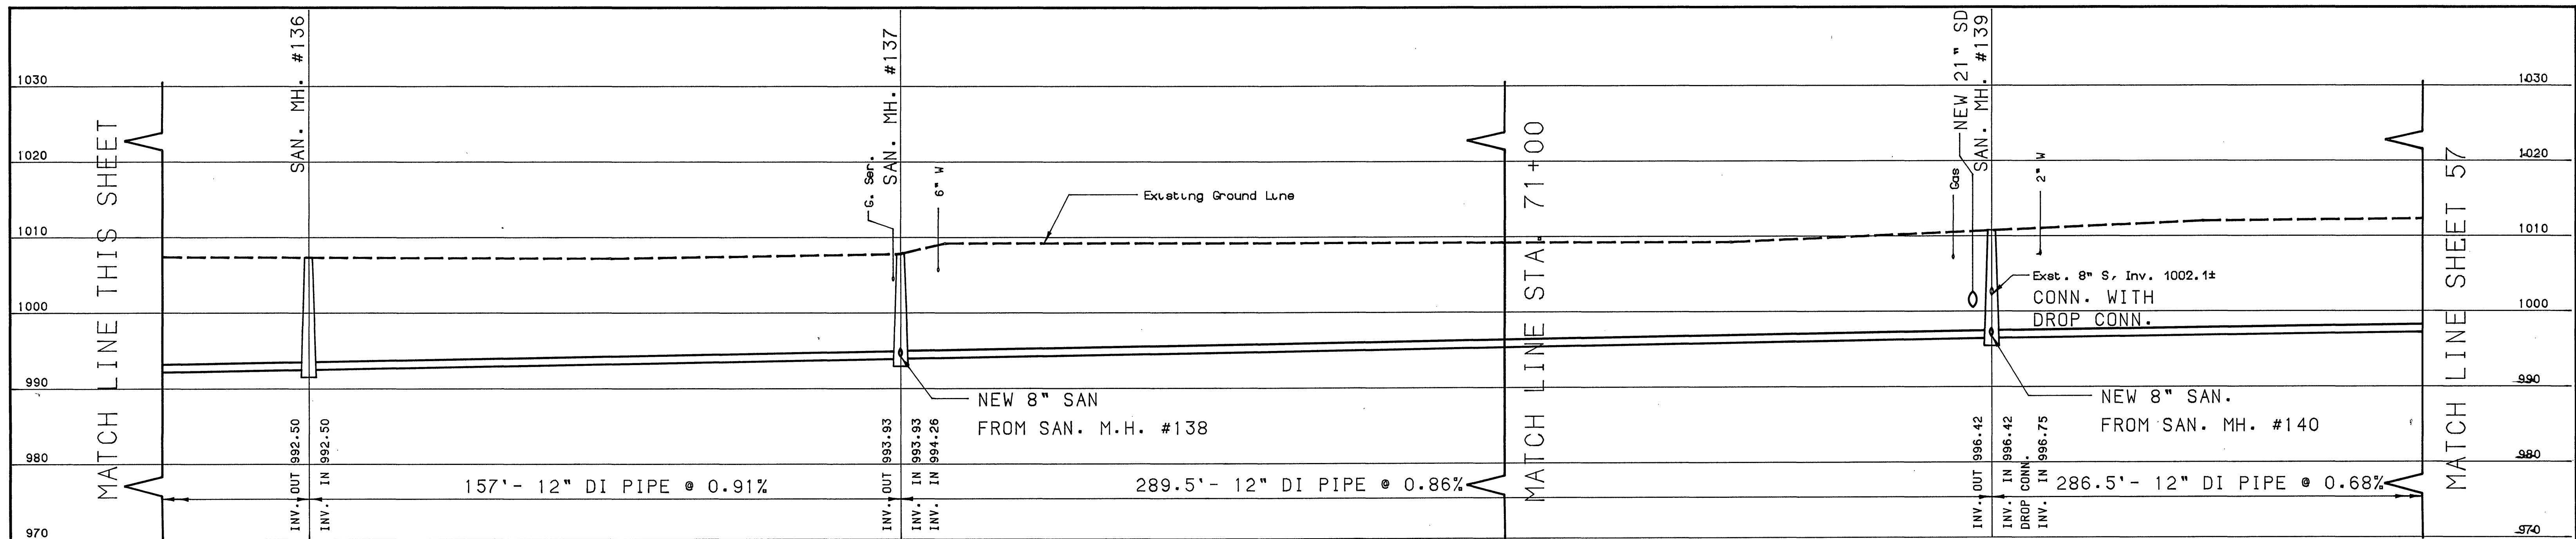

FOR PLAN SEE SHEET 21

FOR PLAN SEE SHEET 22

SCALE: HORZ. 1" = 20'
VERT. 1" = 10'

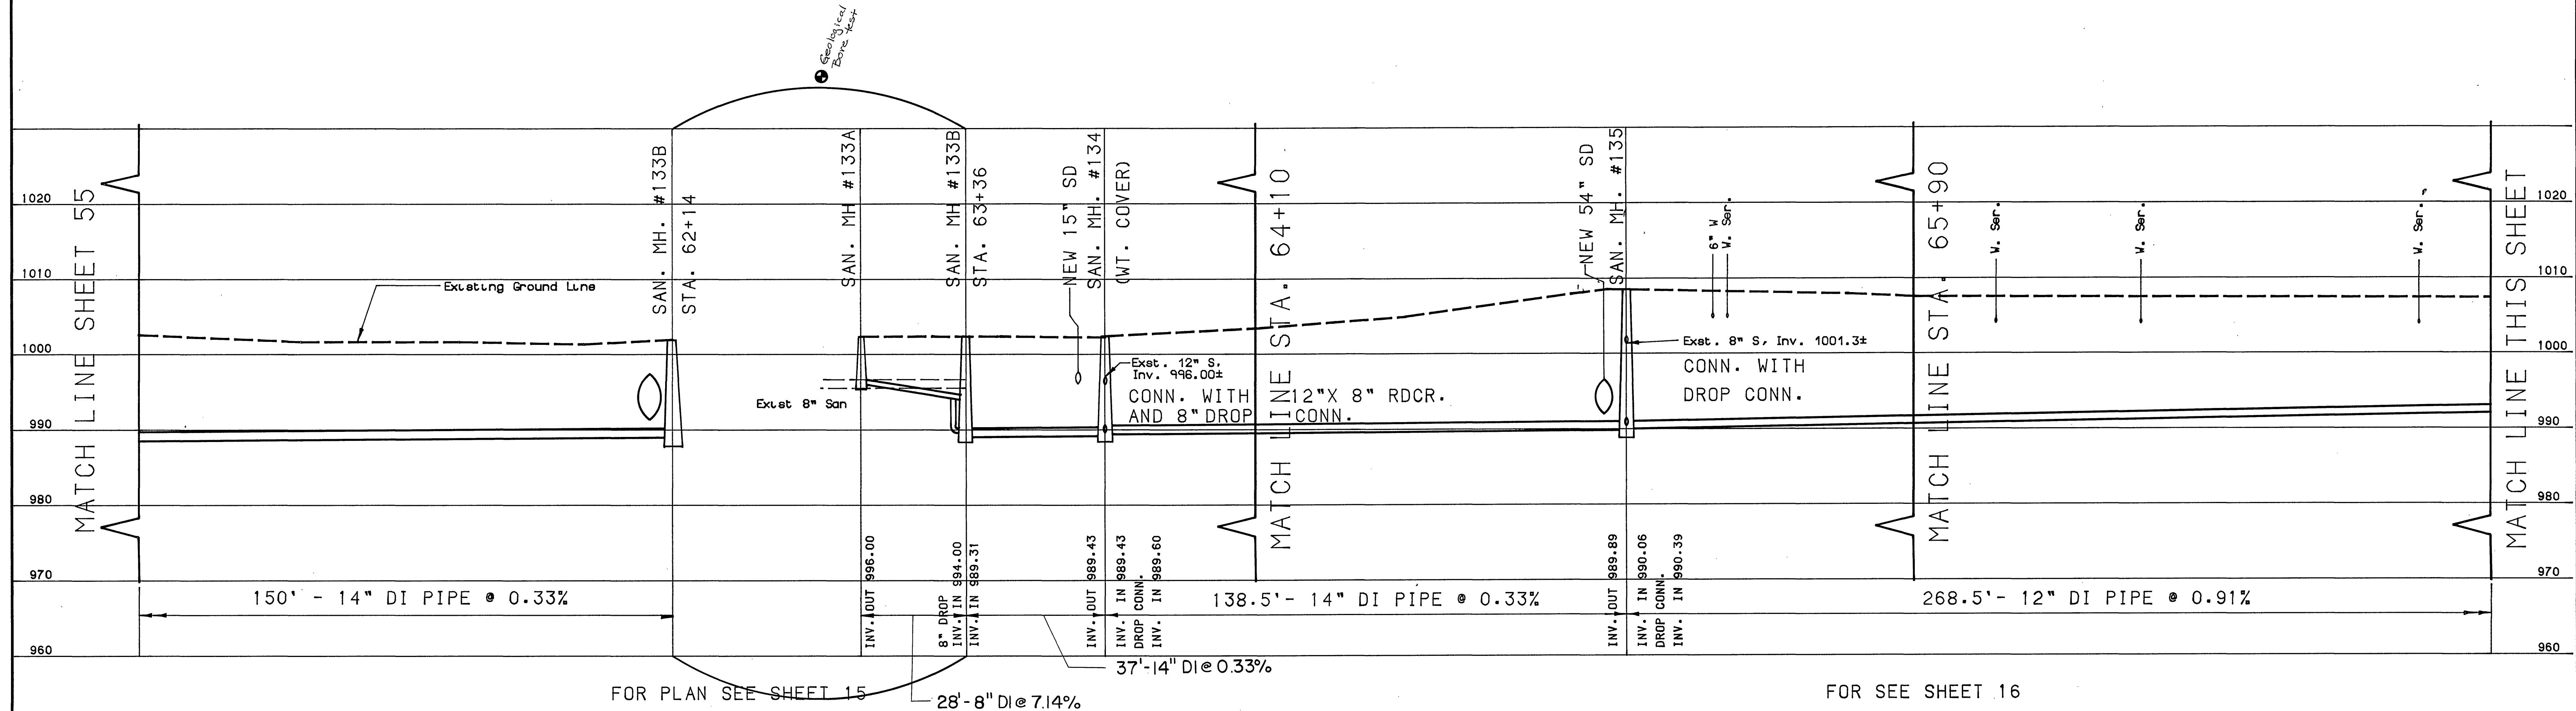


FOR PLAN SEE SHEET 15

FOR SEE SHEET 16



701 FIRST STREET, ROANOKE, VIRGINIA 24016, (703) 345-9342

DESIGNED: ARB/SWH
CHECKED: GRN
APPROVED:

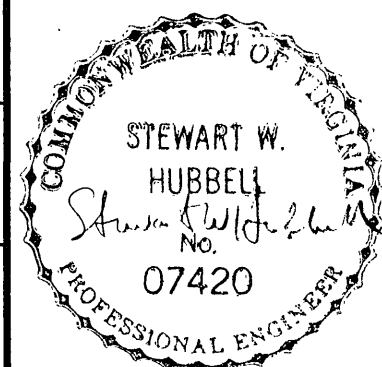

REVISION	DATE	DESCRIPTION	BY	APP.
1	DEC. 89	RECORD DRAWING	JLJ	SWH

DATE
JULY
1987
COMM.
581

WILLIAMSON ROAD STORM DRAIN- PHASE 2
CONTRACT 11-A
ROANOKE, VIRGINIA
PROFILE- SANITARY SEWER

SHEET
56