



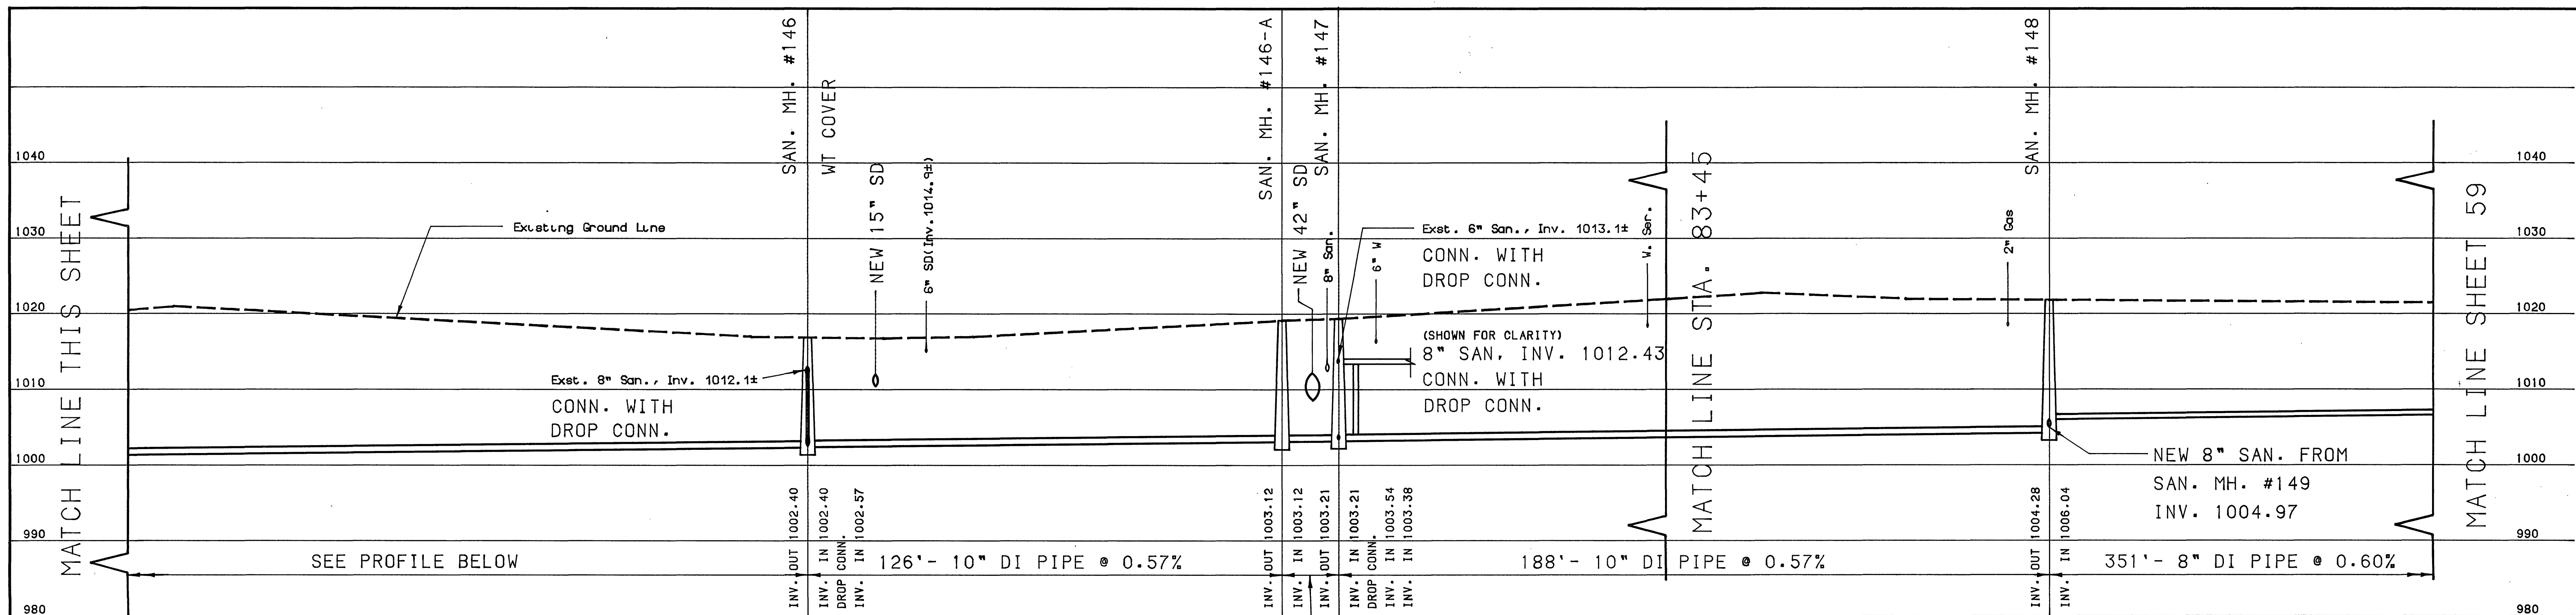

FOR PLAN SEE SHEET 38


FOR PLAN SEE SHEET 39

SCALE: HORZ. 1" = 20'
VERT. 1" = 10'

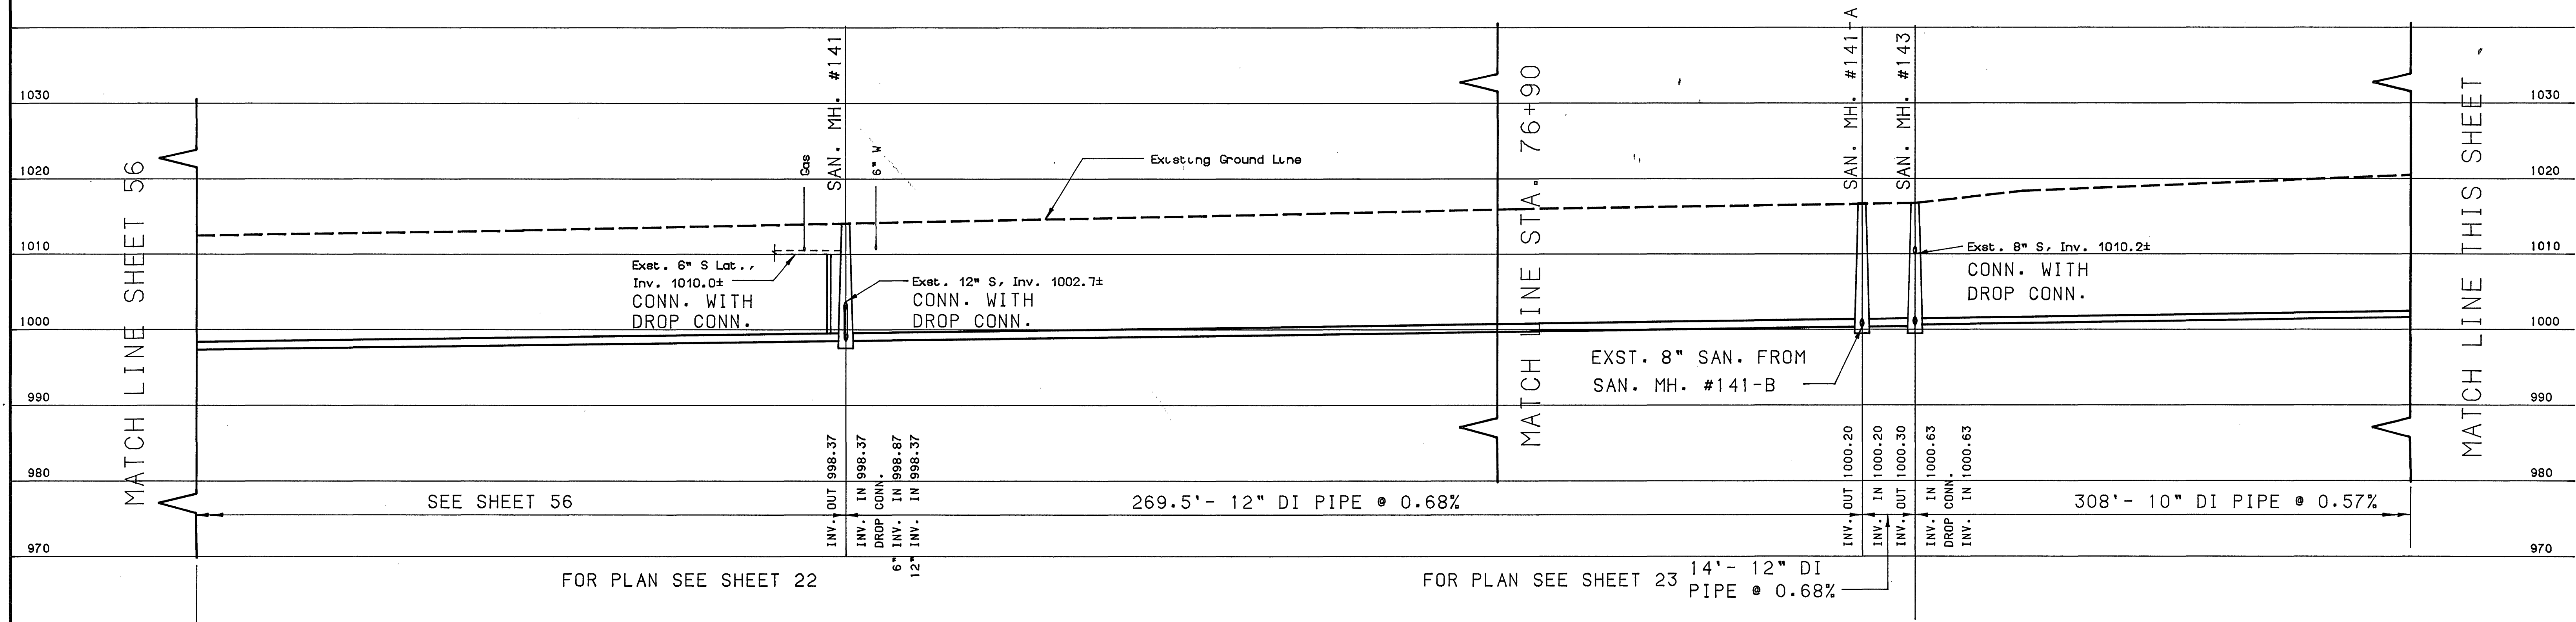

FOR PLAN SEE SHEET 22

FOR PLAN SEE SHEET 23

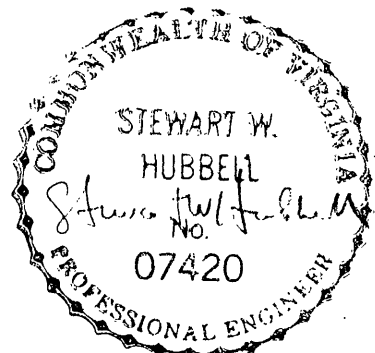 Mattern & Craig CONSULTING ENGINEERS - SURVEYORS 701 FIRST STREET, ROANOKE, VIRGINIA 24016, (703) 345-9342	DESIGNED: ARB/SWH		REVISION	DATE	DESCRIPTION	BY	APP.	DATE JULY 1987 COMM. 581	WILLIAMSON ROAD STORM DRAIN- PHASE 2 CONTRACT II-A ROANOKE, VIRGINIA PROFILE- SANITARY SEWER	SHEET
	CHECKED: GRN		DEC. 89	RECORD DRAWING	JLJ	SWH	57			
	APPROVED:									