
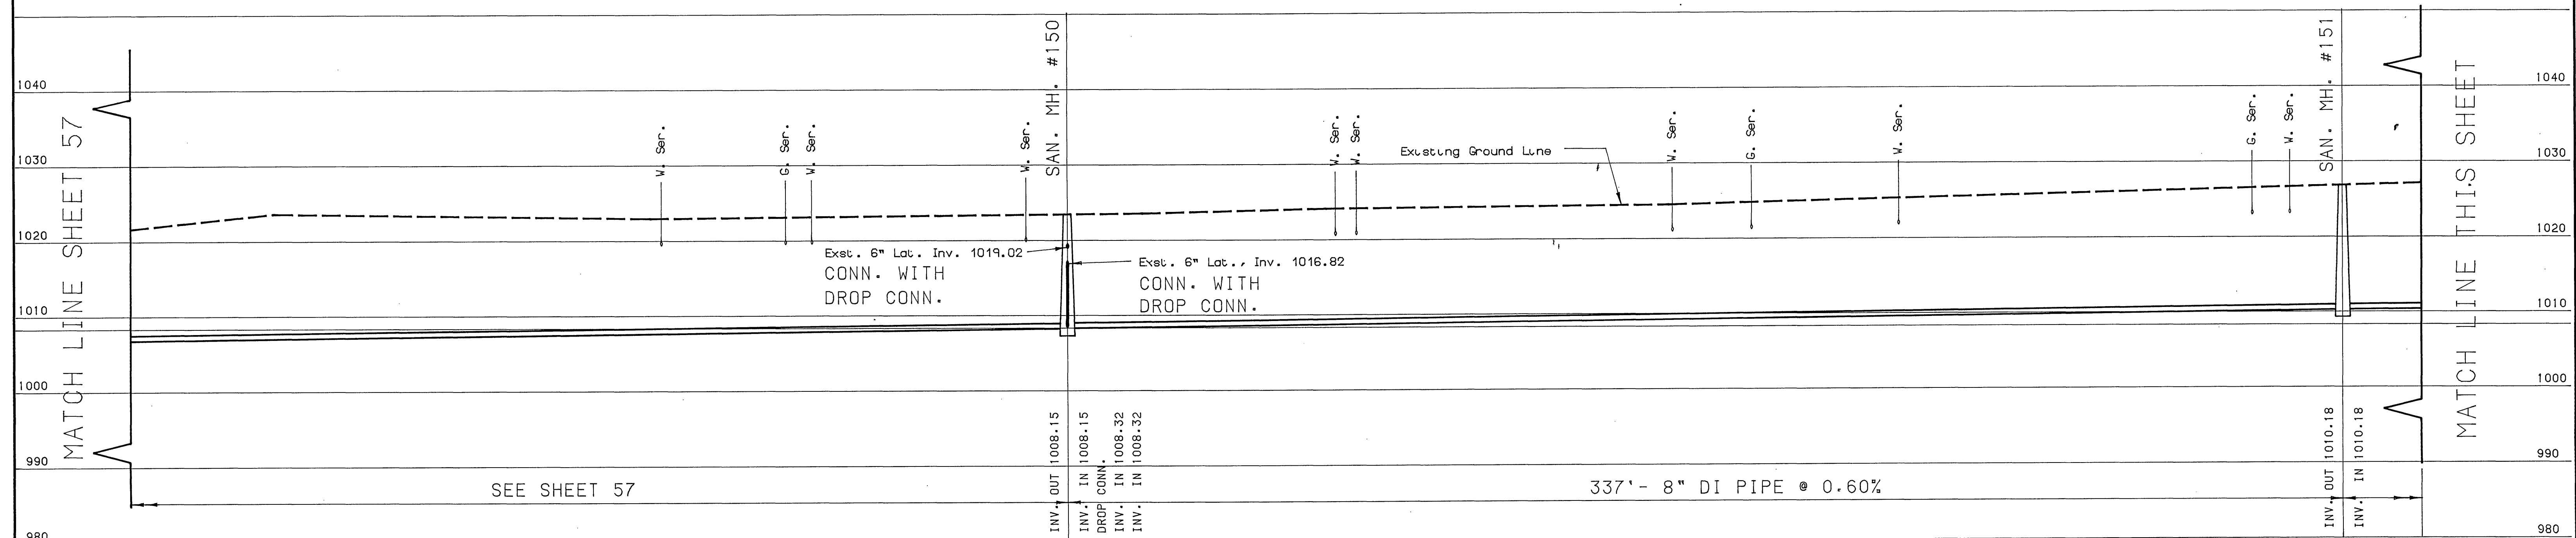
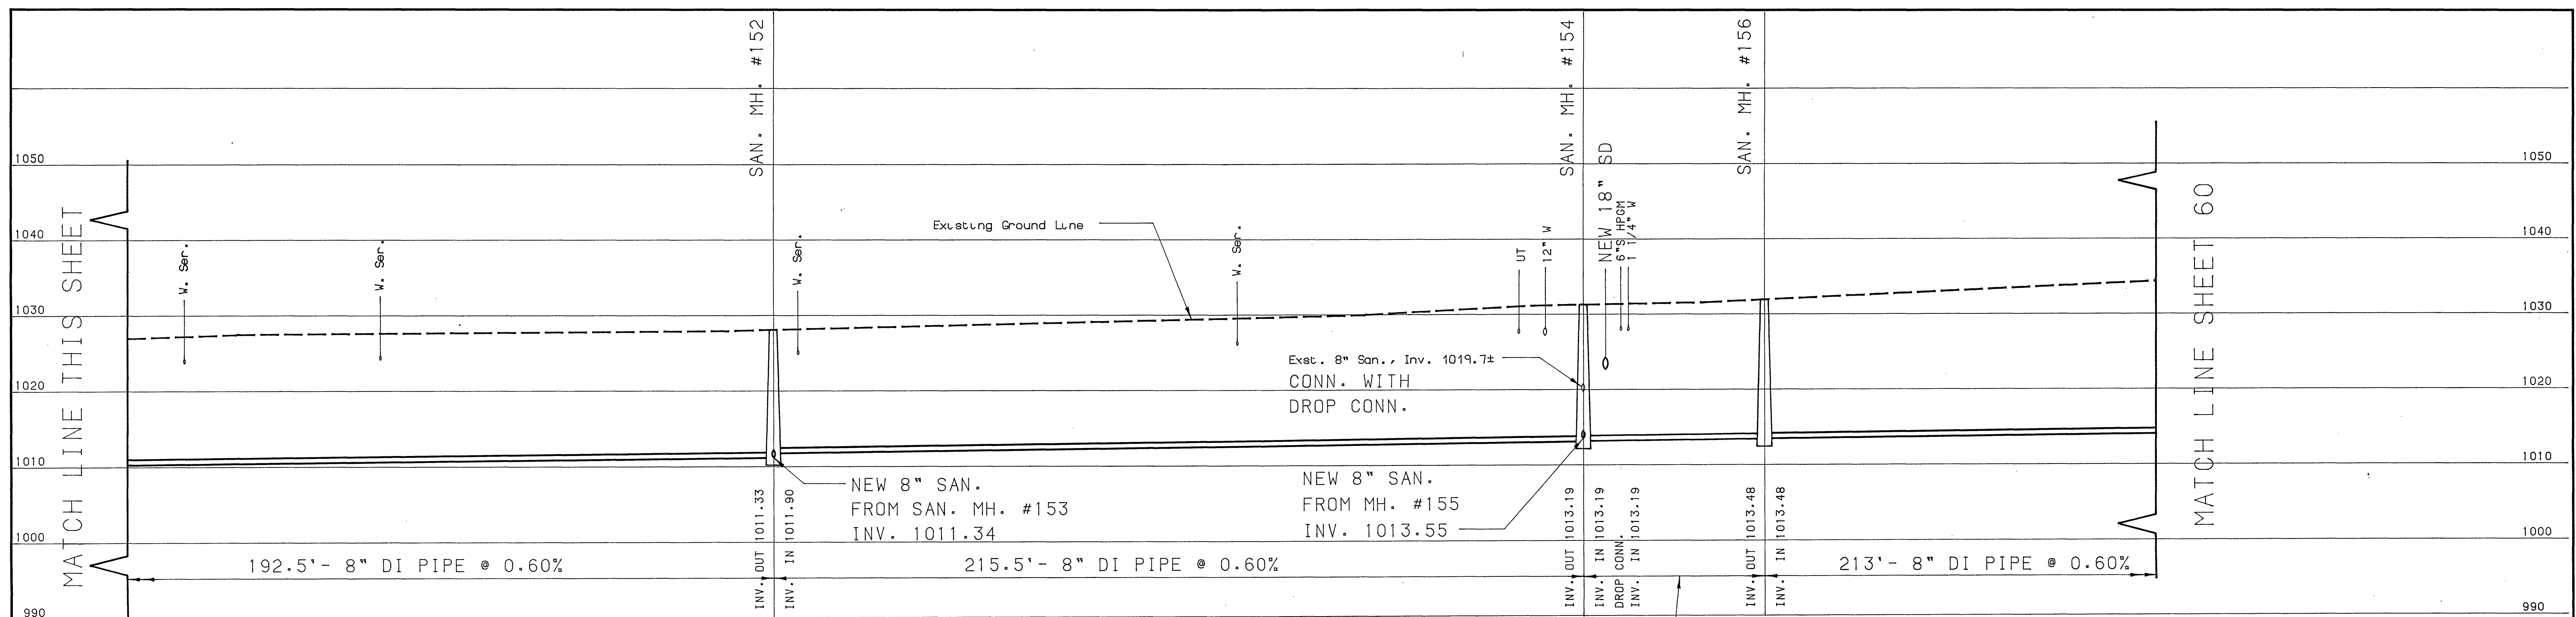
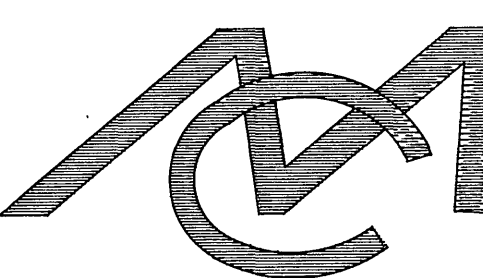


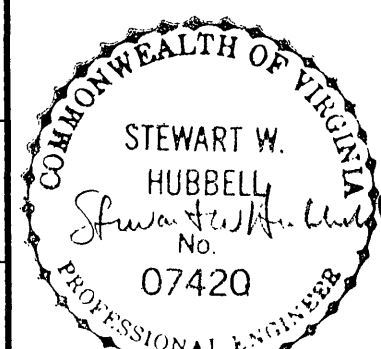

 Mattern & Craig CONSULTING ENGINEERS - SURVEYORS 701 FIRST STREET, ROANOKE, VIRGINIA 24016, (703) 345-9342		DESIGNED: ARB/SWH CHECKED: GRN APPROVED:		<table border="1"> <thead> <tr> <th>REVISION</th> <th>DATE</th> <th>DESCRIPTION</th> <th>BY</th> <th>APP.</th> </tr> </thead> <tbody> <tr> <td>1</td> <td>DEC. 89</td> <td>RECORD DRAWING</td> <td>JLJ</td> <td>SWH</td> </tr> </tbody> </table>	REVISION	DATE	DESCRIPTION	BY	APP.	1	DEC. 89	RECORD DRAWING	JLJ	SWH	DATE JULY 1987 COMM. 581	WILLIAMSON ROAD STORM DRAIN- PHASE 2 CONTRACT II-A ROANOKE, VIRGINIA PROFILE- SANITARY SEWER	SHEET 59
REVISION	DATE	DESCRIPTION	BY	APP.													
1	DEC. 89	RECORD DRAWING	JLJ	SWH													