



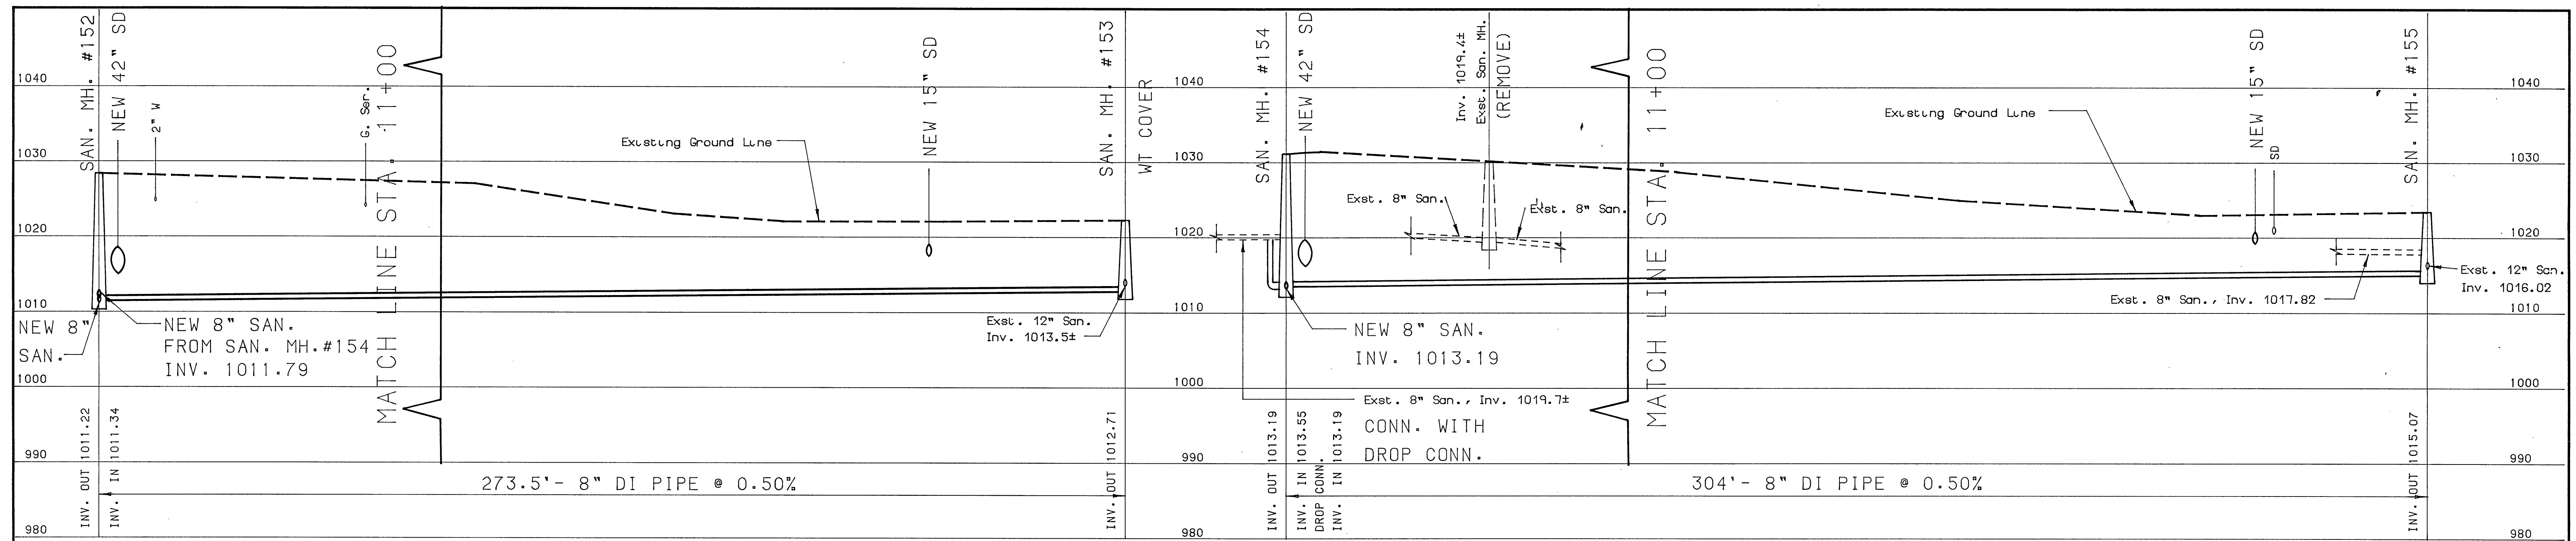

FOR PLAN SEE SHEET 41 AND 44



FOR PLAN SEE SHEET 45

SCALE: HORZ. 1" = 20'  
VERT. 1" = 10'

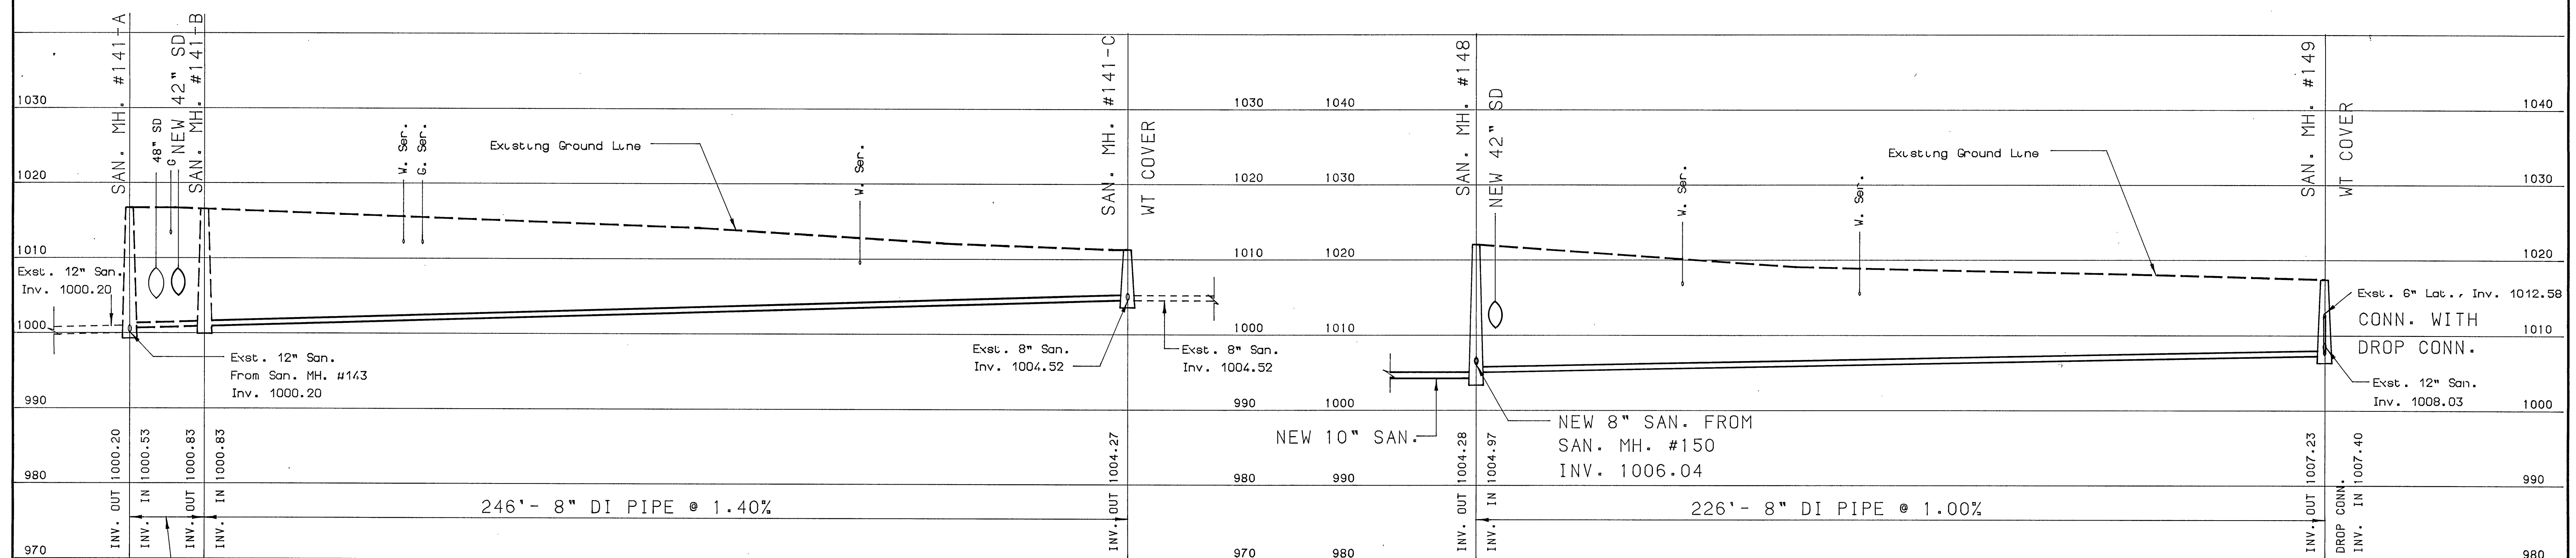

20' - 8" DI PIPE @ 1.50% FOR PLAN SEE SHEET 23

FOR PLAN SEE SHEET 39
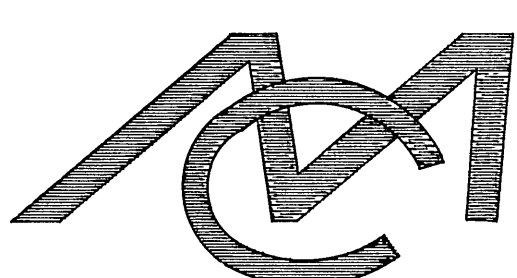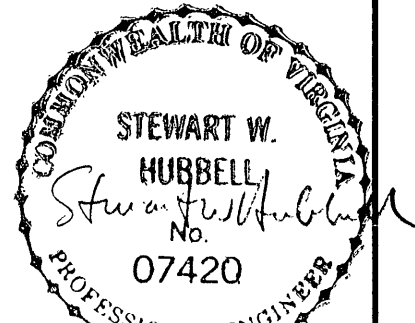
|                                                                                                                                                                                                                          |                   |                                                                                      |          |         |                |     |      |                                                 |                                                                                                       |       |
|--------------------------------------------------------------------------------------------------------------------------------------------------------------------------------------------------------------------------|-------------------|--------------------------------------------------------------------------------------|----------|---------|----------------|-----|------|-------------------------------------------------|-------------------------------------------------------------------------------------------------------|-------|
|  <p><b>Mattern &amp; Craig</b><br/>CONSULTING ENGINEERS - SURVEYORS<br/>701 FIRST STREET, ROANOKE, VIRGINIA 24016. (703) 345-9342</p> | DESIGNED: ARB/SWH |  | REVISION | DATE    | DESCRIPTION    | BY  | APP. | DATE<br><b>JULY 1987</b><br>COMM.<br><b>581</b> | WILLIAMSON ROAD STORM DRAIN- PHASE 2<br>CONTRACT II-A<br>ROANOKE, VIRGINIA<br>PROFILE- SANITARY SEWER | SHEET |
|                                                                                                                                                                                                                          | CHECKED: GRN      |                                                                                      | 1        | DEC. 89 | RECORD DRAWING | JLJ | SWH  |                                                 |                                                                                                       | 61    |
| APPROVED:                                                                                                                                                                                                                |                   |                                                                                      |          |         |                |     |      |                                                 |                                                                                                       |       |