


1938

LEGEND

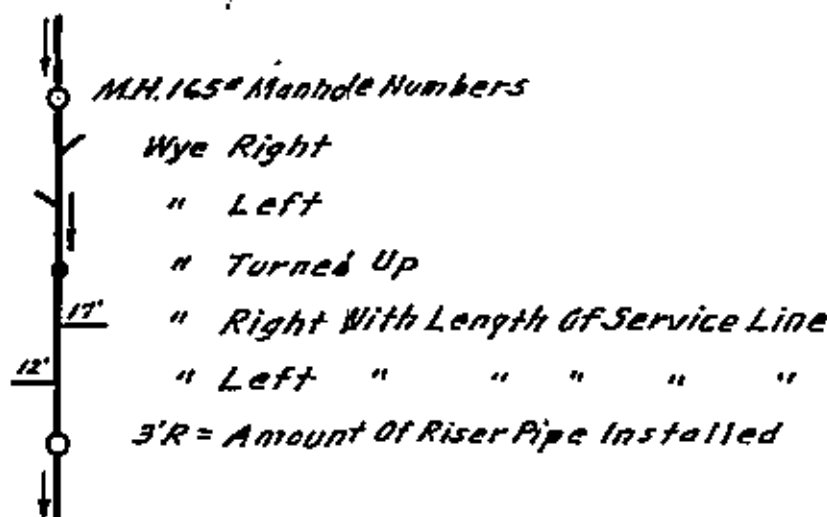

INDEX

MANHOLE NOS	1 TO 6	SHEET No	1
"	" 6 TO 8; 11 TO 16	"	" 2
"	" 16 TO 20; 22 TO 28	"	" 3
"	" 28 TO 33; 42; 44	"	" 4
"	" 42 TO 46; 53 TO 56	"	" 5
"	" 56 TO 59; 64 TO 67	"	" 6
"	" 64A; 68 TO 71; 74 TO 76	"	" 7
"	" 59 TO 63; 71 TO 73; 76 TO 78	"	" 8
"	" 46 TO 52; 56; 300	"	" 9
"	" 300; 312 TO 314; 319 TO 321; 323	"	" 10
"	" 323; 326; 331; 335; 344 TO 349	"	" 11
"	" 349; 349A; 358; 380 TO 382; 391; 392	"	" 12
"	" 382 TO 388	"	" 13
"	" 229 TO 234; 383A; 388 TO 390	"	" 14
"	" 230; 230A; 232; 235 TO 240	"	" 15
"	" 240 TO 246; 358 TO 362	"	" 16
"	" 360; 362 TO 365; 369 TO 371; 377 TO 379	"	" 17
"	" 370; 372 TO 377A	"	" 18
"	" 349 TO 355; 365 TO 368	"	" 19
"	" 311; 335; 336; 340 TO 343; 355 TO 357	"	" 20

ROANOKE COUNTY, VA