





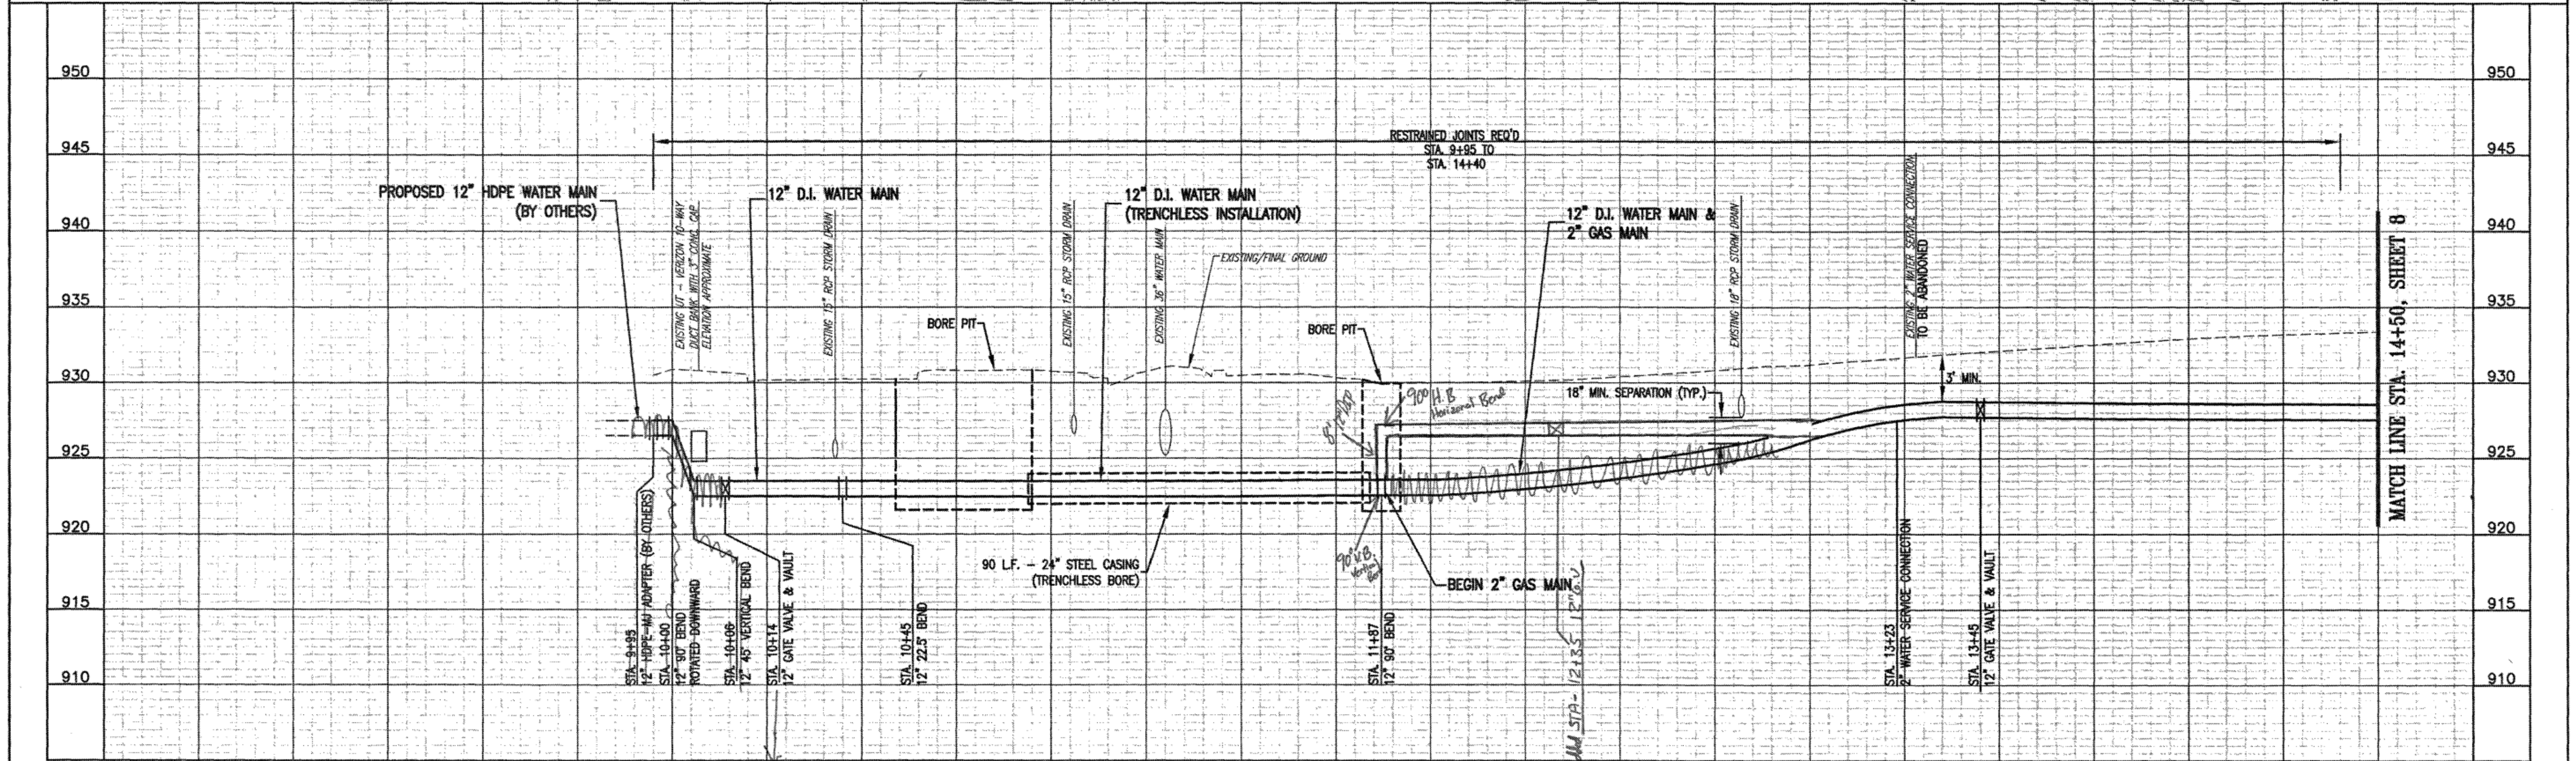

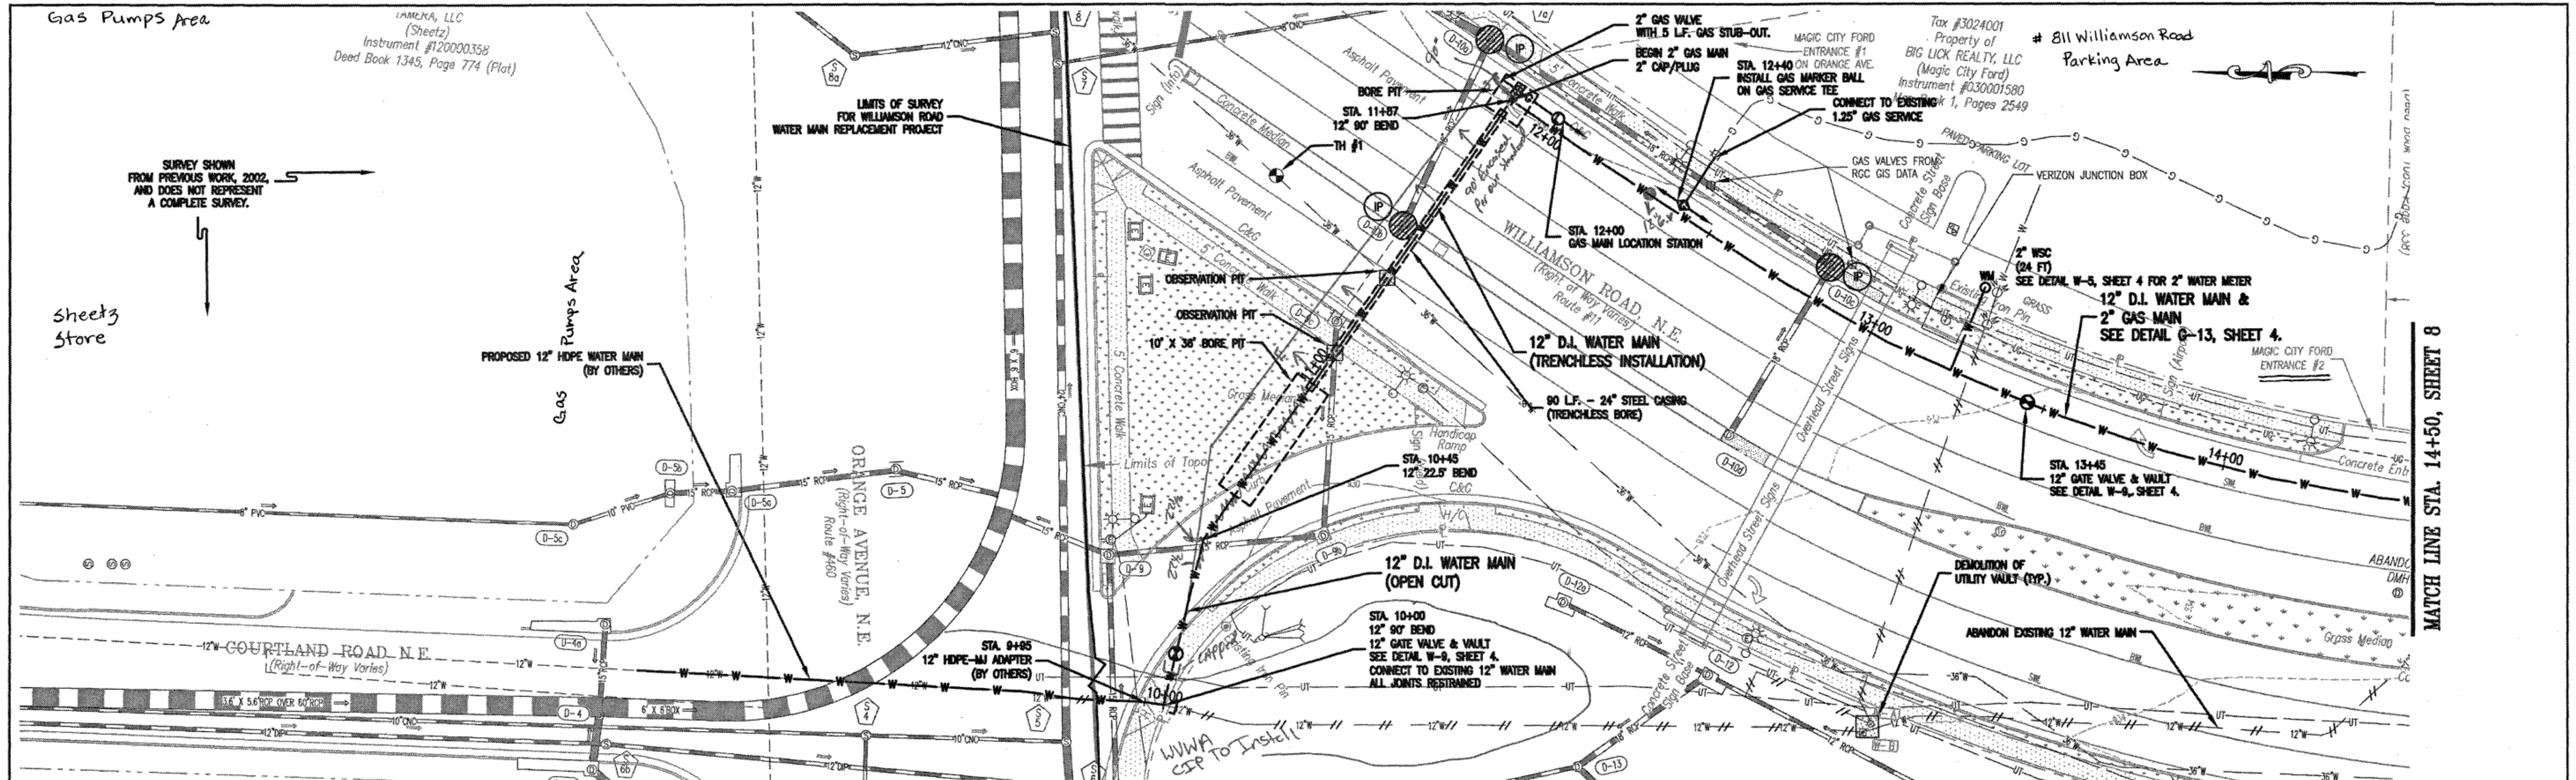

Whitman, Reardon & Associates, LLP
1700 Kraft Dr, Suite 1200, Blacksburg, VA 24060

WESTERN VIRGINIA WATER AUTHORITY
601 South Jefferson Street, Suite 300
Roanoke, Virginia 24011

DES: PJM
DRAWN: JES
CHECK: PJM
DATE: 9/02/2020

SCALE: AS SHOWN
HORIZ: 1" = 20'
VERT: 1" = 5'

**WILLIAMSON ROAD
WATER MAIN REPLACEMENT &
ROANOKE GAS COMPANY GAS MAIN REPLACEMENT**

**12" WATER MAIN PLAN - PROFILE
STA. 9+95 TO STA. 14+50**

REV	DATE	DESCRIPTION

DRAWING

—

SHEET

7