
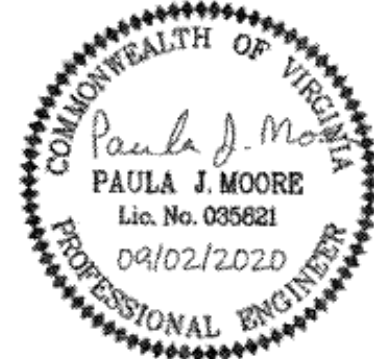
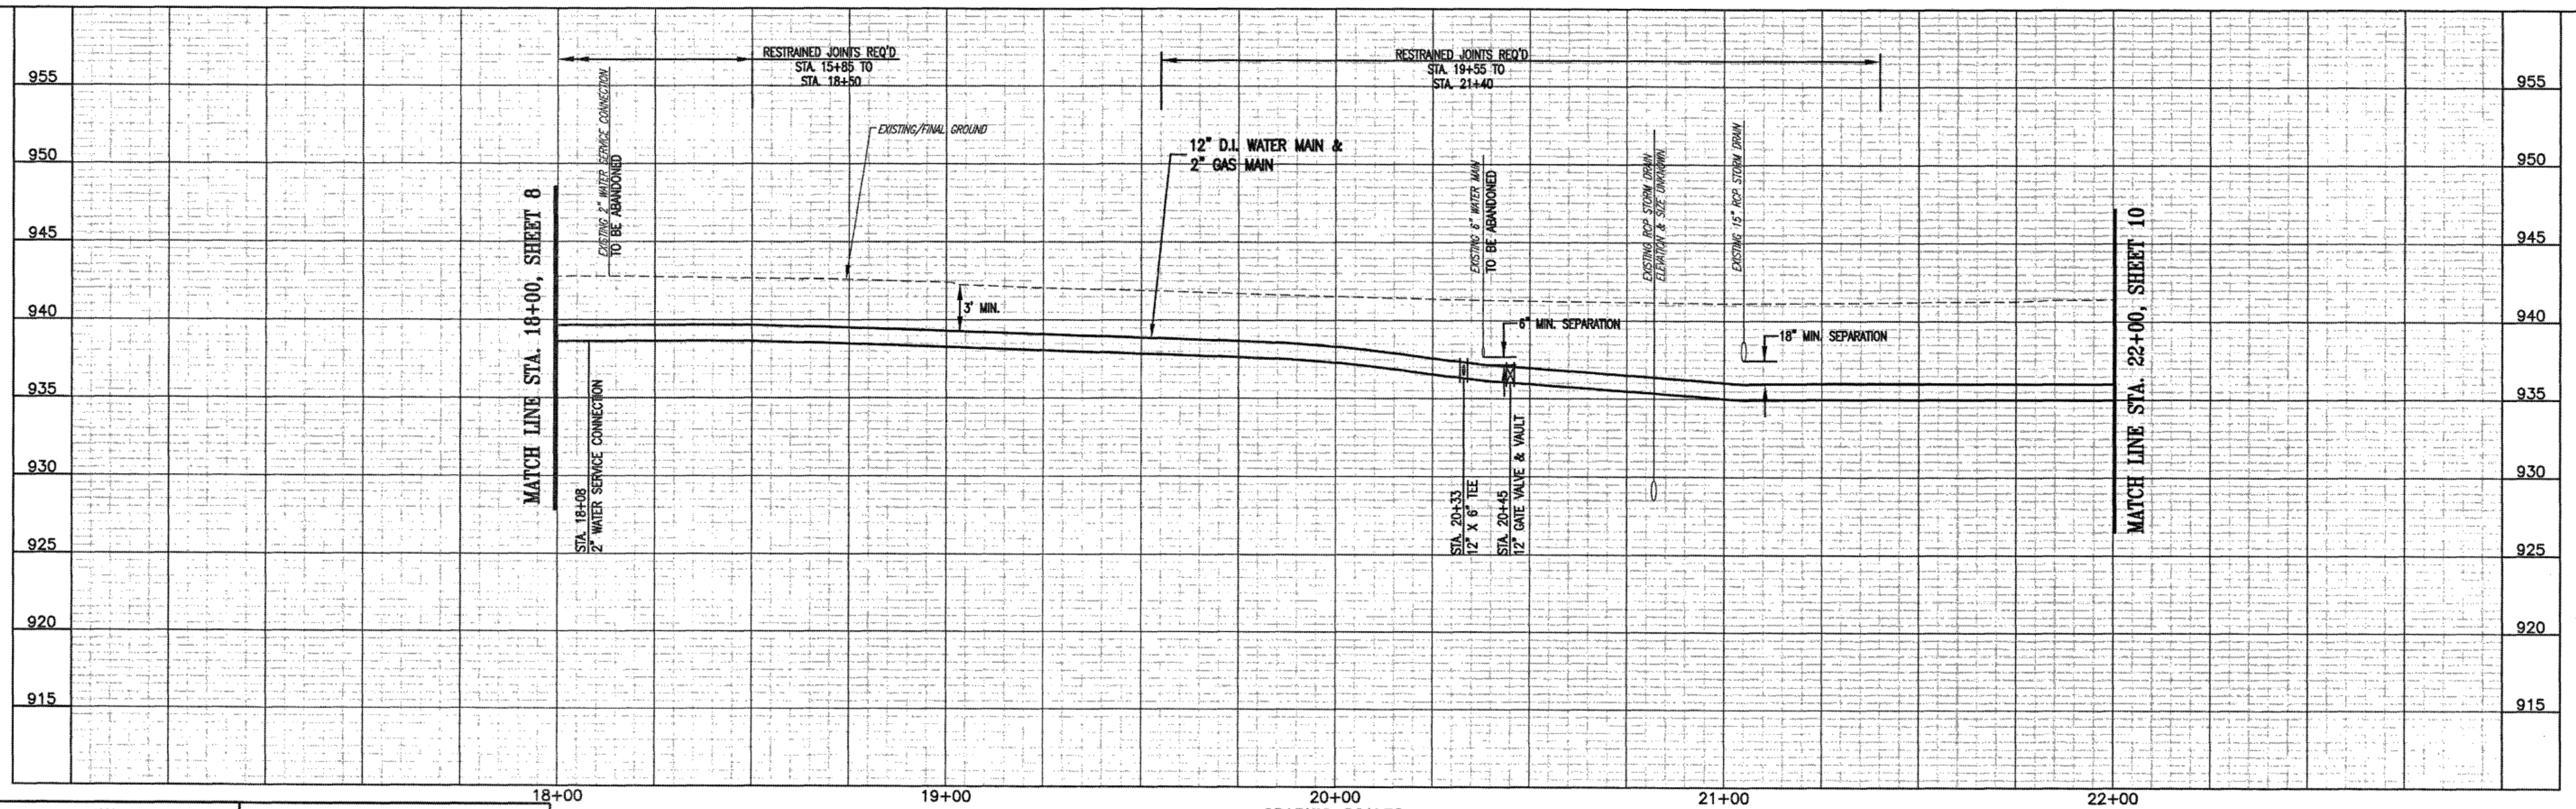


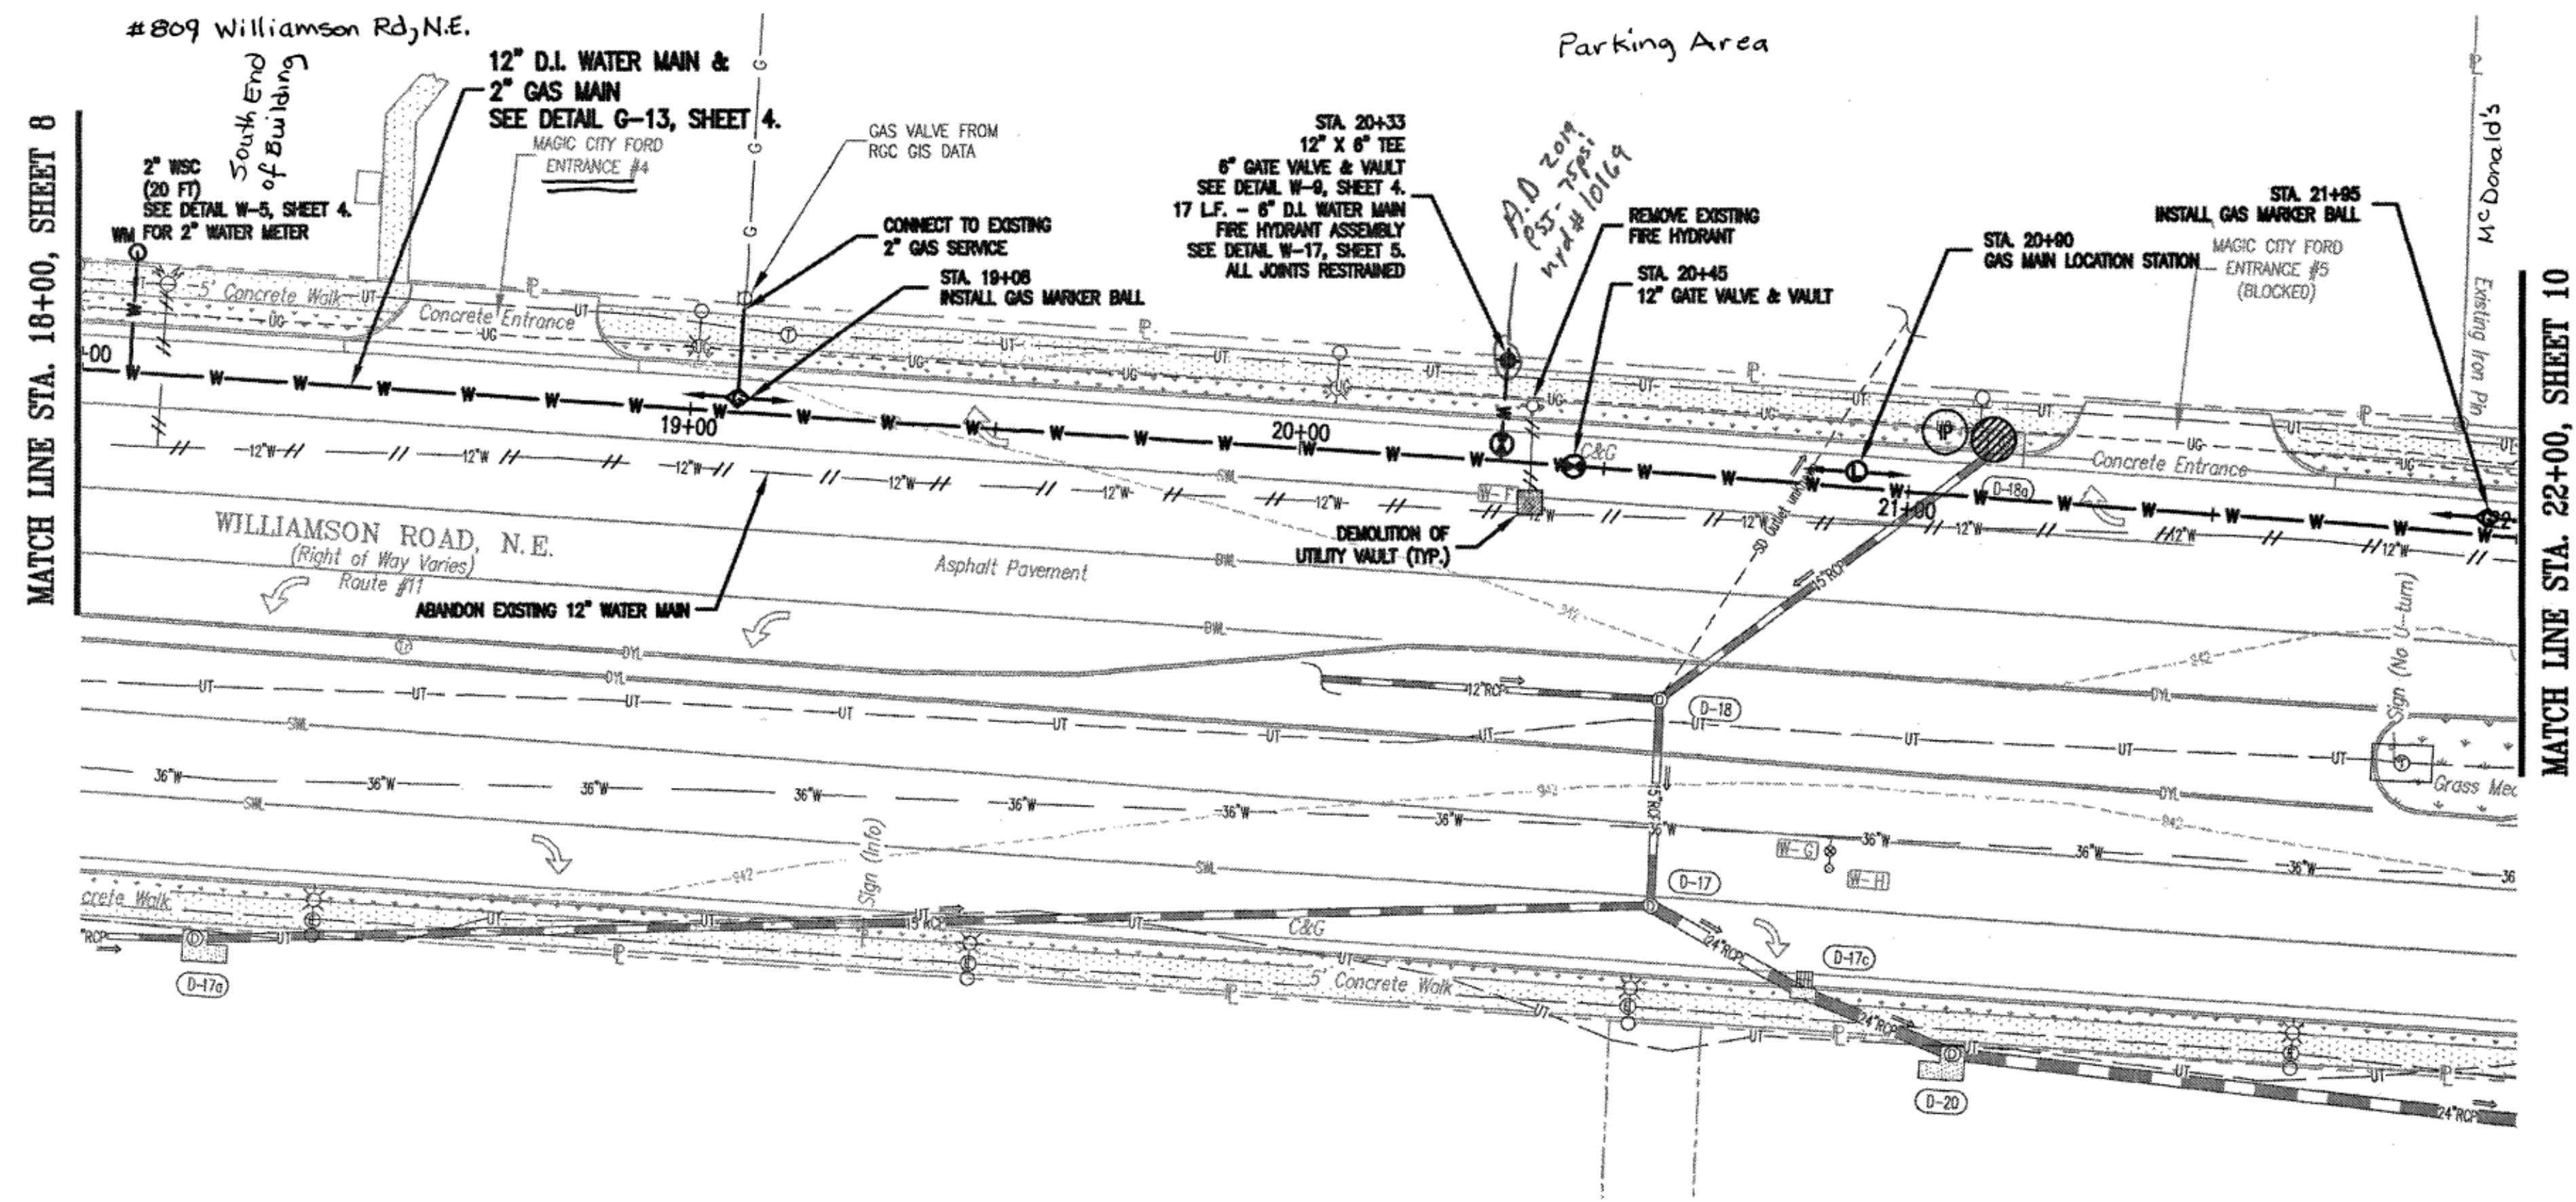

WESTERN VIRGINIA WATER AUTHORITY
601 South Jefferson Street, Suite 300
Roanoke, Virginia 24011

DES: PJM
DRAWN: JES
CHECK: PJM
DATE: 9/02/2020

SCALE: AS SHOWN
HORIZ: 1" = 20'
VERT: 1" = 5'

WILLIAMSON ROAD
WATER MAIN REPLACEMENT &
ROANOKE GAS COMPANY GAS MAIN REPLACEMENT

12" WATER MAIN PLAN - PROFILE
STA. 18+00 TO STA. 22+00

REV	DATE	DESCRIPTION	DRAWING	SHEET
			-	9