



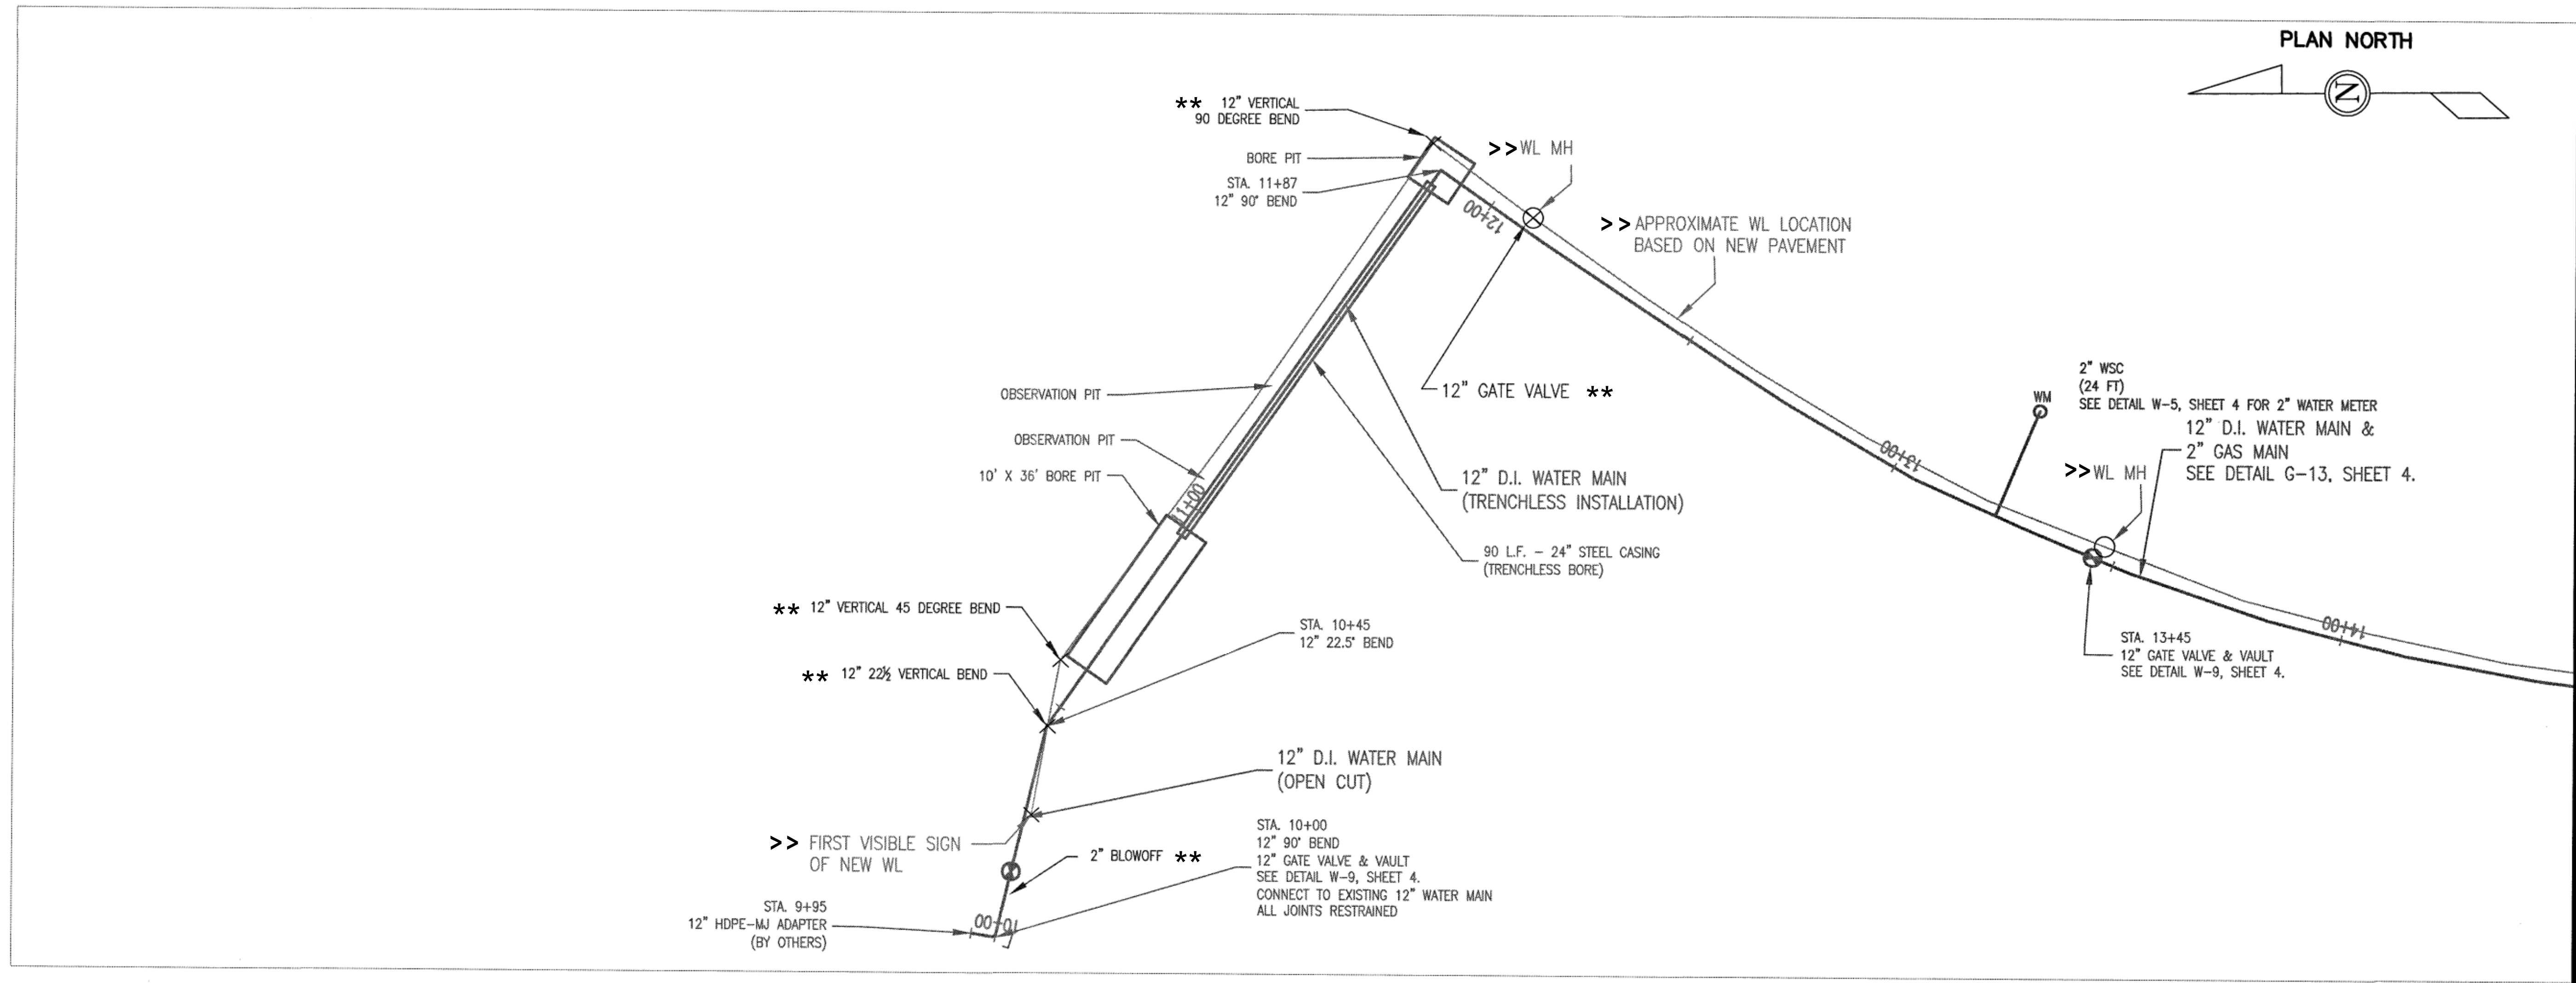

TEXT KEY :

- ** CONTRACTORS NOTES
- >> BB&A SURVEY NOTES & LINES
- ORIGINAL PLAN NOTES
- ORIGINAL PLAN NOTES

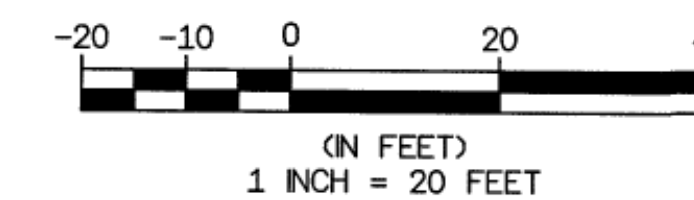

AS-BUILT

 Byer, Bennett & Associates P.L.C.	BYER, BENNETT AND ASSOCIATES, P.L.C. 4008 RINER RD, UNIT A RINER, VA 24149 (540) 381-7004	WILLIAMSON ROAD WATER MAIN REPLACEMENT AS-BUILT SURVEY	DATE 03/10/2021	REV. NO.	DATE	BY	DESCRIPTION	JOB NO. 21-03	Sheet 1 of 4
			SCALE 1" = 20'						
			CHECKED BY: DRB						
			DRAFTED BY: CAH						