



MATCH LINE, STA. 22 + 00 SHEET 3

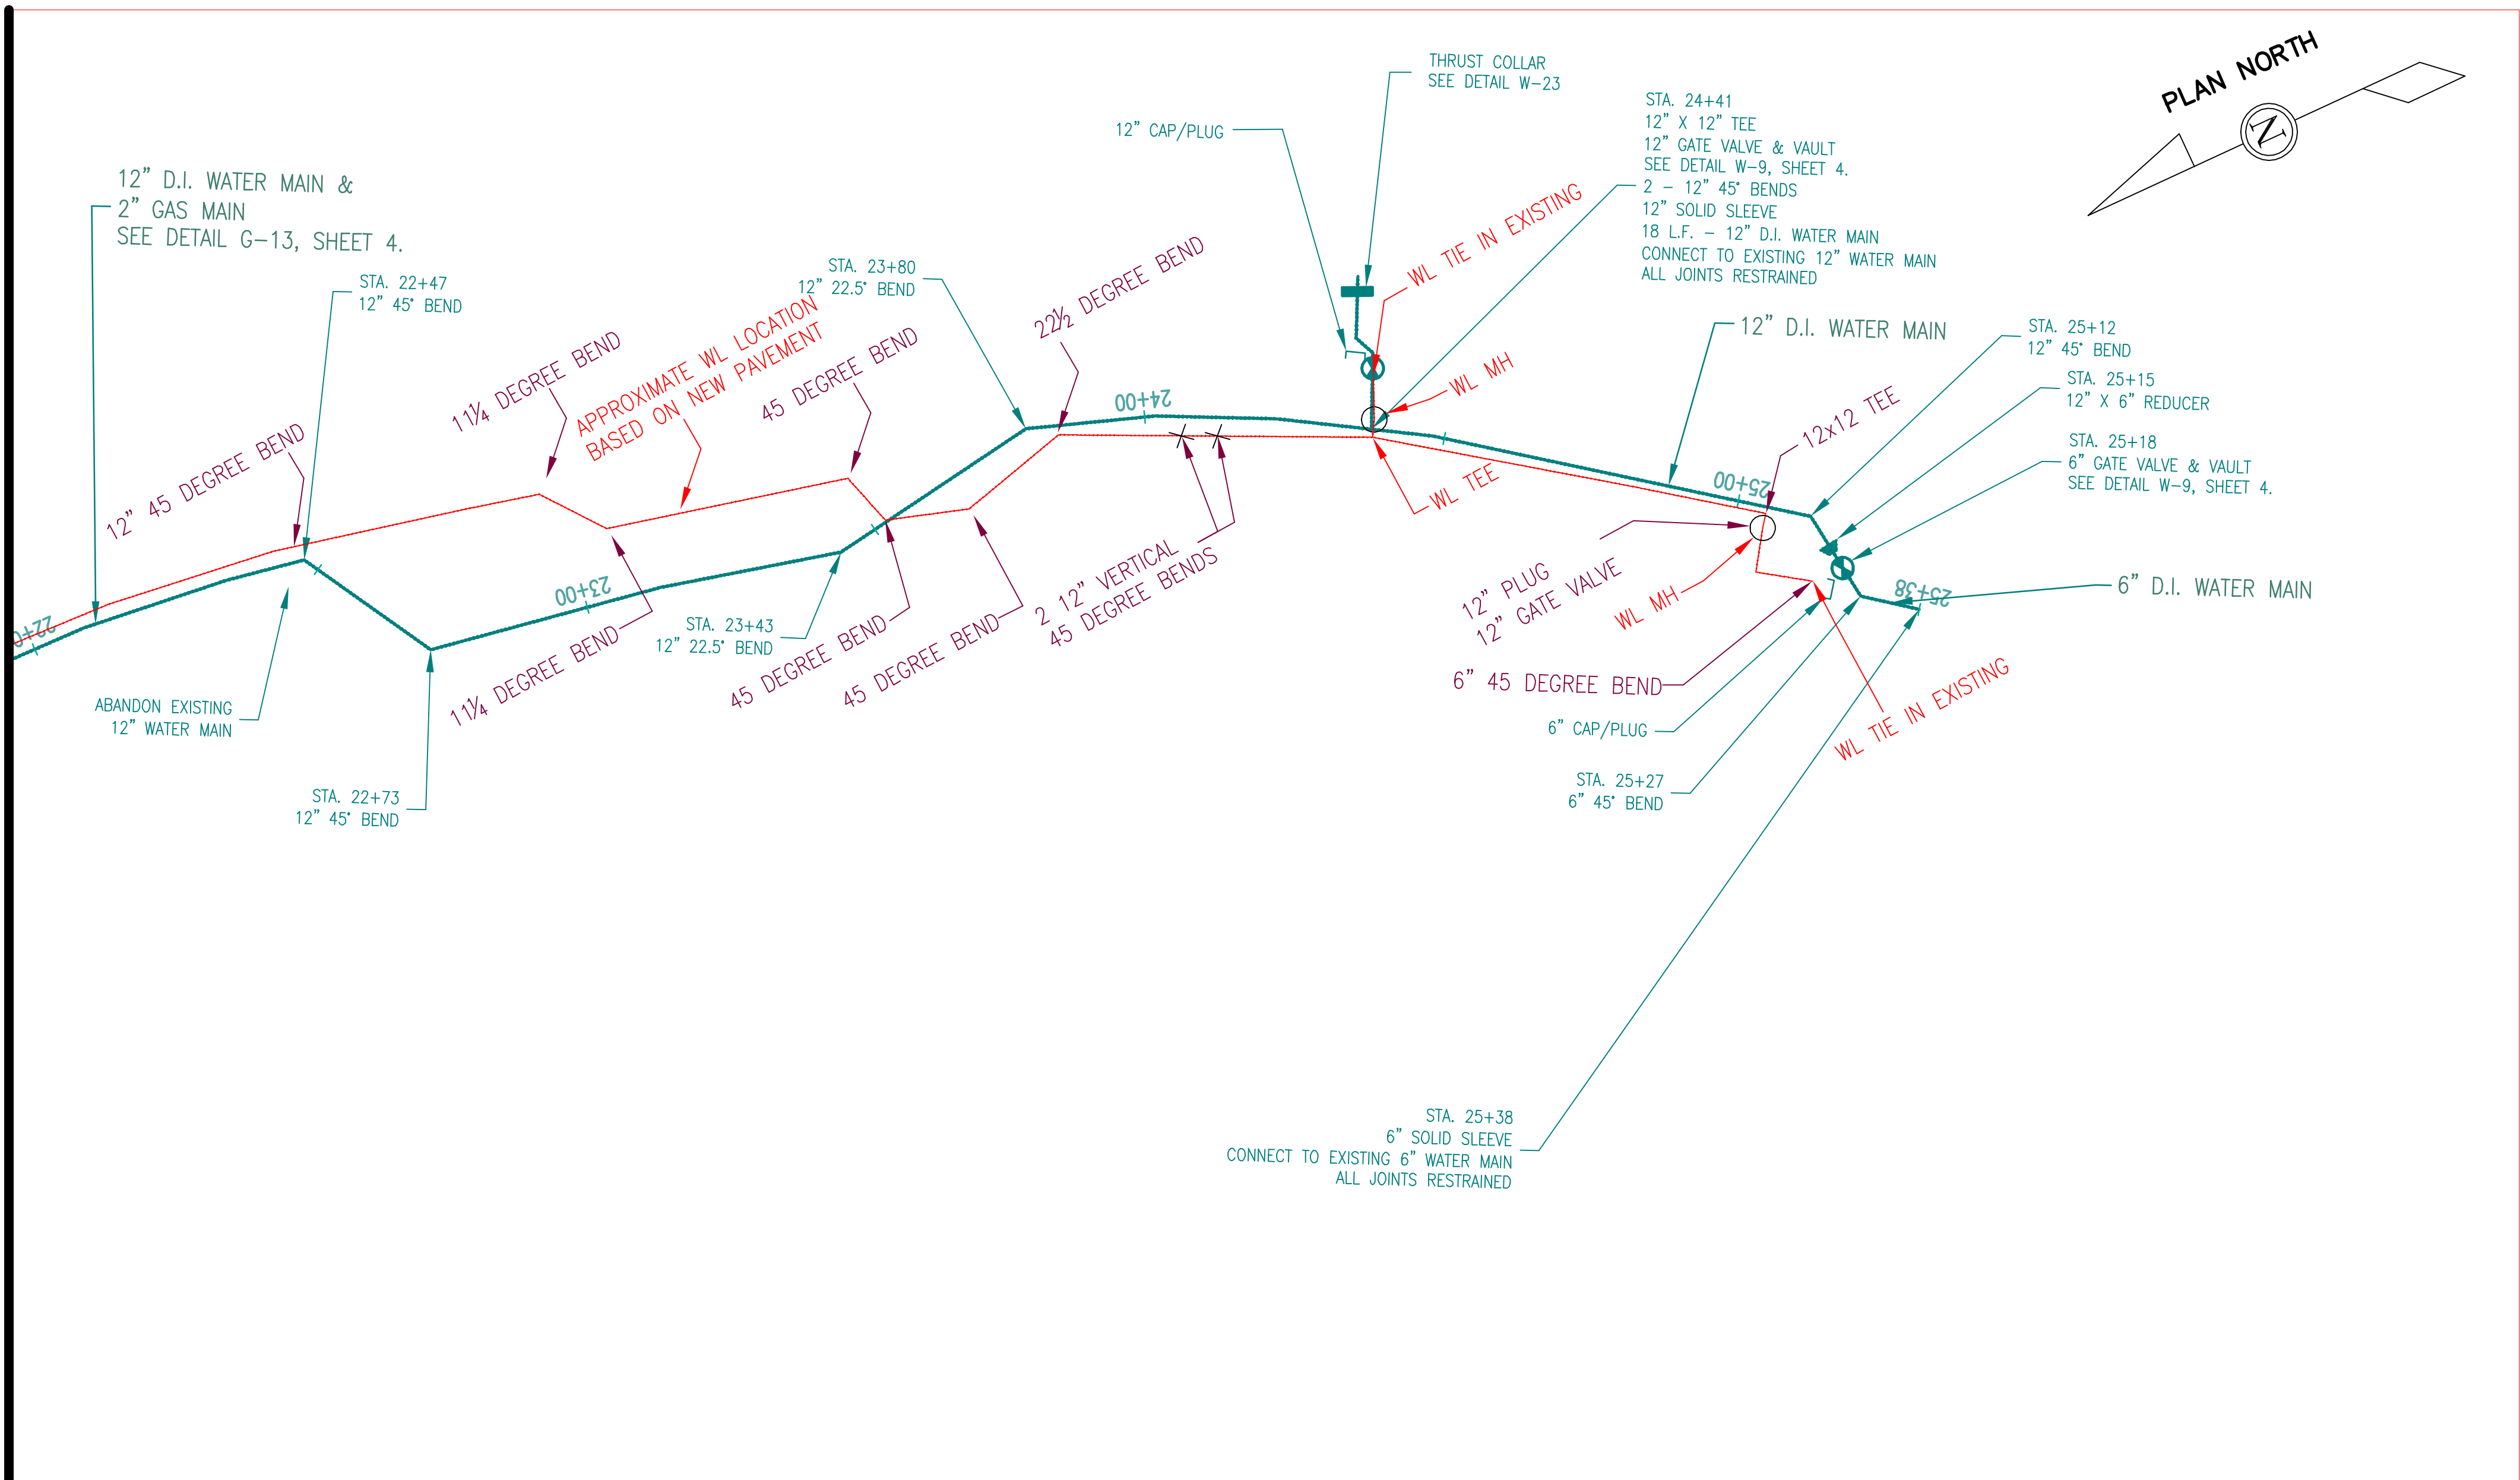

TEXT KEY:

- CONTRACTORS NOTES
- BB&A SURVEY NOTES & LINES
- ORIGINAL PLAN NOTES
- ORIGINAL PLAN NOTES

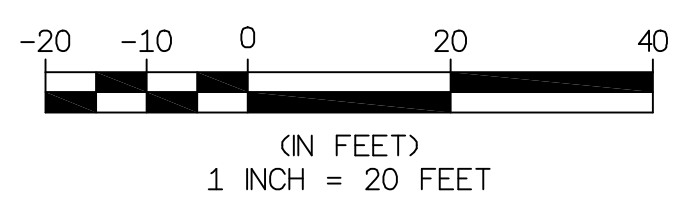

AS-BUILT



BYER, BENNETT AND ASSOCIATES, P.L.C.
4008 RINER RD, UNIT A
RINER, VA 24149
(540) 381-7004

WILLIAMSON ROAD
WATER MAIN REPLACEMENT
AS-BUILT SURVEY

DATE 03/08/2021
SCALE 1"=20'
CHECKED BY: DRB
DRAFTED BY: CAH

REV. NO.	DATE	BY	DESCRIPTION

JOB NO.
21-03

Sheet
4
of
4