



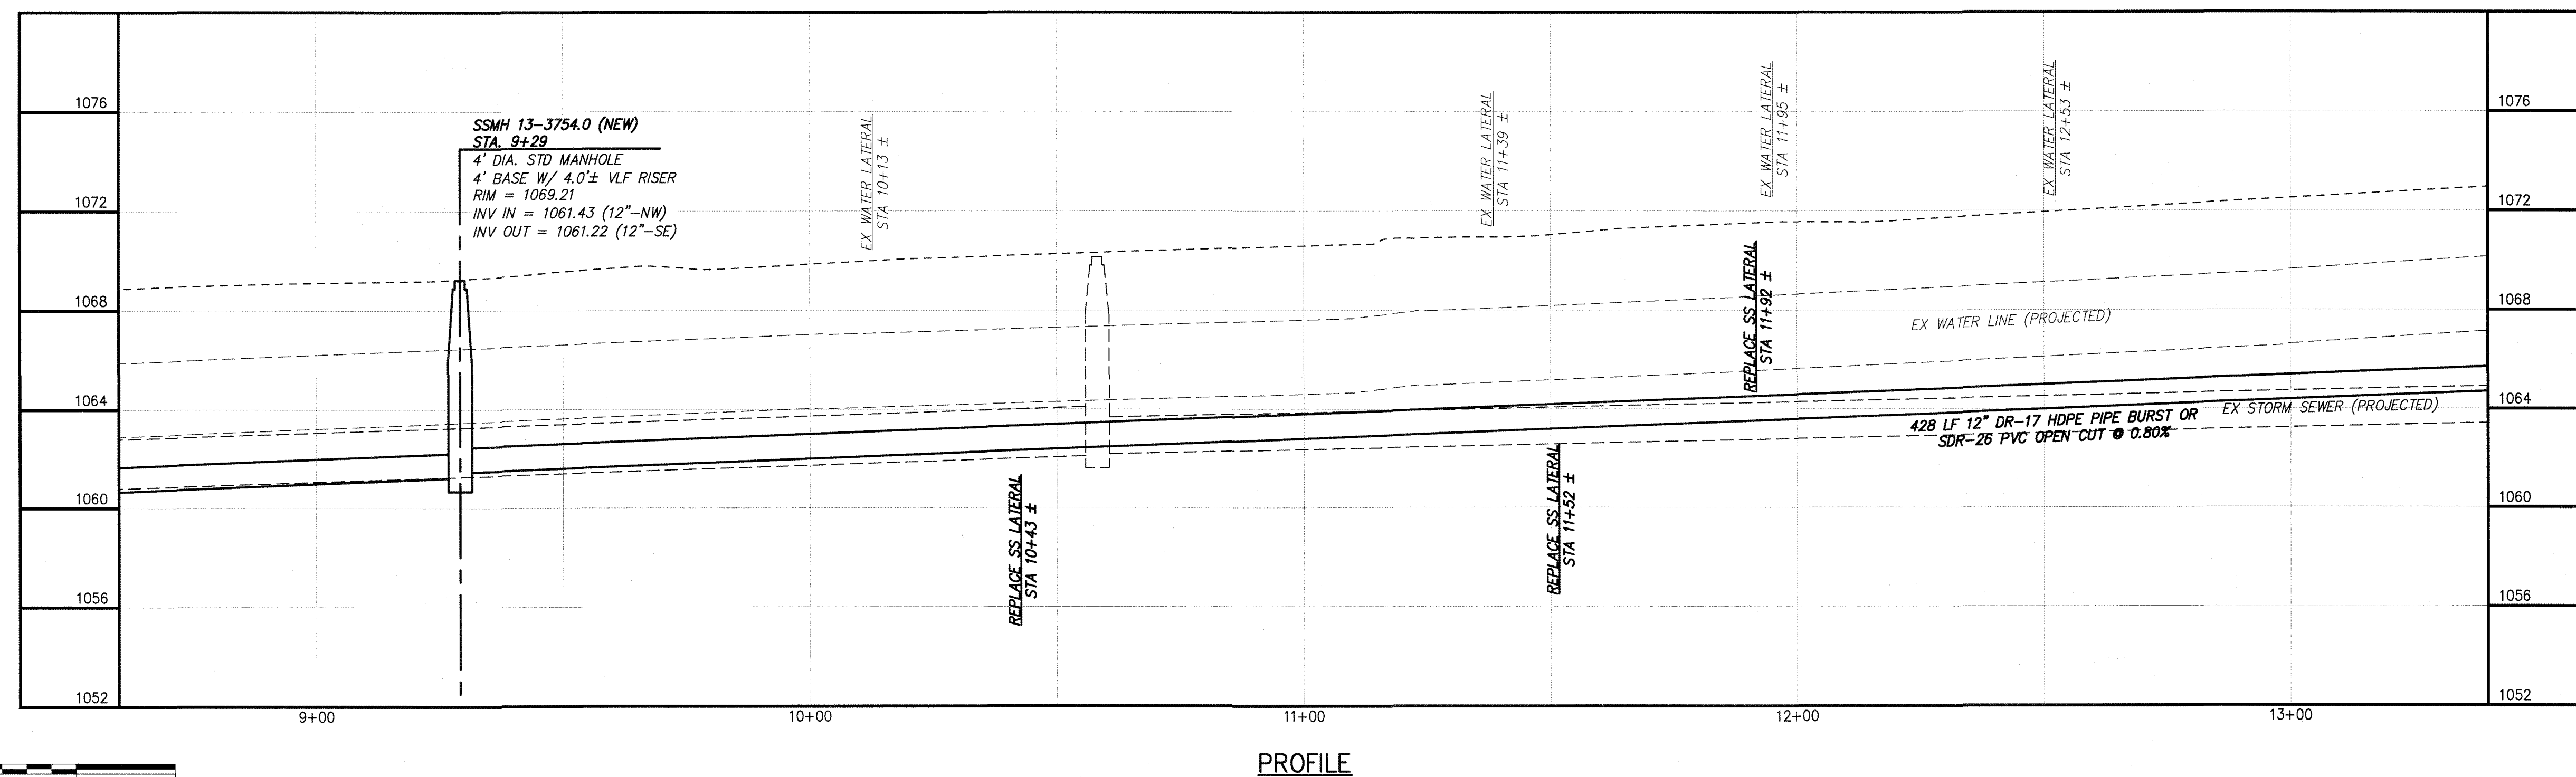

FIDELITY, LLC
INSTRUMENT NO. 010005418
4206 WILLIAMSON RD NW

HUNTER REAL ESTATE GROUP, LLC
INSTRUMENT NO. 140005399
4220 WILLIAMSON RD NW


FRALIN COMMERCIAL PROPERTIES, LLC
INSTRUMENT NO. 130001793
4226 WILLIAMSON RD NW

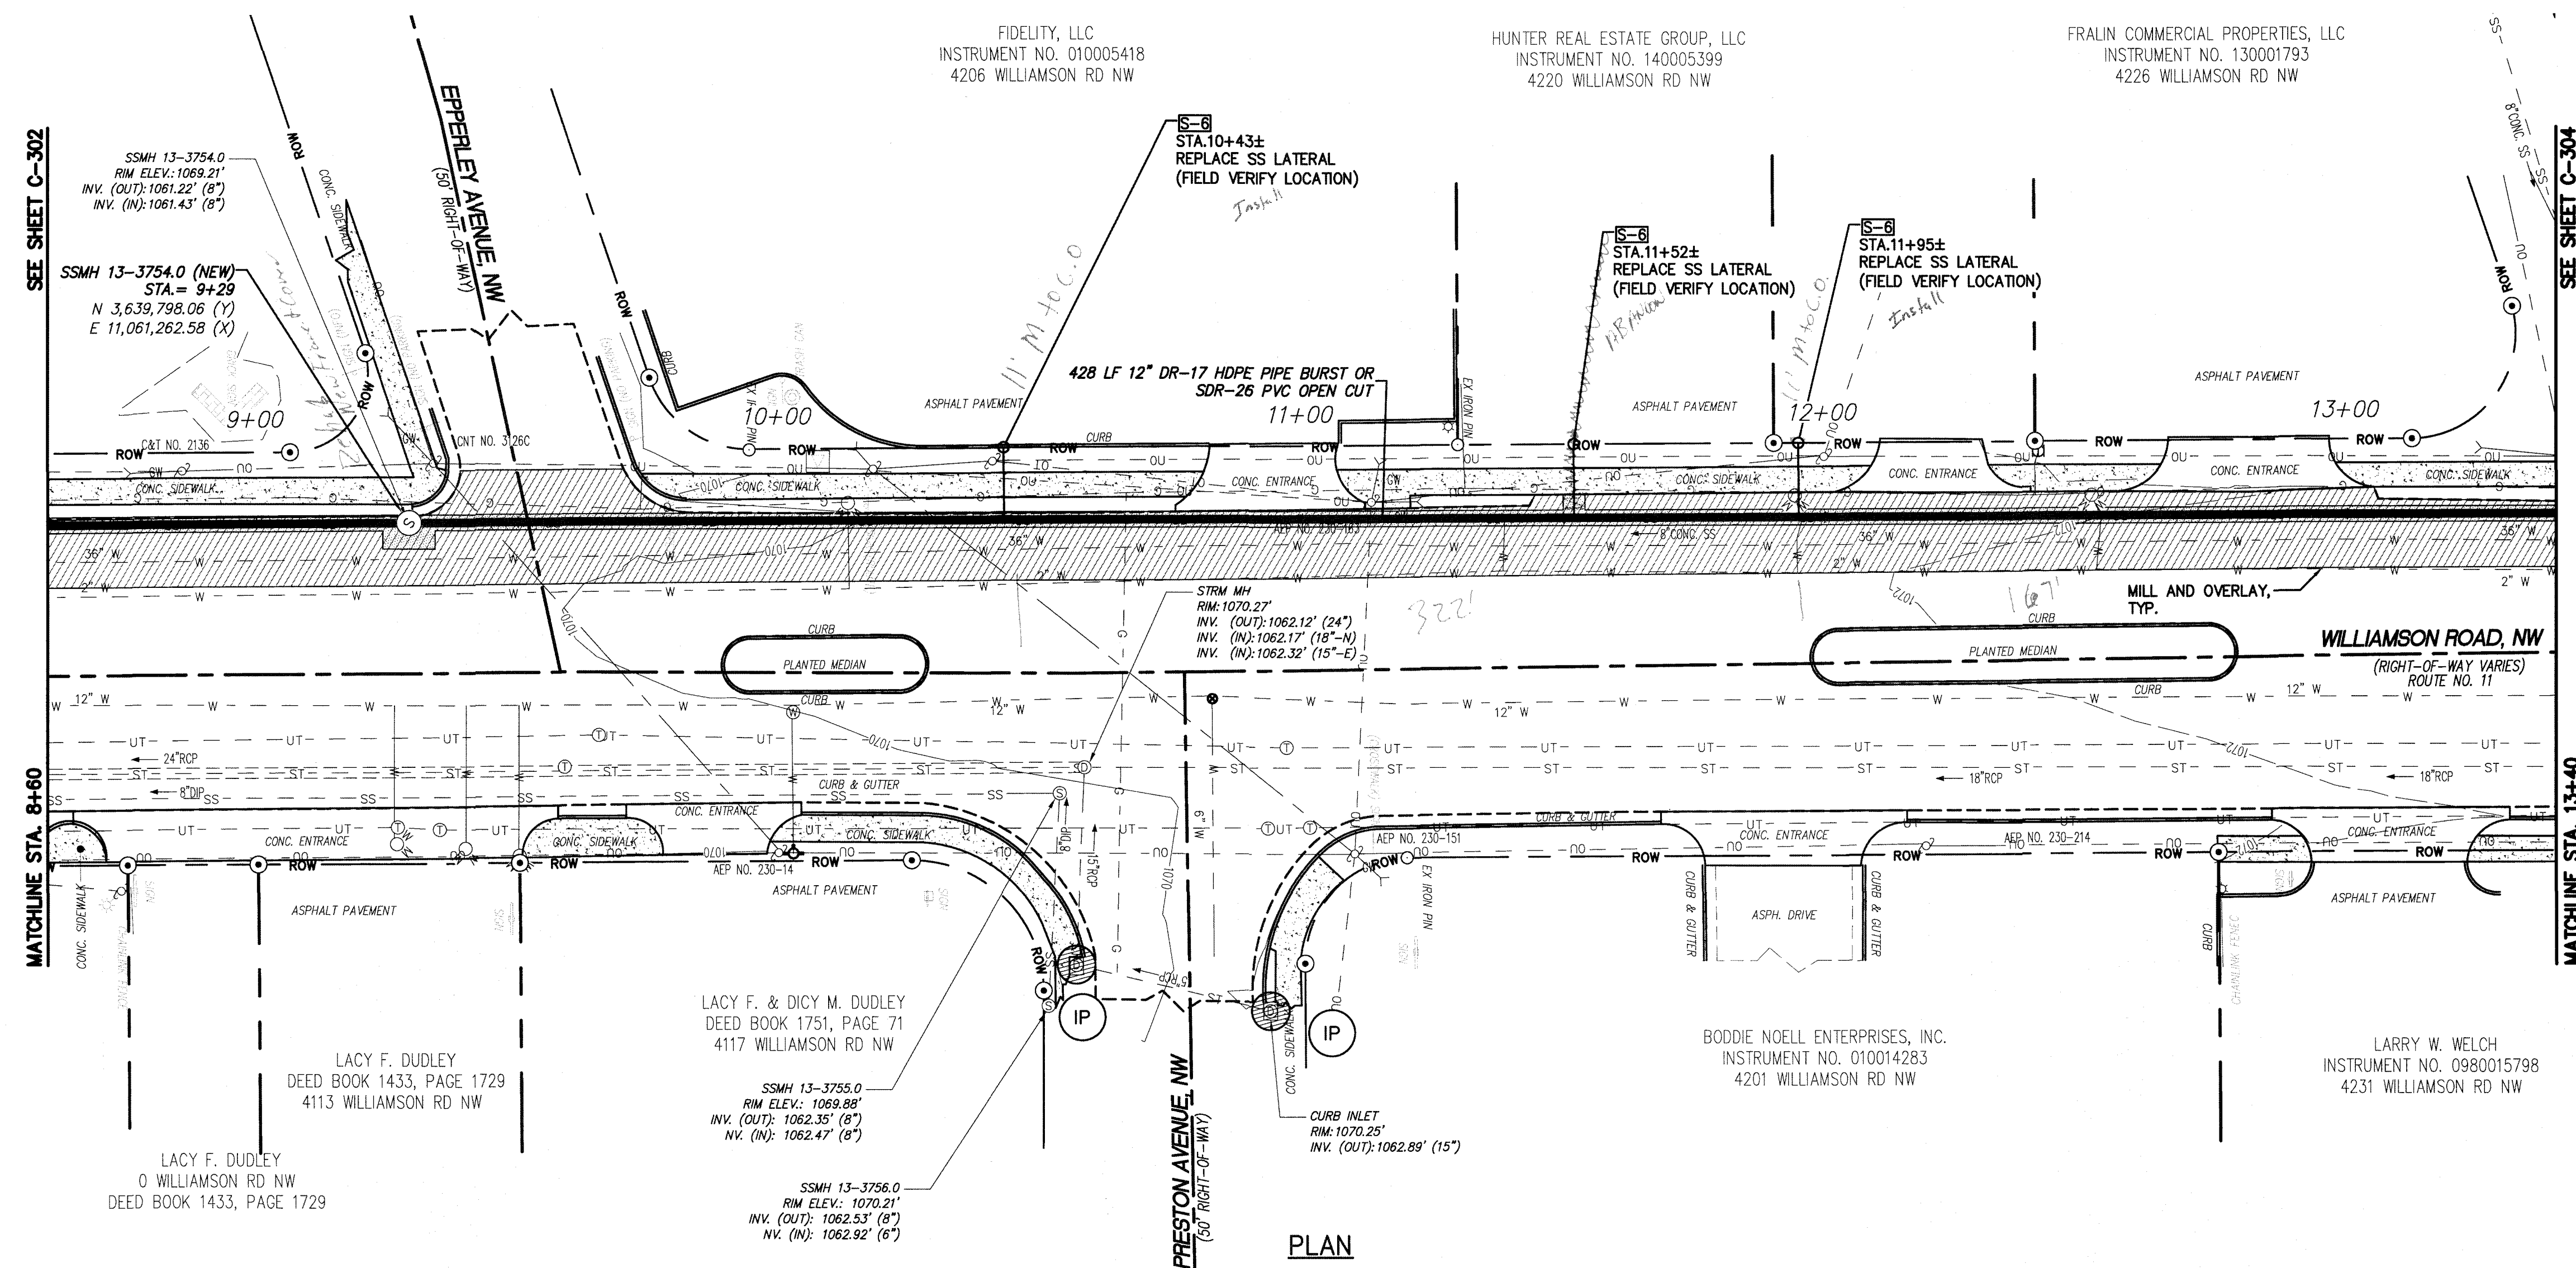


GENERAL NOTES:

- A. REFER TO SHEETS C-600 THROUGH C-605 FOR TYPICAL ROAD/LANE CLOSURE DETAILS AND REQUIREMENTS.
- B. CONTRACTOR SHALL PROVIDE BY-PASS PUMPING AS PER SPECIFICATIONS.
- C. REFER TO DETAIL S-3, SHEET C-502 FOR INSIDE DRAIN IN MANHOLE.

Revising Committee 2017

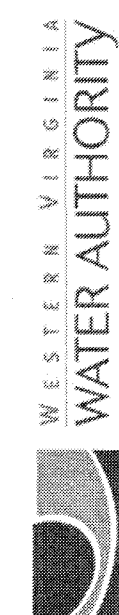

WESTERN VIRGINIA WATER AUTHORITY
ROANOKE, VIRGINIA

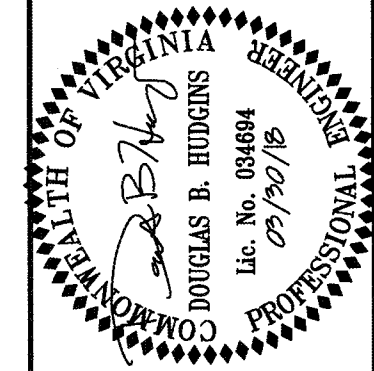

IT IS A VIOLATION OF LAW FOR ANY PERSON, UNLESS THEY ARE ACTING UNDER THE DIRECTION OF A LICENSED PROFESSIONAL ENGINEER, ARCHITECT, LANDSCAPE ARCHITECT OR LAND SURVEYOR TO ALTER AN ITEM IN ANY WAY, IF AN ITEM BEARING THE STAMP OF A LICENSED PROFESSIONAL IS ALTERED. THE ALTERING ENGINEER, ARCHITECT, LANDSCAPE ARCHITECT OR LAND SURVEYOR SHALL STAMP THE DOCUMENT AND INCLUDE THE NOTATION "ALTERED BY" FOLLOWED BY THEIR SIGNATURE, THE DATE

WESTERN VIRGINIA WATER AUTHORITY
WILLIAMSON ROAD SANITARY SEWER REPLACEMENT
ROANOKE, VIRGINIA

[illegible]WILLIAMSON ROAD
SANITARY SEWER

PLAN AND PROFILE
STA 8+60 - STA 13+40

Designed By: MBH	Drawn By: MBH	Checked By: DBH
Issue Date: 3-30-18	Project No: 33338	Scale: AS SHOWN

Drawing No.:

C-303