

JESSEE
158
13

EXISTING 48" STORM DRAIN LINE,
EXISTING 6" GAS MAIN, AND EXISTING
2" GAS MAIN SHOWN ARE BASED ON
AS-BUILT DRAWING AND NOT FIELD
VERIFIED. CONTRACTOR TO FIELD
LOCATE STORM DRAIN LINE AND GAS
LINES PRIOR TO CONSTRUCTING
PROPOSED SEWER MAIN TO ALLOW FOR
FIELD ADJUSTMENTS TO SEWER
ALIGNMENT.

Concrete Wall
w/Rail

PROPOSED 6" SAN.
SEWER LATERAL
CONNECT TO EXIST.
SAN. SEWER LATERAL

ABANDON AND PLUG EXIST. 8"
SAN. SEWER PIPE IN PLACE
SEE DETAIL S-15 ON SHEET 6

Sign on
pole Post

Conc. Curb

Concrete Wall
w/Rail

PROPOSED 6" SAN.
SEWER LATERAL
CONNECT TO EXIST.
SAN. SEWER LATERAL

ABANDON AND PLUG EXIST. 8"
SAN. SEWER PIPE IN PLACE
SEE DETAIL S-15 ON SHEET 6

Sign on
pole Post

Conc. Curb

CONTRACTOR TO INSTALL THIS RUN OF
PIPE BY HORIZONTAL DIRECTIONAL DRILL (HDD)
WORK TO BE PERFORMED DURING EVENING HOURS

HORIZONTAL DIRECTIONAL DRILL (HDD) PIT

CORE EXIST. SAN. SEWER MANHOLE
CONNECT PROP. SAN. SEWER PIPE
TO EXIST. MANHOLE #3

ABANDON AND PLUG EXIST. 8"
SAN. SEWER PIPE IN PLACE
SEE DETAIL S-15 ON SHEET 6

CONTRACTOR TO ABANDON
EXIST. SAN. SEWER MANHOLES
SEE DETAIL S-16 ON SHEET 6.
CONNECTED NEW 6"S TO EXIST.
6"S WITH 6" HYMAX COUPLING

Benchmark:
Chiseled Square on
Corner of Drop Inlet
Elev. = 1097.72'

Sanitary Sewer Easement
M.B. 1 Pg. 1941

Conc. Curb

Sidewalk

Conc. Curb

Sidewalk

WILLIAMSON ROAD N.W.
(80' R/W)


XIAO JI QI
Instr. No. 030009783
Tax No. 2170137

THIRTY THREE EAST INC.
D.B. 1614 Pg. 1184
Tax No. 2170138



SURVEY BASELINE
S35°12'53"E 482.48'

MATCHLINE SANITARY SEWER STA. 15+00
SEE SHEET 4

SANITARY SEWER PROFILE

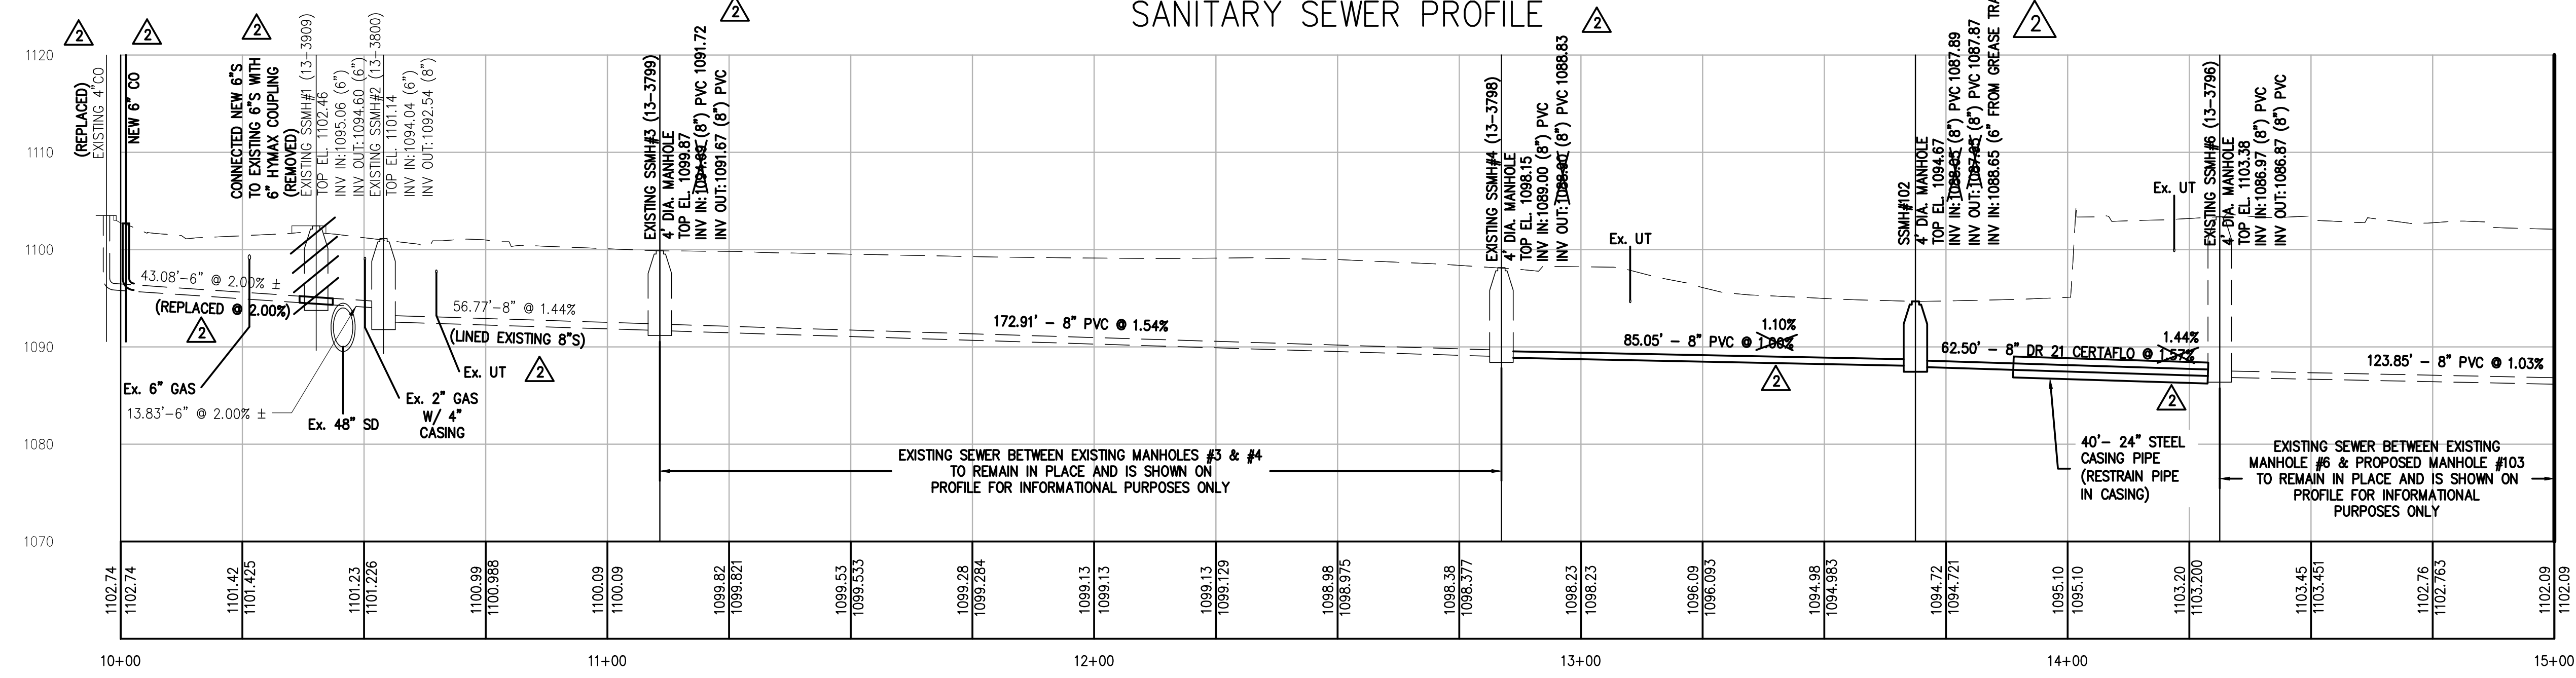

RECORD DRAWING

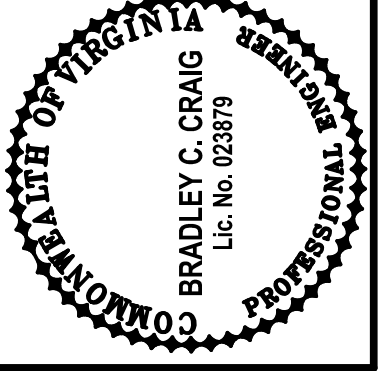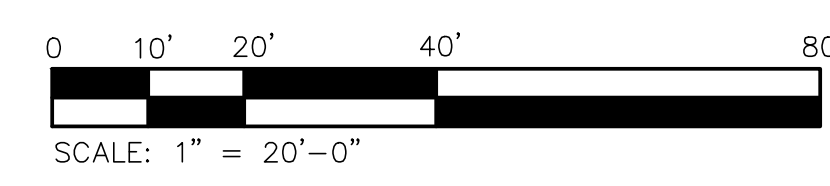

Revisions	Date
1 CHANGES BASED ON CONTRACTOR NEGOTIATIONS	11/8/2013
2 RECORD DRAWING	08/29/14

Issue Date:	JUNE 13, 2013
Drawn By:	JEF
Designed By:	BCC/JEF
Checked By:	BCC
Date:	10/31/2012

Mattern & Craig
CONSULTING ENGINEERS • SURVEYORS
701 FIRST STREET, S.W.
ROANOKE, VIRGINIA 24016
(540) 345-9342
FAX (540) 345-7691

WILLIAMSON ROAD SEWER REPLACEMENT - 4800 BLOCK
WESTERN VIRGINIA WATER AUTHORITY
PLAN & PROFILE
CITY OF ROANOKE, VIRGINIA

Vertical Scale:
1" = 10'
Horizontal Scale:
1" = 20'
Commission Number:
3228
Sheet No.: