




MATCHLINE SANITARY SEWER STA. 15+00
SEE SHEET 3

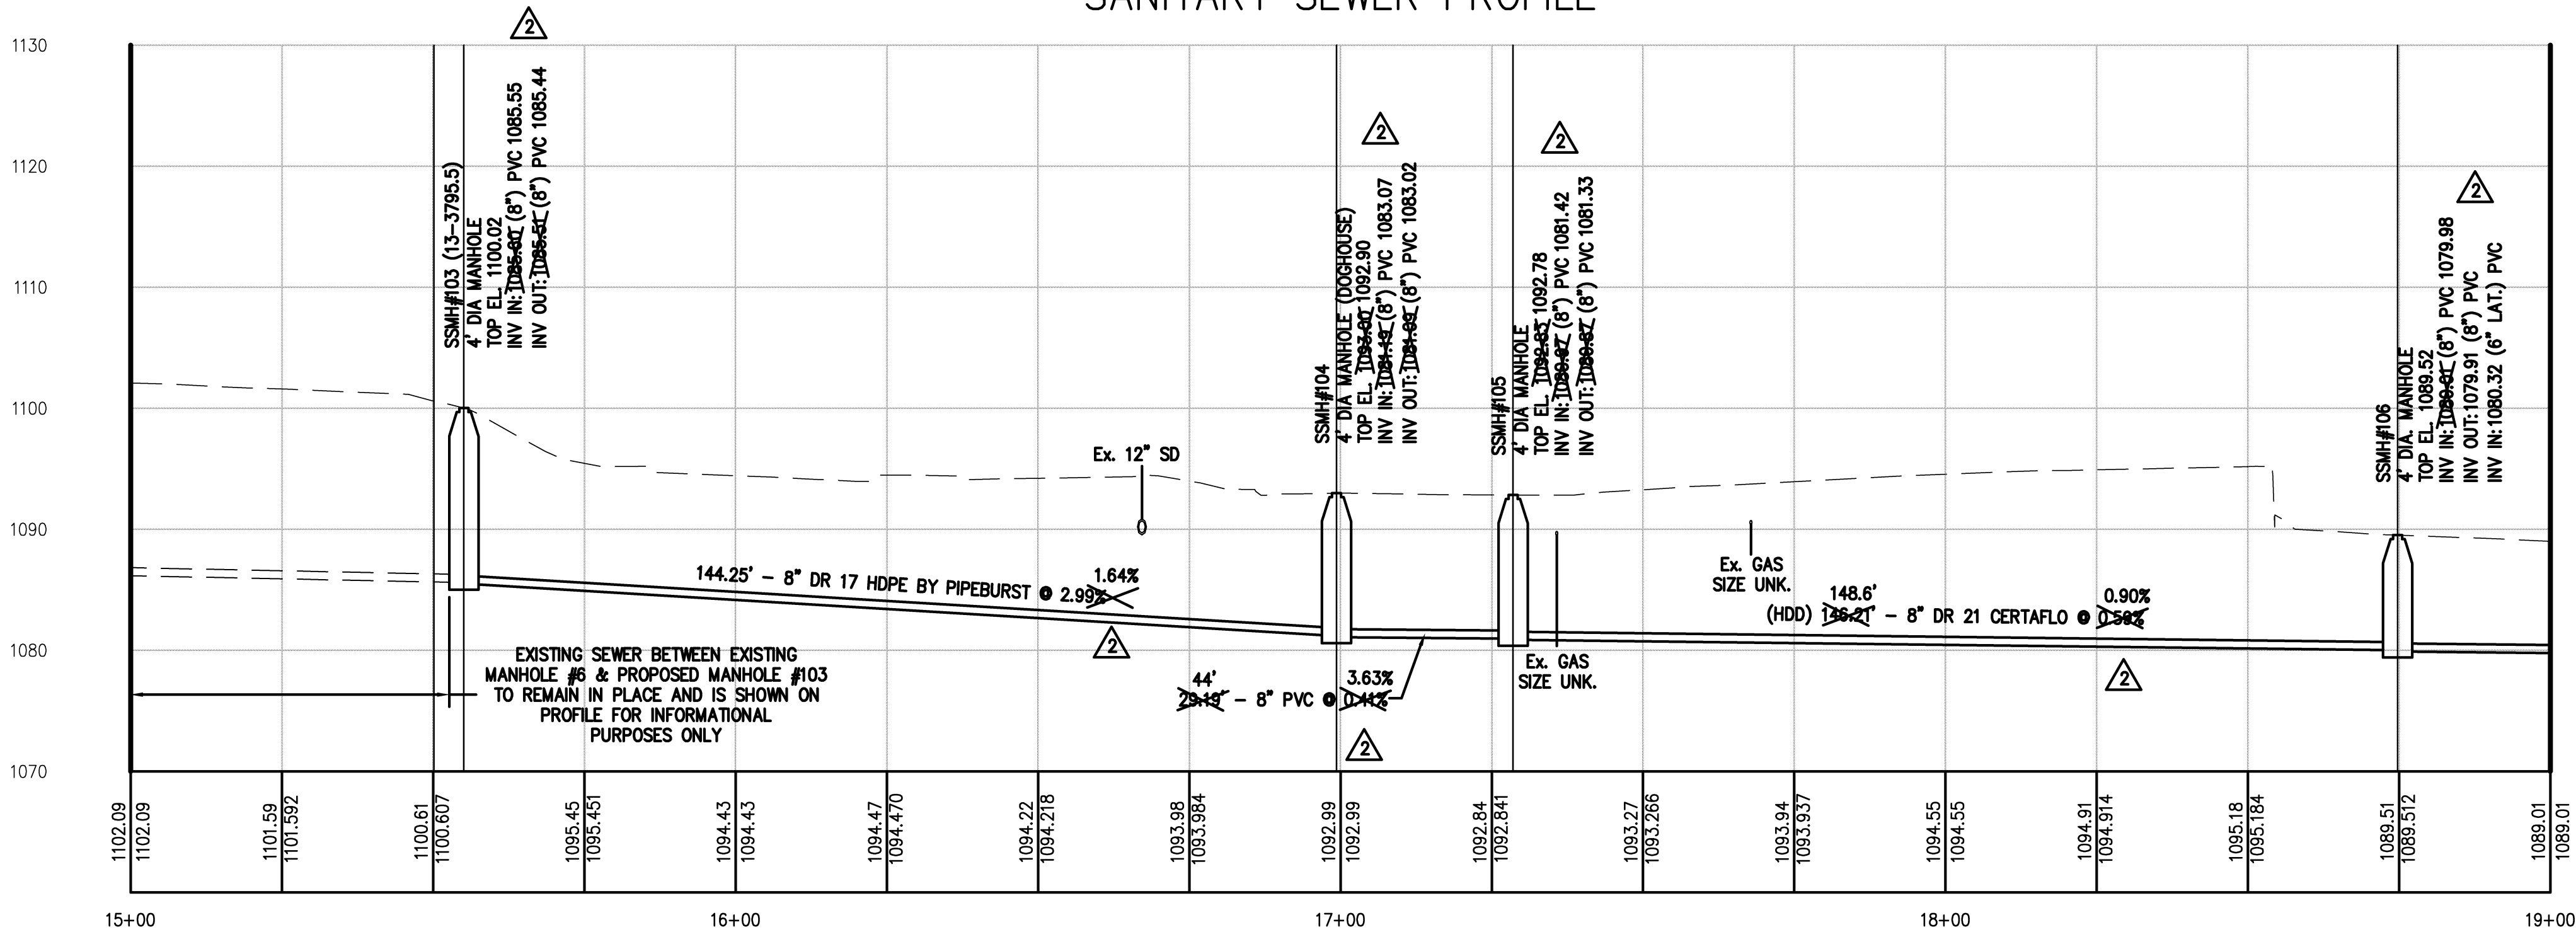

MATCHLINE SANITARY SEWER STA. 19+00
SEE SHEET 5

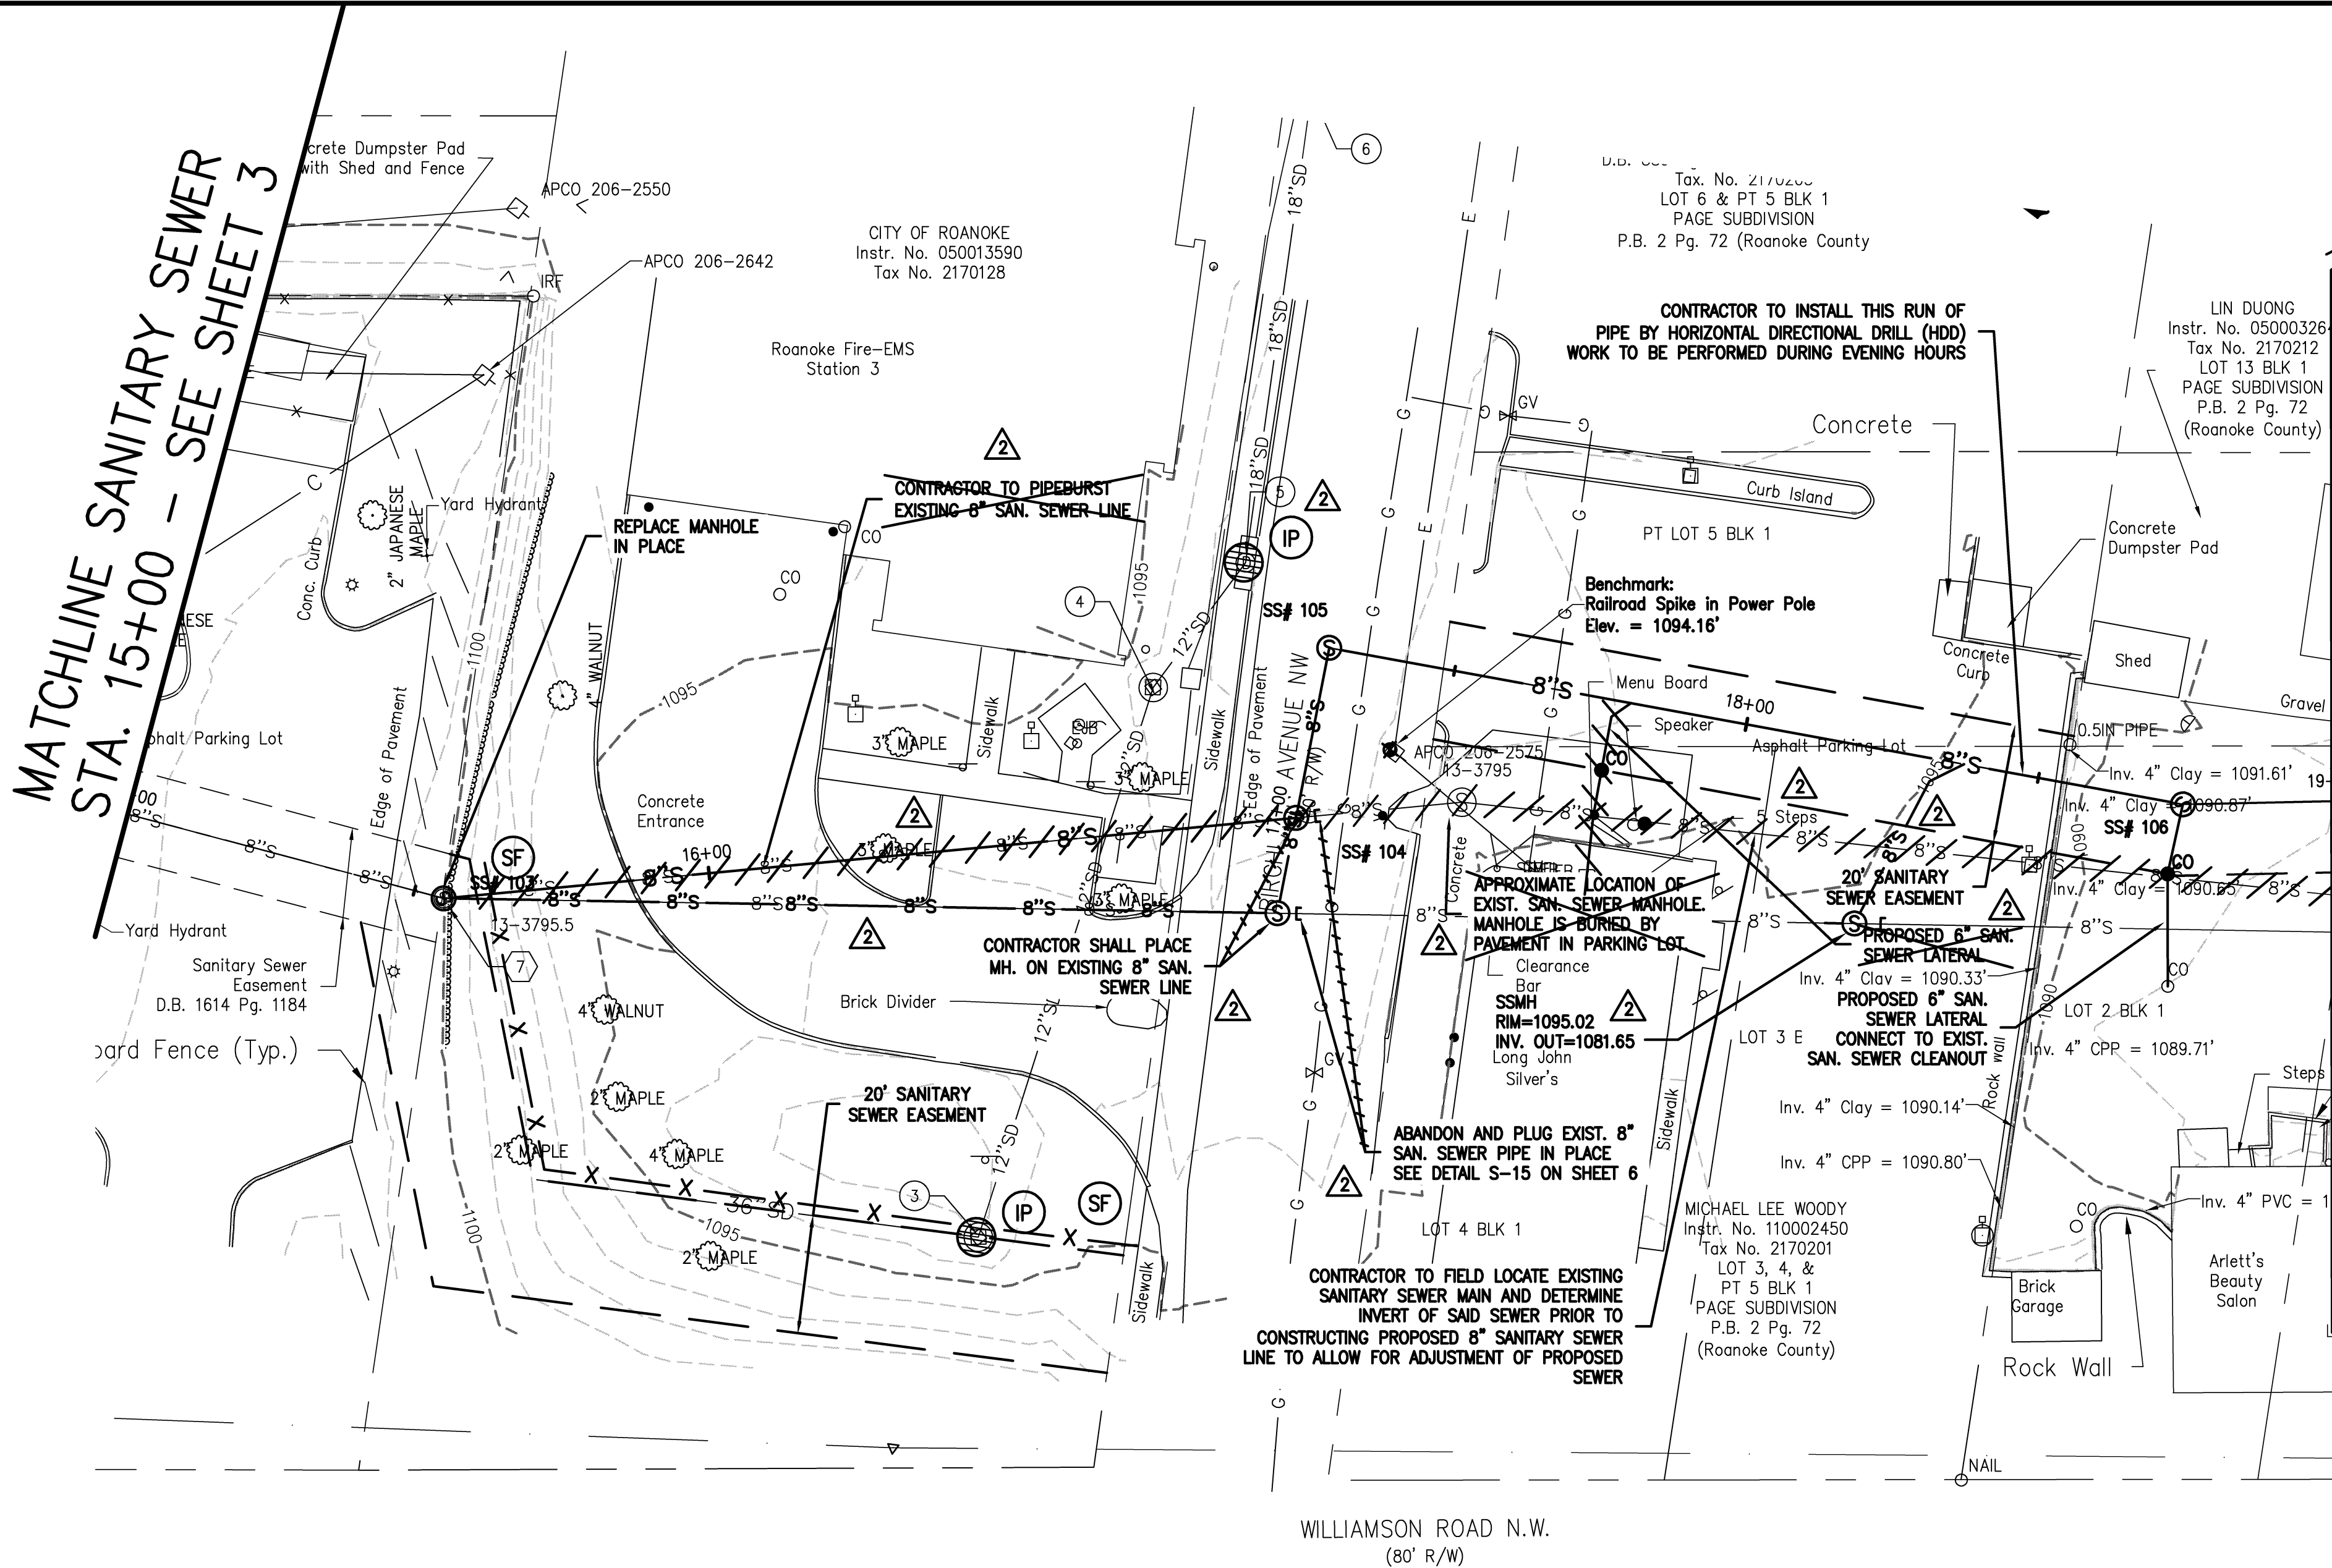

MATCHLINE SANITARY SEWER STA. 19+00
SEE SHEET 5

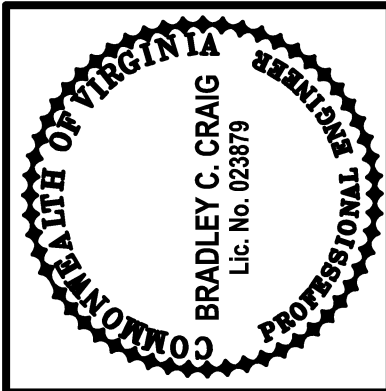

Revisions	Date
1 CHANGES BASED ON CONTRACTOR NEGOTIATIONS	11/19/2013
2 RECORDED DRAWING	08/29/14

Issue Date:	JUNE 13, 2013
Drawn By:	JEF
Designed By:	BCC/JEF
Checked By:	BCC
Date:	10/31/2012

Mattern & Craig
CONSULTING ENGINEERS • SURVEYORS
701 FIRST STREET, S.W.
ROANOKE, VIRGINIA 24004
PHONE (540) 345-9342
FAX (540) 345-7891

WILLIAMSON ROAD SEWER REPLACEMENT - 4800 BLOCK
WESTERN VIRGINIA WATER AUTHORITY
PLAN & PROFILE
CITY OF ROANOKE, VIRGINIA

Vertical Scale:
1" = 10'

Horizontal Scale:
1" = 20'

Commission Number:
3228

Sheet No.:

4

RECORD DRAWING

