




MATCHLINE SANITARY SEWER
STA. 19+00 – SEE SHEET 4

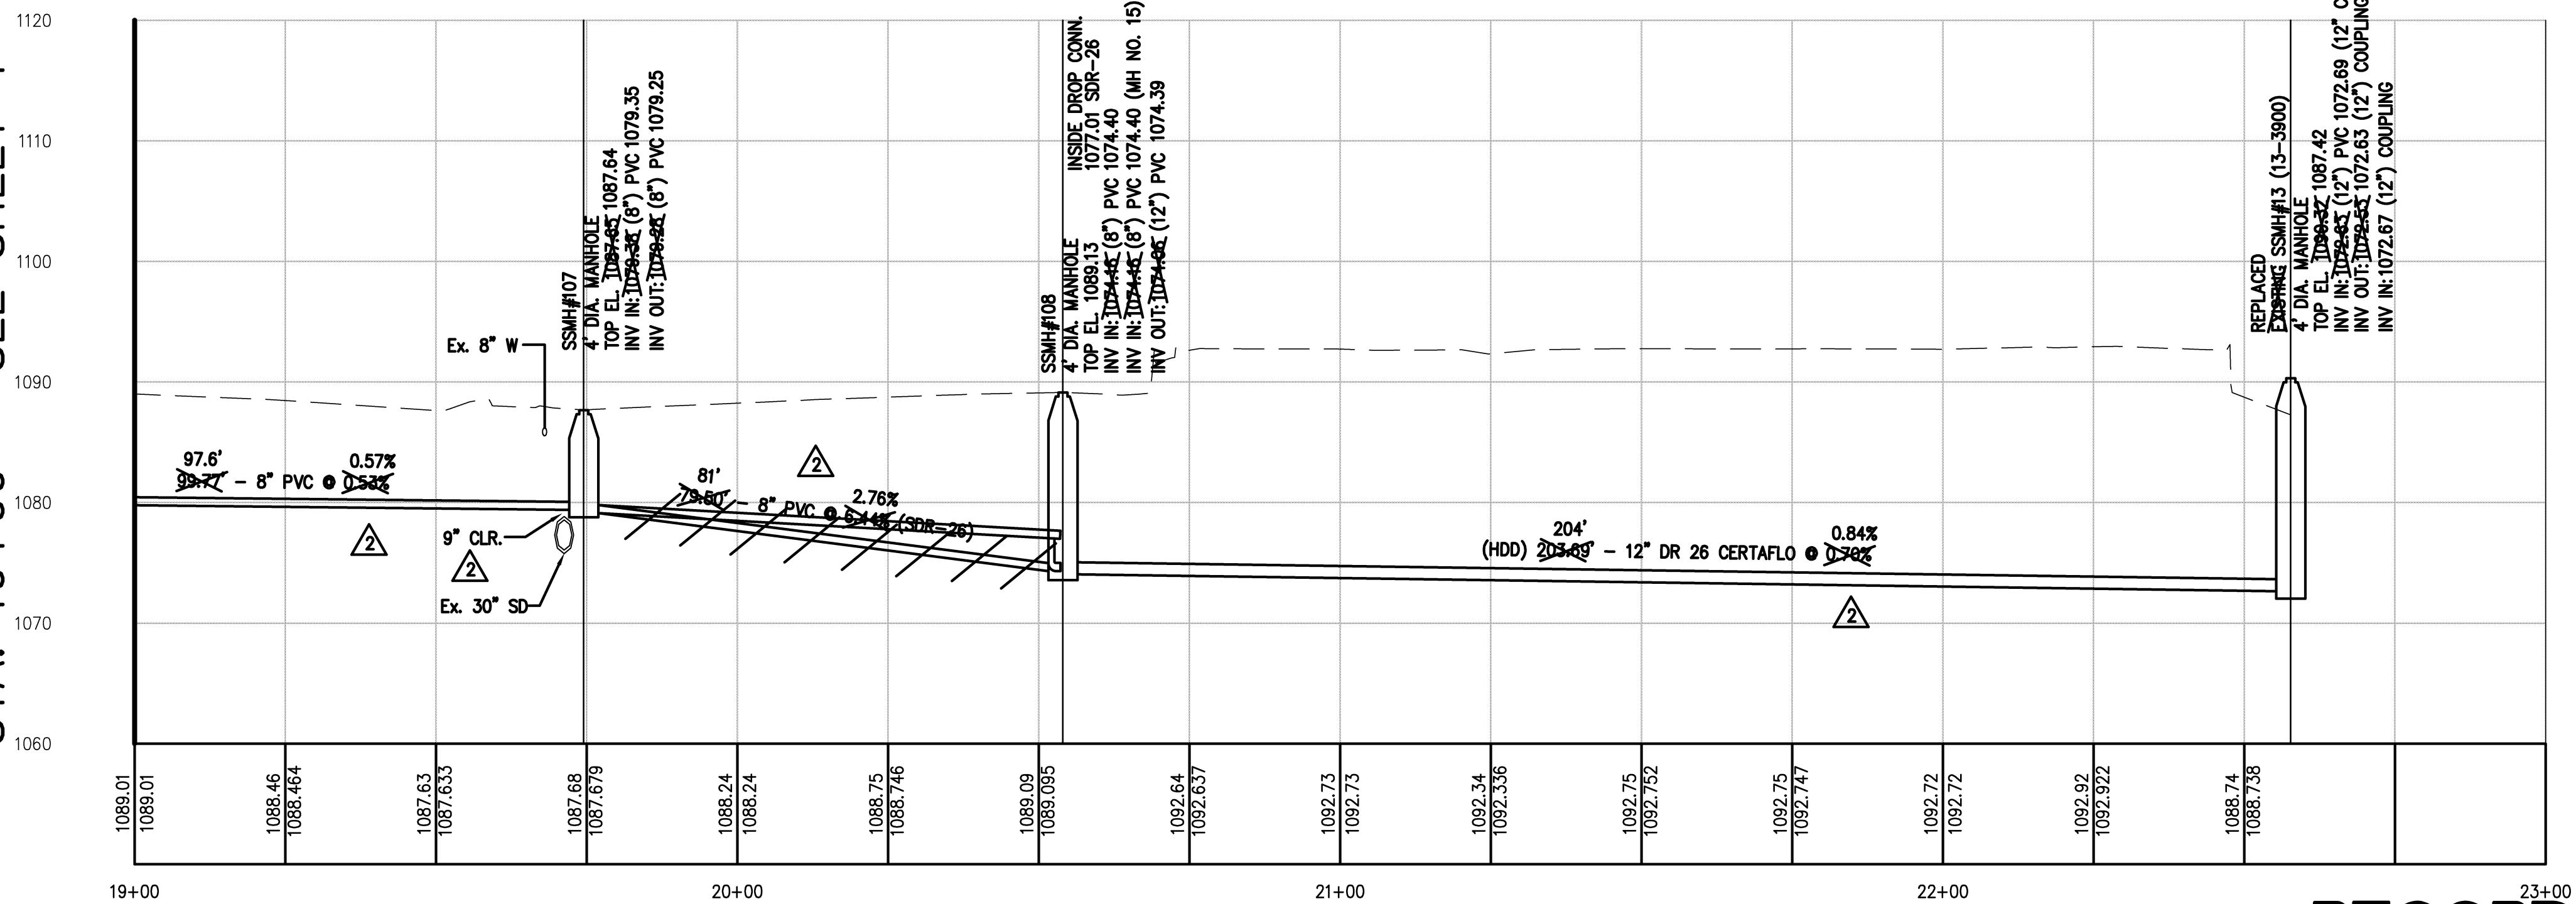

RECORD DRAWING

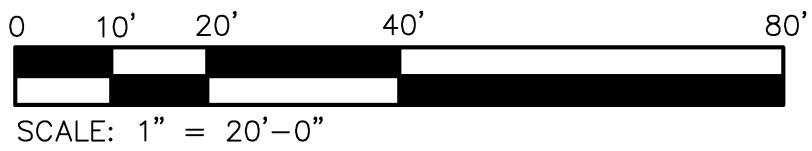

MATCHLINE SANITARY SEWER STA. 19+00
SEE SHEET 4

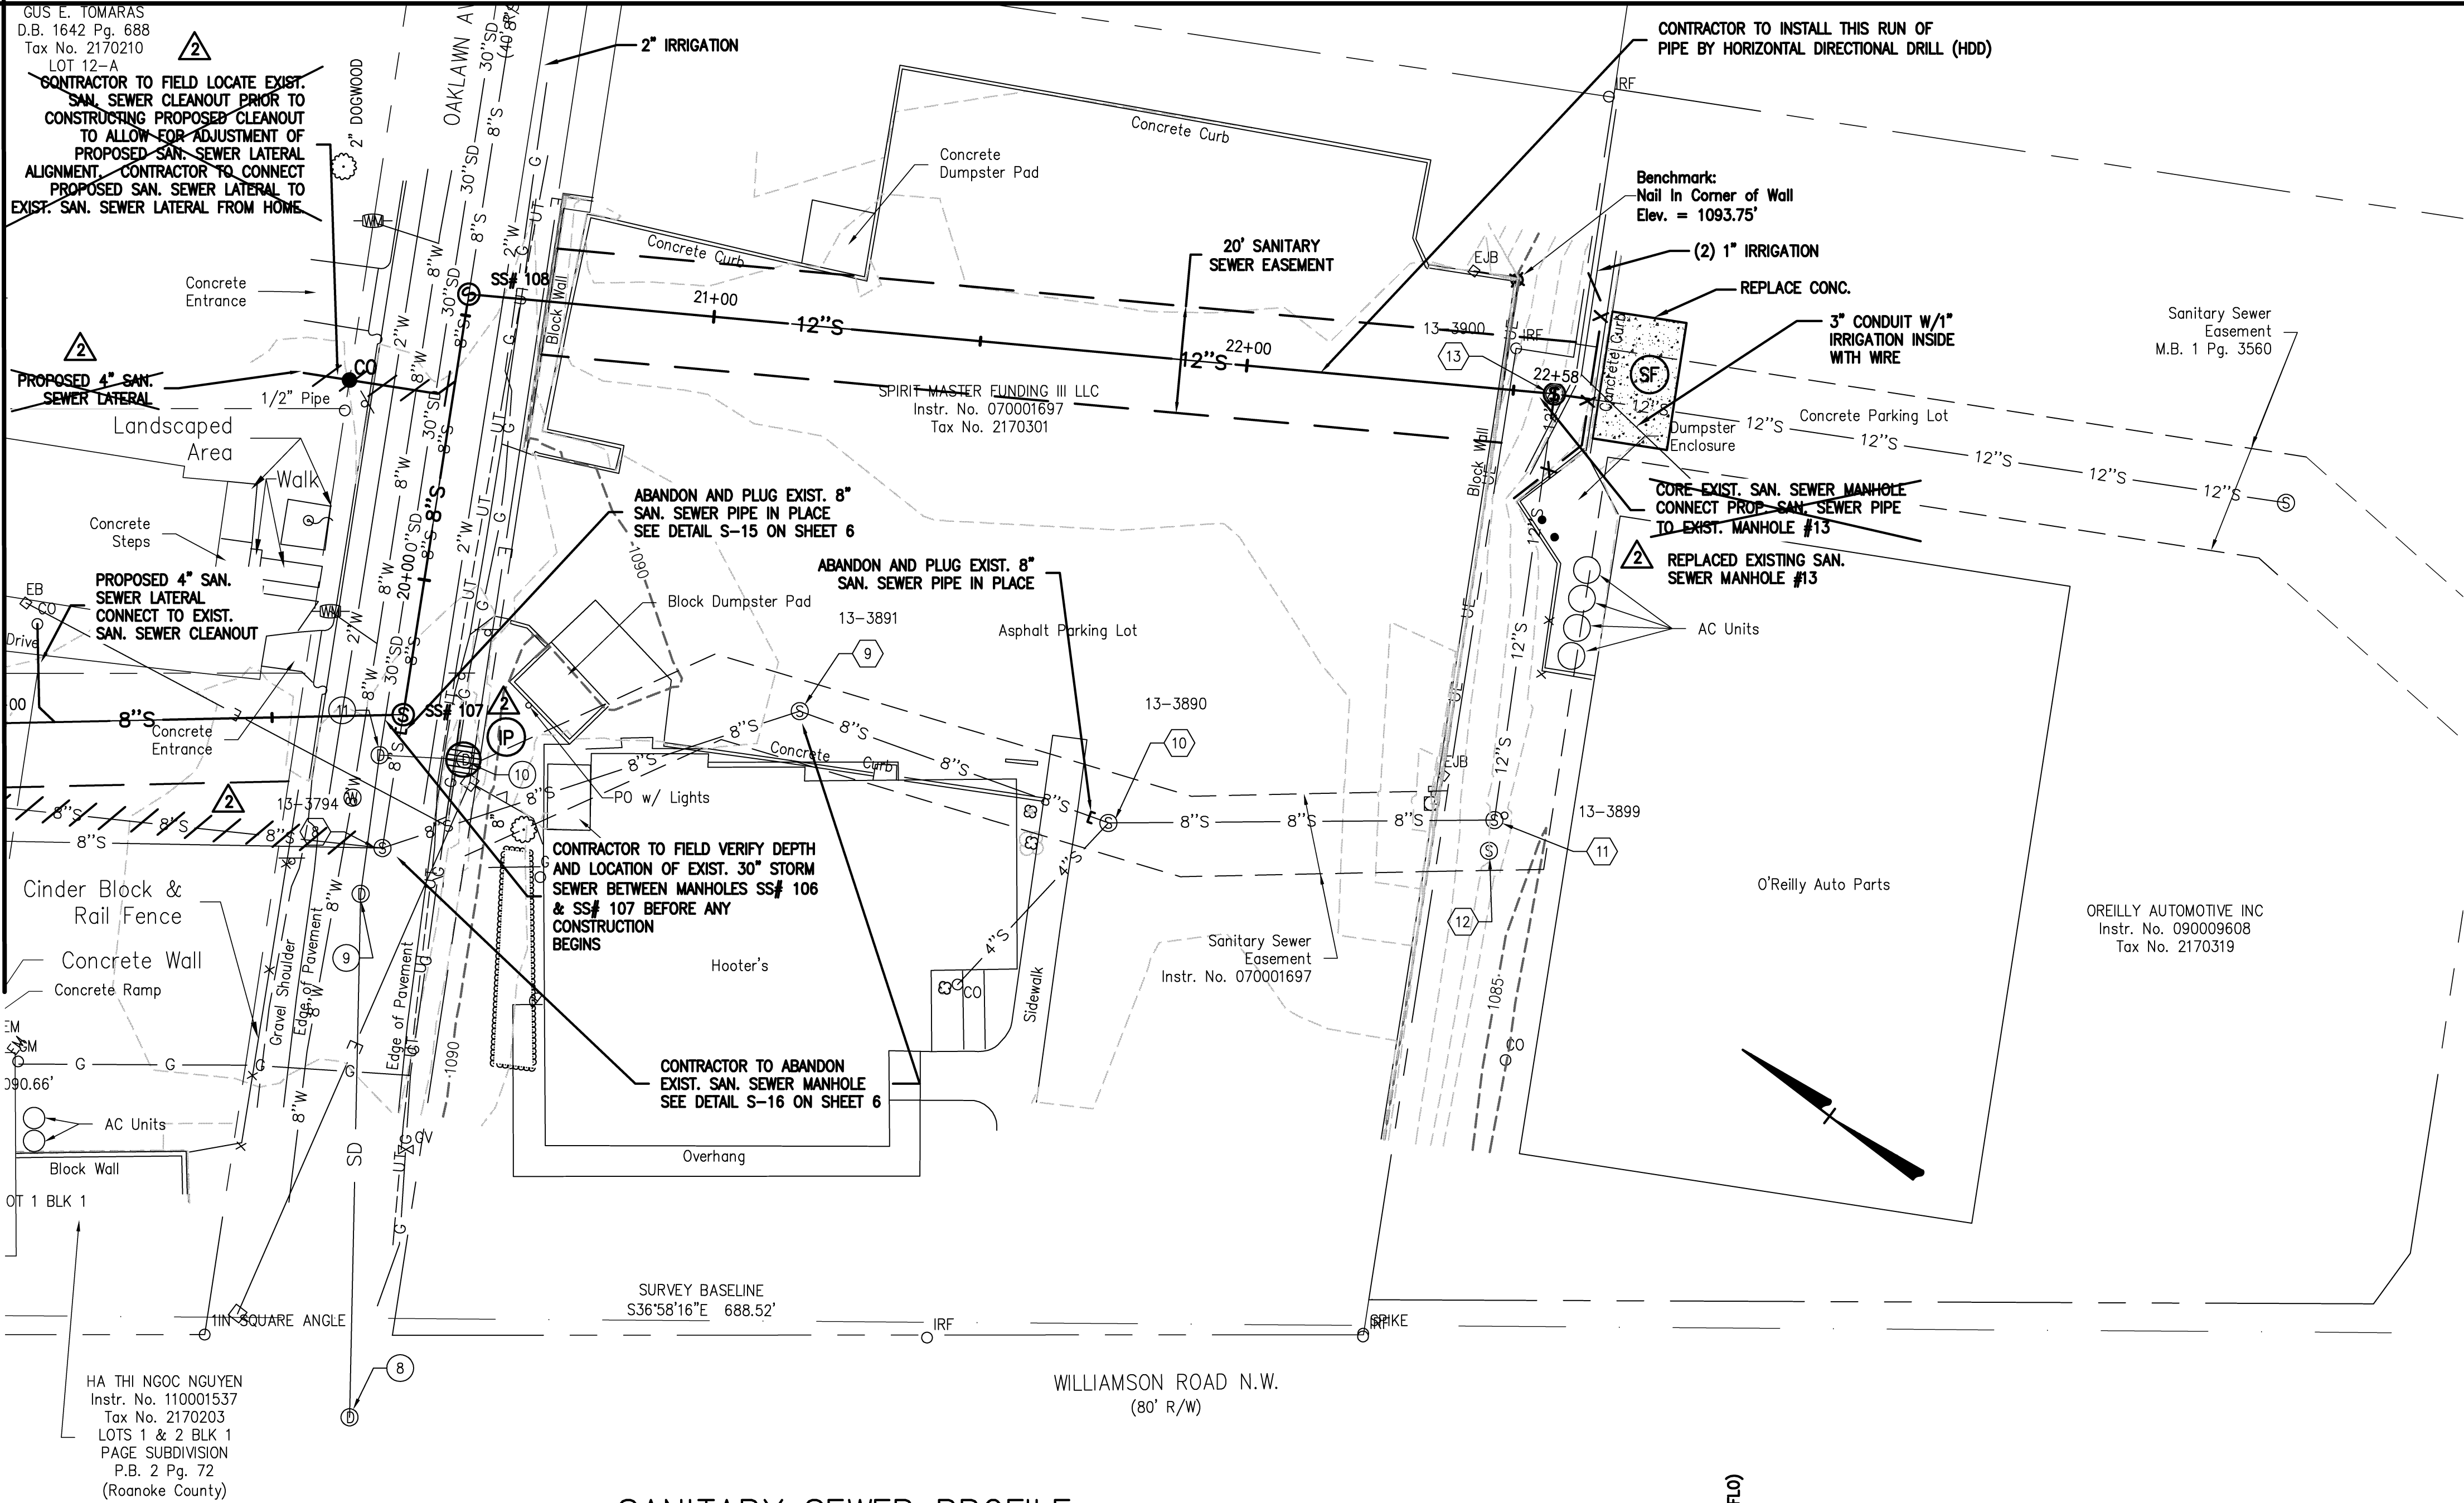

Mattern & Craig
CONSULTING ENGINEERS • SURVEYORS
701 FIRST STREET, S.W.
ROANOKE, VIRGINIA 24016
(540) 345-9342
FAX (540) 345-7691

WILLIAMSON ROAD SEWER REPLACEMENT – 4800 BLOCK
WESTERN VIRGINIA WATER AUTHORITY
PLAN & PROFILE
CITY OF ROANOKE, VIRGINIA

Vertical Scale:

1" = 10'

Horizontal Scale:

1" = 20'

Commission Number:

3228

Sheet No.:

5

Revisions	Date
1 CHANGES BASED ON CONTRACTOR NEGOTIATIONS	11/28/2013
2 RECORD DRAWING	08/29/14

Issue Date:

JUNE 13, 2013

Drawn By: JEF

Designed By: BCC/JEF

Checked By: BCC

Date: 10/31/2012

