


DEVELOPMENT PLANS
FOR
"WINDEMERE"
ROANOKE COUNTY, VIRGINIA

DATE: 1 APRIL 1988
AS-BUILT: 3 APRIL 1989
OWNER:

JAMES H. BUCKLAND & VIRGINIA H. BUCKLAND

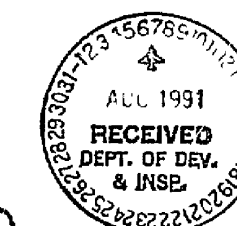


Review Number: APPROVED AS-BUILT PLANS
Development Name: WINDEMERE SUBDIVISION
Project No: 91-87-00853



APPROVE "AS-BUILT"
PLANS DATE 4/3/91

INDEX OF DRAWINGS

SHEET	DESCRIPTION
1	COVER SHEET
2	ROANOKE COUNTY STANDARD COVER SHEET
3	RECORD MAP
4	NOTES & DETAILS
5	DIMENSIONAL LAYOUT & UTILITIES
6	ROAD, SANITARY SEWER, AND STORM DRAIN PROFILES
7	EROSION CONTROL & DRAINAGE DIVIDES
8	ROANOKE COUNTY STANDARD EROSION CONTROL SHEET
9	ROANOKE COUNTY STANDARD WATER DETAIL SHEET
10	ROANOKE COUNTY STANDARD SEWER DETAIL SHEET

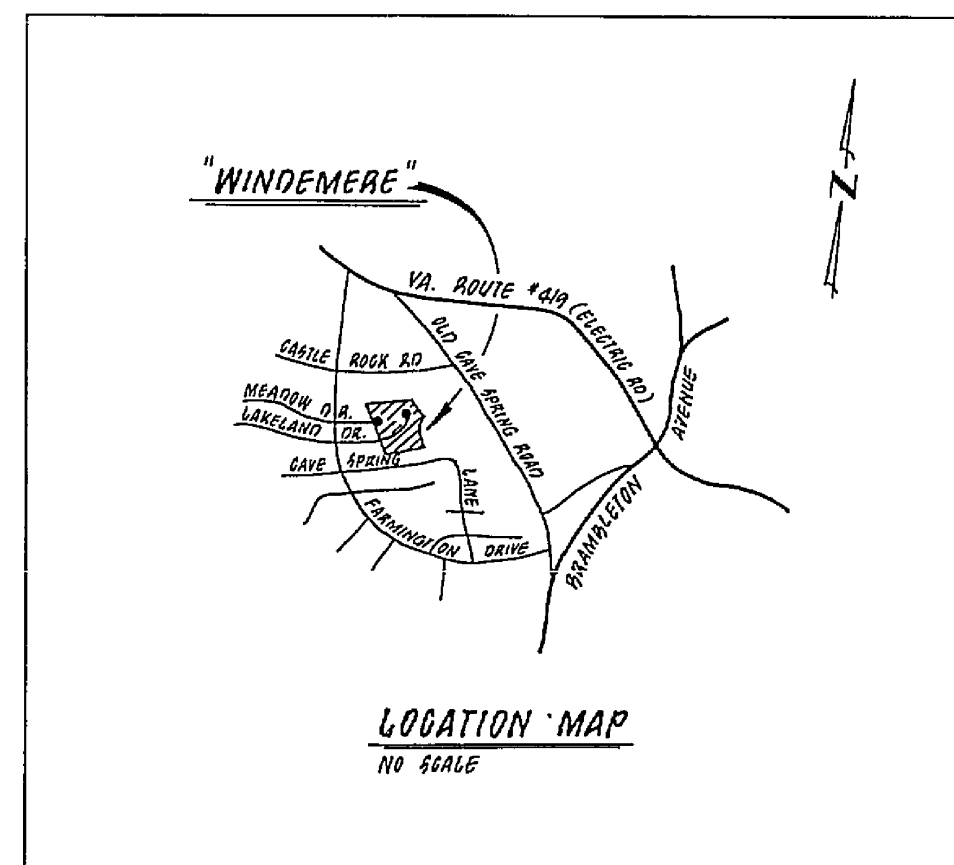

BUFORD T. LUMSDEN & ASSOCIATES, P.C.
ENGINEERS - SURVEYORS
ROANOKE, VIRGINIA

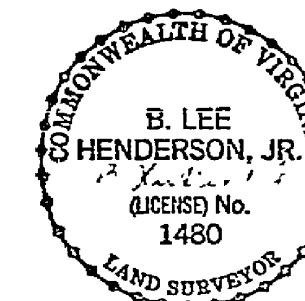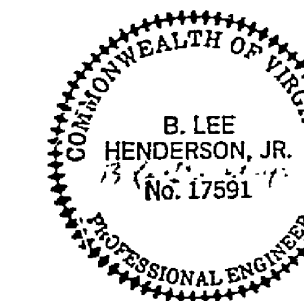

RC-0972
SHEET # 1 OF 10

