




1. AS-BUILT DIMENSIONS
ARE SHOWN IN BRACKETS

2. AS-BUILT INFORMATION T
FROM DRAWINGS FURNIS
J.P. TURNER & BROTHER
CONTRACTOR.

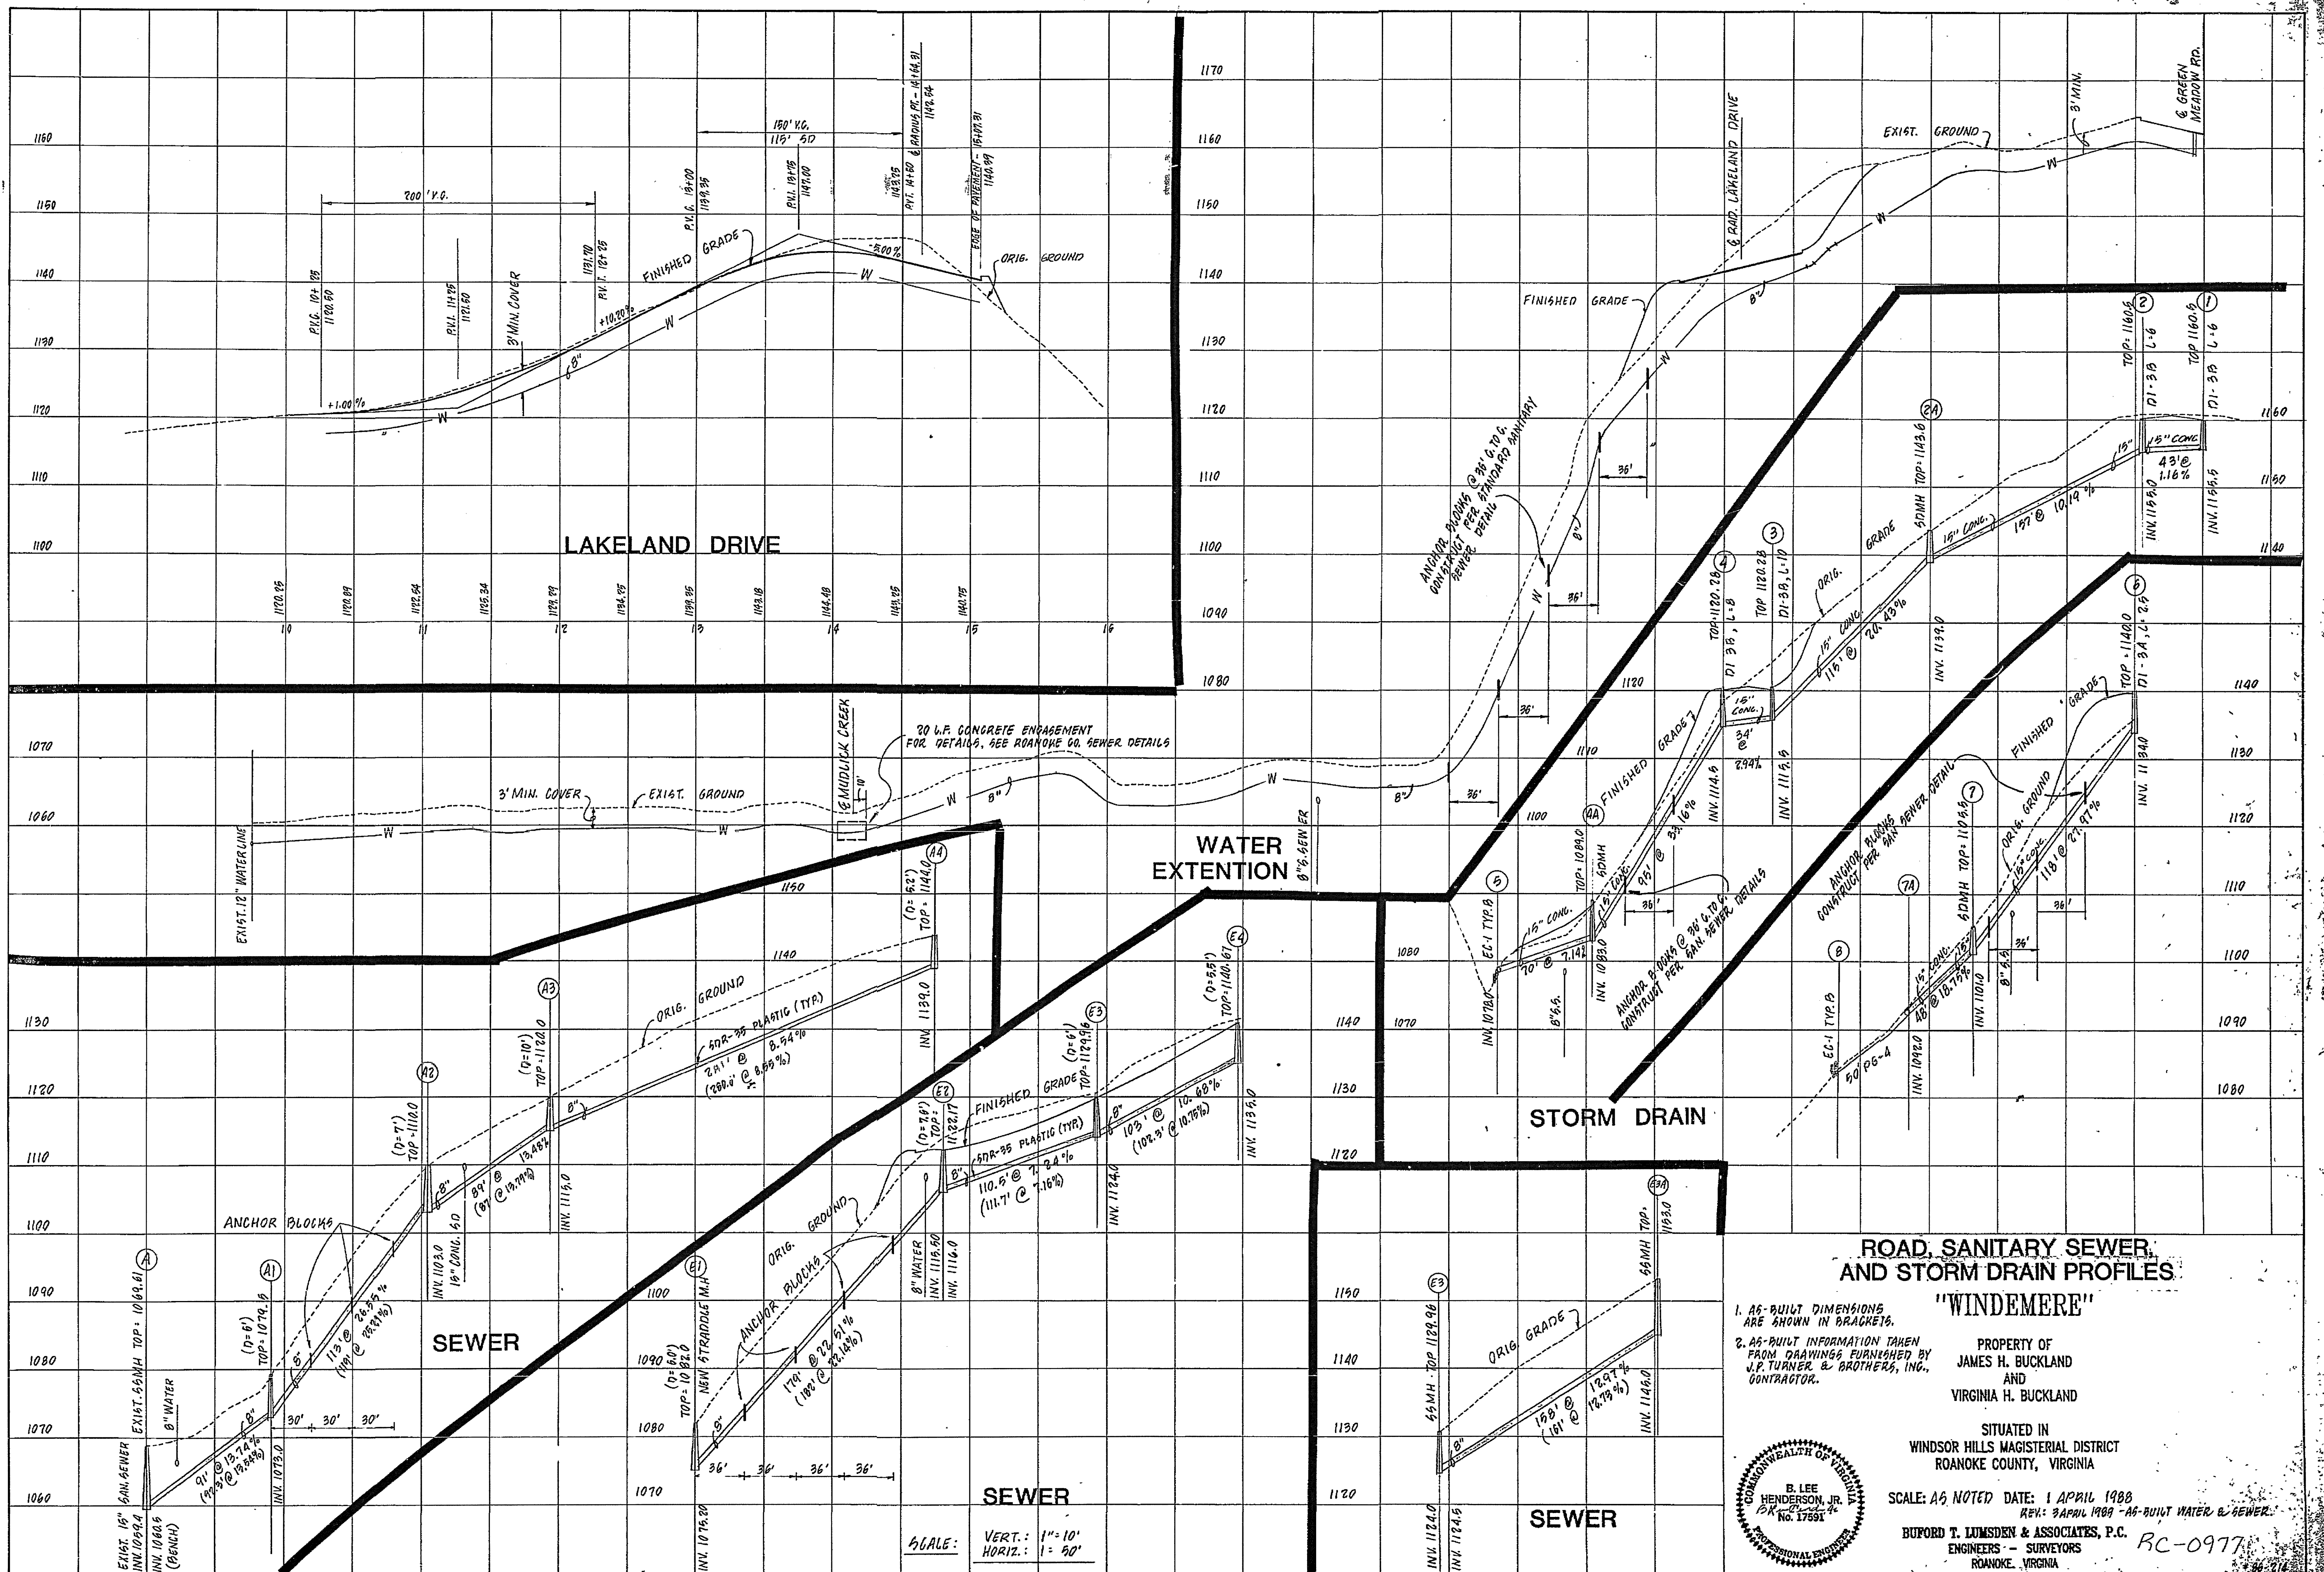

A circular professional engineer seal for the Commonwealth of Virginia. The outer ring contains the text "COMMONWEALTH OF VIRGINIA" at the top and "PROFESSIONAL ENGINEER" at the bottom, separated by a decorative border of small stars. In the center, the text reads "B. LEE HENDERSON, JR." followed by a handwritten signature "B. Lee Henderson, Jr." and the number "No. 17591".

ROAD, SANITARY SEWER, AND STORM DRAIN PROFILES:

"WINDEMERE"

TAKEN
BY
S, INC.,

PROPERTY OF
JAMES H. BUCKLAND
AND
VIRGINIA H. BUCKLAND

SITUATED IN
WINDSOR HILLS MAGISTERIAL DISTRICT
ROANOKE COUNTY, VIRGINIA

SCALE: AS NOTED DATE: 1 APRIL 1988
REV: 3 APRIL 1989 - AG-BUILT WATER & SEWER

BUFORD T. LUMSDEN & ASSOCIATES, P.C.
ENGINEERS - SURVEYORS
ROANOKE, VIRGINIA

RC-0977

SHEET # 6 OF 10

