
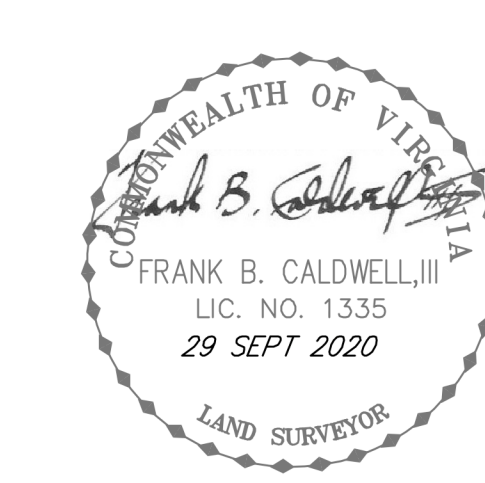


- WATER METER
- WATER VALVE
- FIRE HYDRANT
- WATER VAULT

THIS AS-BUILT SURVEY IS BASED ON THE COORDINATE SYSTEM OF PLANS BY PARKER DESIGN GROUP FOR THE WESTERN VIRGINIA WATER AUTHORITY TITLED WINDING WAY RD. & DOGWOOD LN. WATER MAIN REPLACEMENT, DATED JUNE 17, 2020, PROJECT NUMBER 20-0034.

THIS AS-BUILT SURVEY IS BASED ON A FIELD SURVEY OF VISIBLE WATERLINE IMPROVEMENTS AND AS-BUILT SKETCHES FROM THE CONTRACTOR FOR UNDERGROUND IMPROVEMENTS. THE FIELD SURVEY WAS COMPLETED BY CALDWELL WHITE ASSOCIATES, CONCLUDED ON SEPTEMBER 14, 2020.

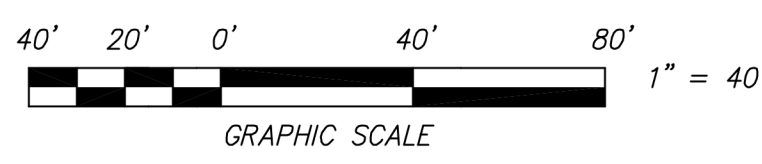

THIS AS-BUILT SURVEY WAS COMPLETED UNDER THE DIRECT AND RESPONSIBLE CHARGE OF, FRANK B. CALDWELL, III, L.S. FROM AN ACTUAL GROUND SURVEY MADE UNDER MY SUPERVISION. THE ORIGINAL DATA WAS OBTAINED ON SEPTEMBER 14, 2020; AND THIS DIGITAL GEOSPATIAL DATA INCLUDING METADATA MEETS MINIMUM ACCURACY STANDARDS UNLESS OTHERWISE NOTED.

AS-BUILT SURVEY
FOR
WELLS CONSTRUCTION

SHOWING NEW WATERLINE LOCATION

WESTERN VIRGINIA WATER AUTHORITY PROJECT No. 20-0034

SITUATE AT WINDING WAY ROAD, S.W. AND DOGWOOD LANE, S.W.

CITY OF ROANOKE, VIRGINIA

Drawn: C.L. Hurd

Checked: F.B. Caldwell

Date: SEPTEMBER 29, 2020

Scale: 1"=40'

Tax Parcel: VARIES

Field Book: CH-20

W.O.: 20-0045

CALDWELL WHITE ASSOCIATES

ENGINEERS / SURVEYORS / PLANNERS

4203 MELROSE AVENUE, N.W. P.O. BOX 6260

ROANOKE, VIRGINIA 24017-0260

Telephone: (540) 366-3400 Fax: (540) 366-8702

E-Mail: cwaroanoke@aol.com