



MATCHLINE 3 OF 4
MATCHLINE 4 OF 4

MERIDIAN OF VIRGINIA STATE PLANE
SOUTH ZONE

- WATER METER
- WATER VALVE
- FIRE HYDRANT
- WATER VAULT

THIS AS-BUILT SURVEY IS BASED ON THE COORDINATE SYSTEM OF PLANS BY PARKER DESIGN GROUP FOR THE WESTERN VIRGINIA WATER AUTHORITY TITLED WINDING WAY RD. & DOGWOOD LN. WATER MAIN REPLACEMENT, DATED JUNE 17, 2020, PROJECT NUMBER 20-0034.

THIS AS-BUILT SURVEY IS BASED ON A FIELD SURVEY OF VISIBLE WATERLINE IMPROVEMENTS AND AS-BUILT SKETCHES FROM THE CONTRACTOR FOR UNDERGROUND IMPROVEMENTS. THE FIELD SURVEY WAS COMPLETED BY CALDWELL WHITE ASSOCIATES, CONCLUDED ON SEPTEMBER 14, 2020.

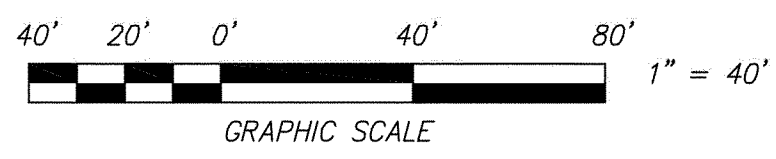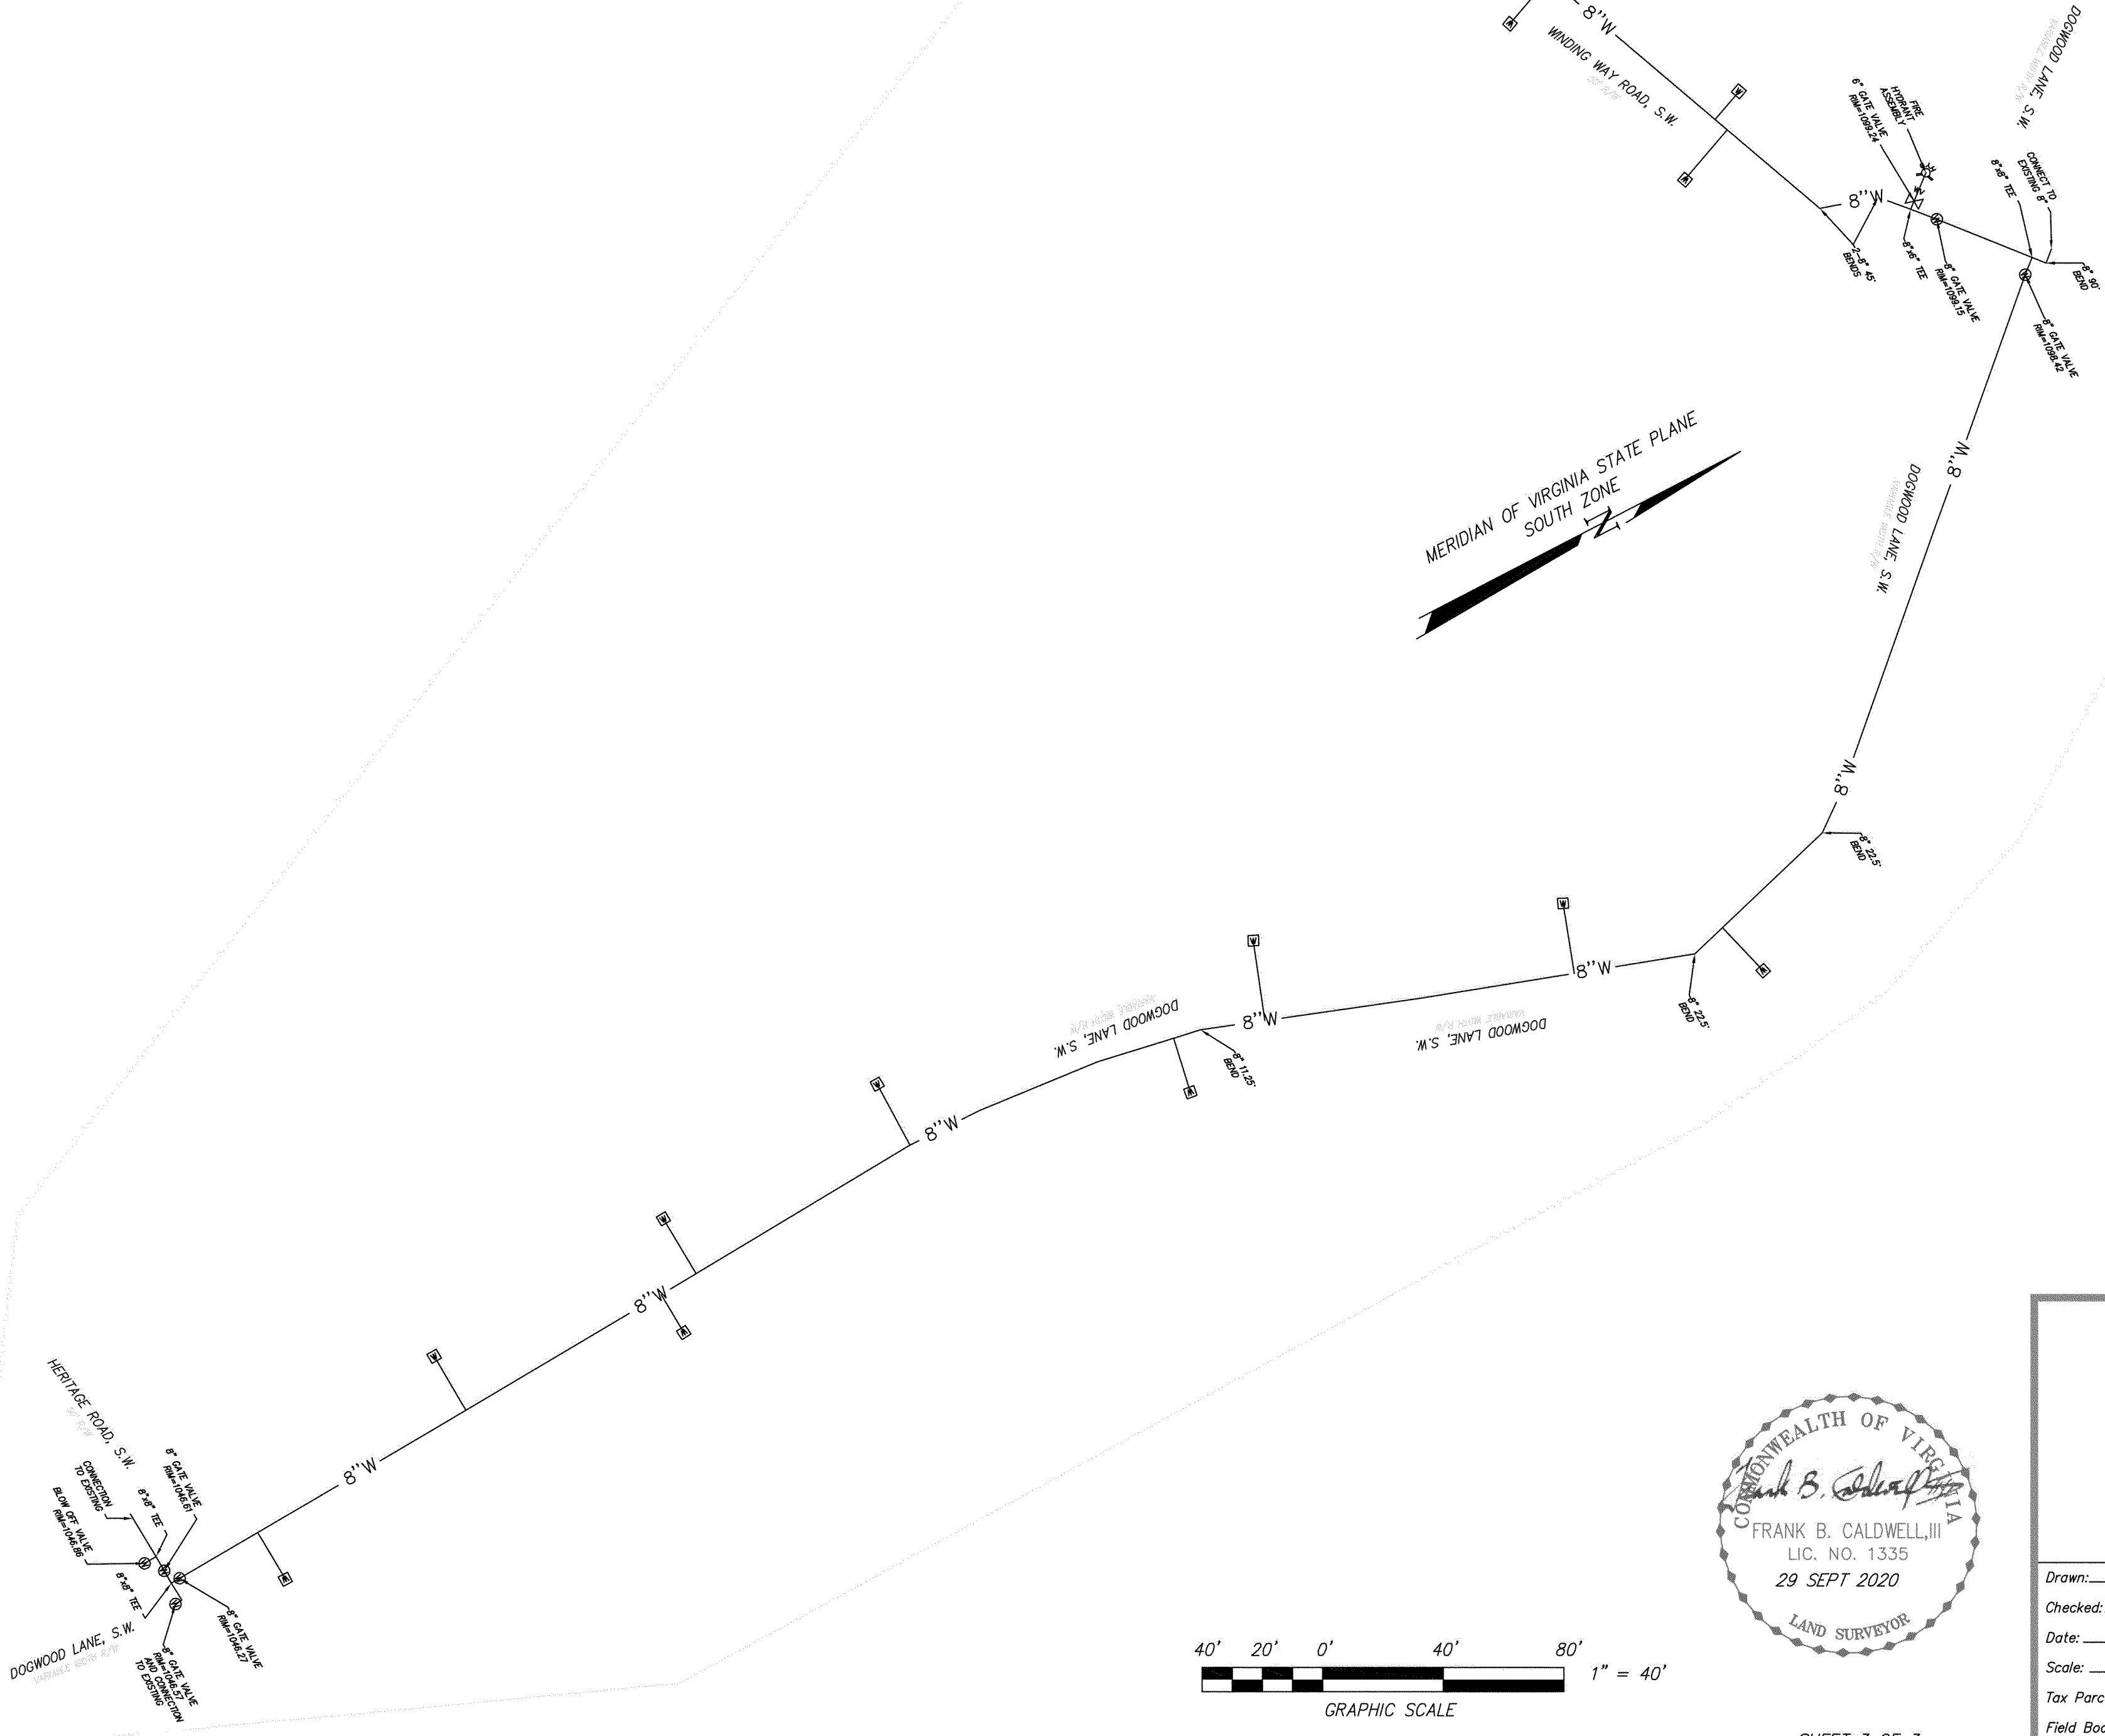

SHEET 3 OF 3

THIS AS-BUILT SURVEY WAS COMPLETED UNDER THE DIRECT AND RESPONSIBLE CHARGE OF, FRANK B. CALDWELL, III, L.S. FROM AN ACTUAL GROUND SURVEY MADE UNDER MY SUPERVISION; THE ORIGINAL DATA WAS OBTAINED ON SEPTEMBER 14, 2020; AND THIS DIGITAL GEOSPATIAL DATA INCLUDING METADATA MEETS MINIMUM ACCURACY STANDARDS UNLESS OTHERWISE NOTED.

AS-BUILT SURVEY
FOR
WELLS CONSTRUCTION

SHOWING NEW WATERLINE LOCATION
WESTERN VIRGINIA WATER AUTHORITY PROJECT No. 20-0034
SITUATE AT WINDING WAY ROAD, S.W. AND DOGWOOD LANE, S.W.
CITY OF ROANOKE, VIRGINIA

Drawn: C.L. Hurd
Checked: F.B. Caldwell
Date: SEPTEMBER 29, 2020
Scale: 1"=40'
Tax Parcel: VARIES
Field Book: CH-20
W.O.: 20-0045

CWA
CALDWELL WHITE ASSOCIATES
ENGINEERS / SURVEYORS / PLANNERS
4203 MELROSE AVENUE, N.W. P.O. BOX 6260
ROANOKE, VIRGINIA 24017-0260
Telephone: (540) 366-3400 Fax: (540) 366-8702
E-Mail: cwaroanoke@aol.com