



PHASE II PHASE I

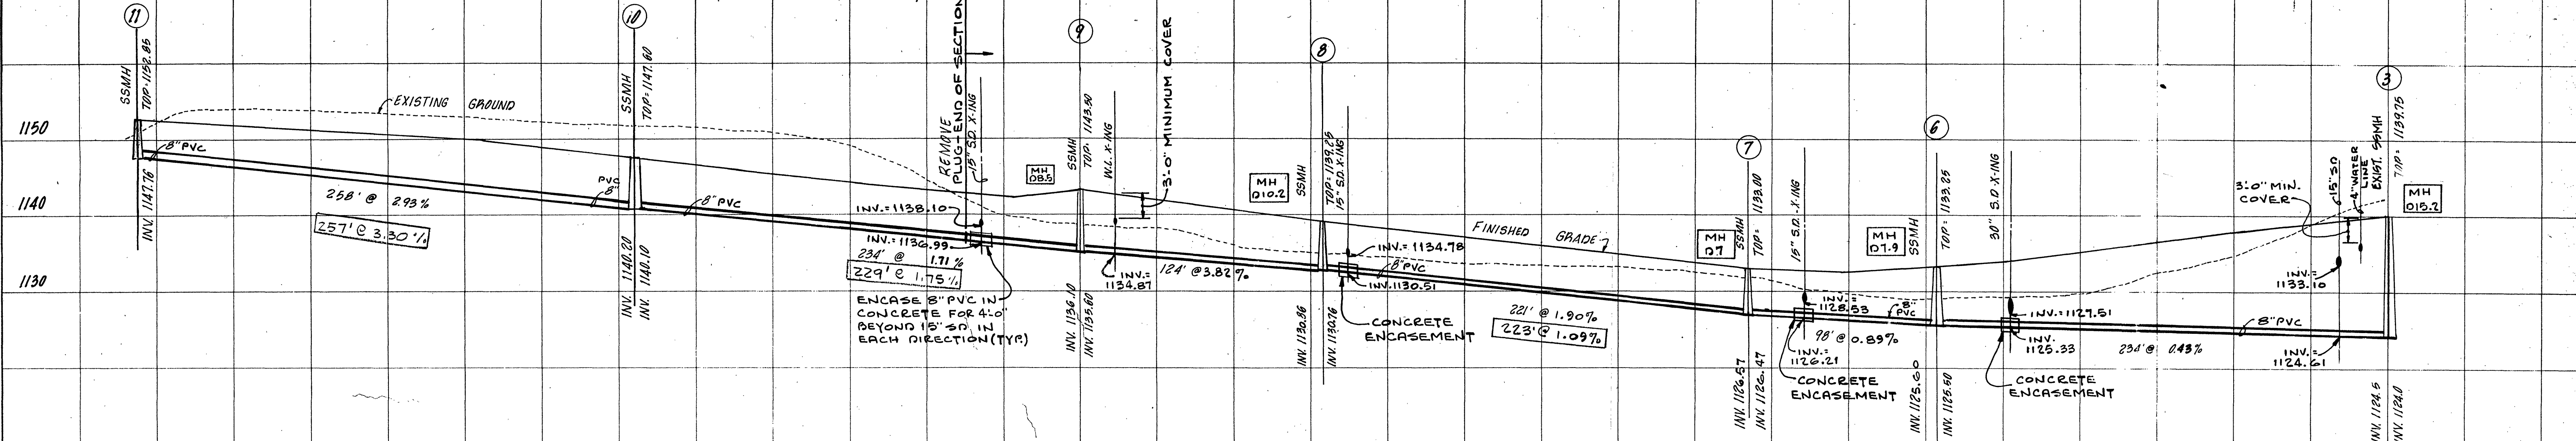

SECTION # 3 PHASE I *

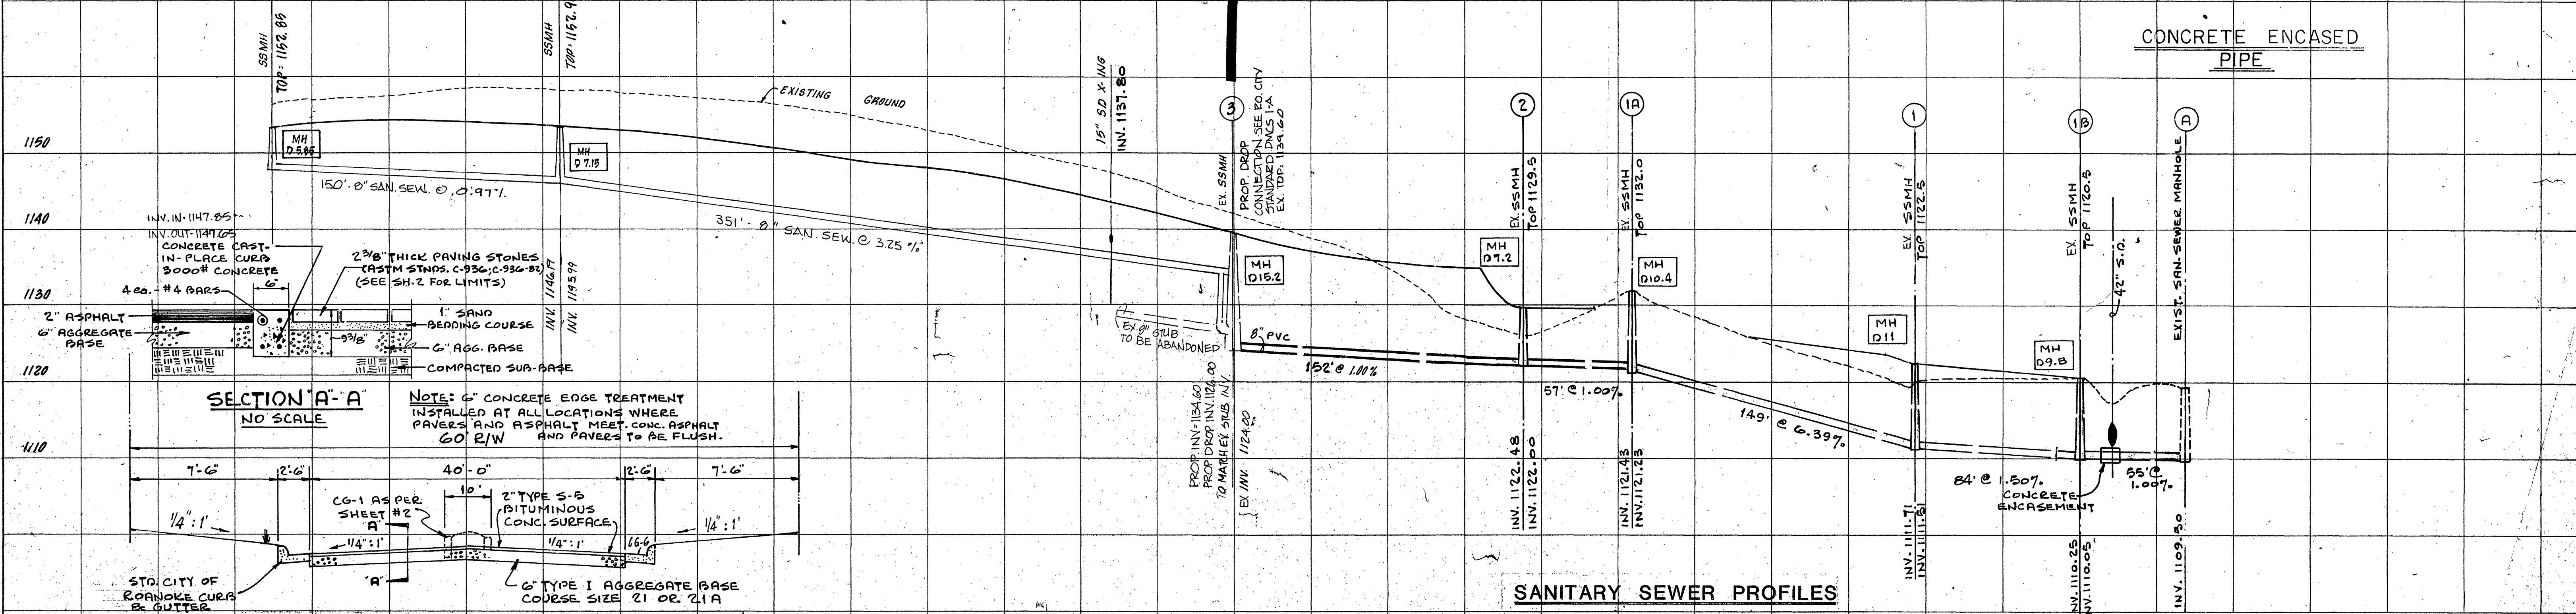

SECTION 'A-A'
NO SCALE


NOTE: 6" CONCRETE EDGE TREATMENT
INSTALLED AT ALL LOCATIONS WHERE
PAVERS AND ASPHALT MEET CONC. ASPHALT
AND PAVERS TO BE FLUSH.

TYPICAL ENTRANCE SECTION ASHLEY LANE
NO SCALE

SANITARY SEWER PROFILES
scale: horiz. 1"=40' vert. 1"=10'

*NOTE:
PHASE I IMPROVEMENTS ARE EITHER "IN
PLACE" OR UNDER CONSTRUCTION AND BONDED.

"AS-BUILT" INFORMATION FURNISHED BY
J.P. TURNER BROTHERS

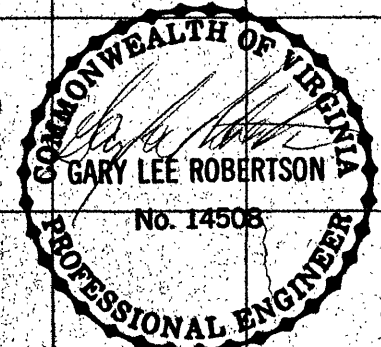

1	12-15-89	ADD "AS-BUILT" INFORMATION
2	12-15-89	RAISE SANITARY SEWER BETWEEN MHS 5-4-4-3; ADD DROP CONNECTION AT MH 3. 10-6-89
3	4-21-88	REVISED ENTRANCE SECTION & ADDED SECTION "A-A"
4	2-11-88	REVISED INV. M.H. 6 & ADJACENT GRADES
5	12-8-87	REVISED INVERTS & GRADES - M.H. 6, 7 & 8
6	12-29-87	ADDED M.H. 10 AND REVISED ADJACENT GRADES - RELOCATE M.H. 1 & 1A
SECTION # 182		
PROFILES & DETAILS for WINDSOR TRAILS TOWNHOMES City of Roanoke Virginia		
"AS-BUILT"		
BUFORD T. LUMSDEN & ASSOCIATES, P.C. ENGINEERS-SURVEYORS ROANOKE, VIRGINIA		SCALE: AS SHOWN COMM. 86-254G DATE: 15 AUG. 1989 SHEET 5 of 6

