


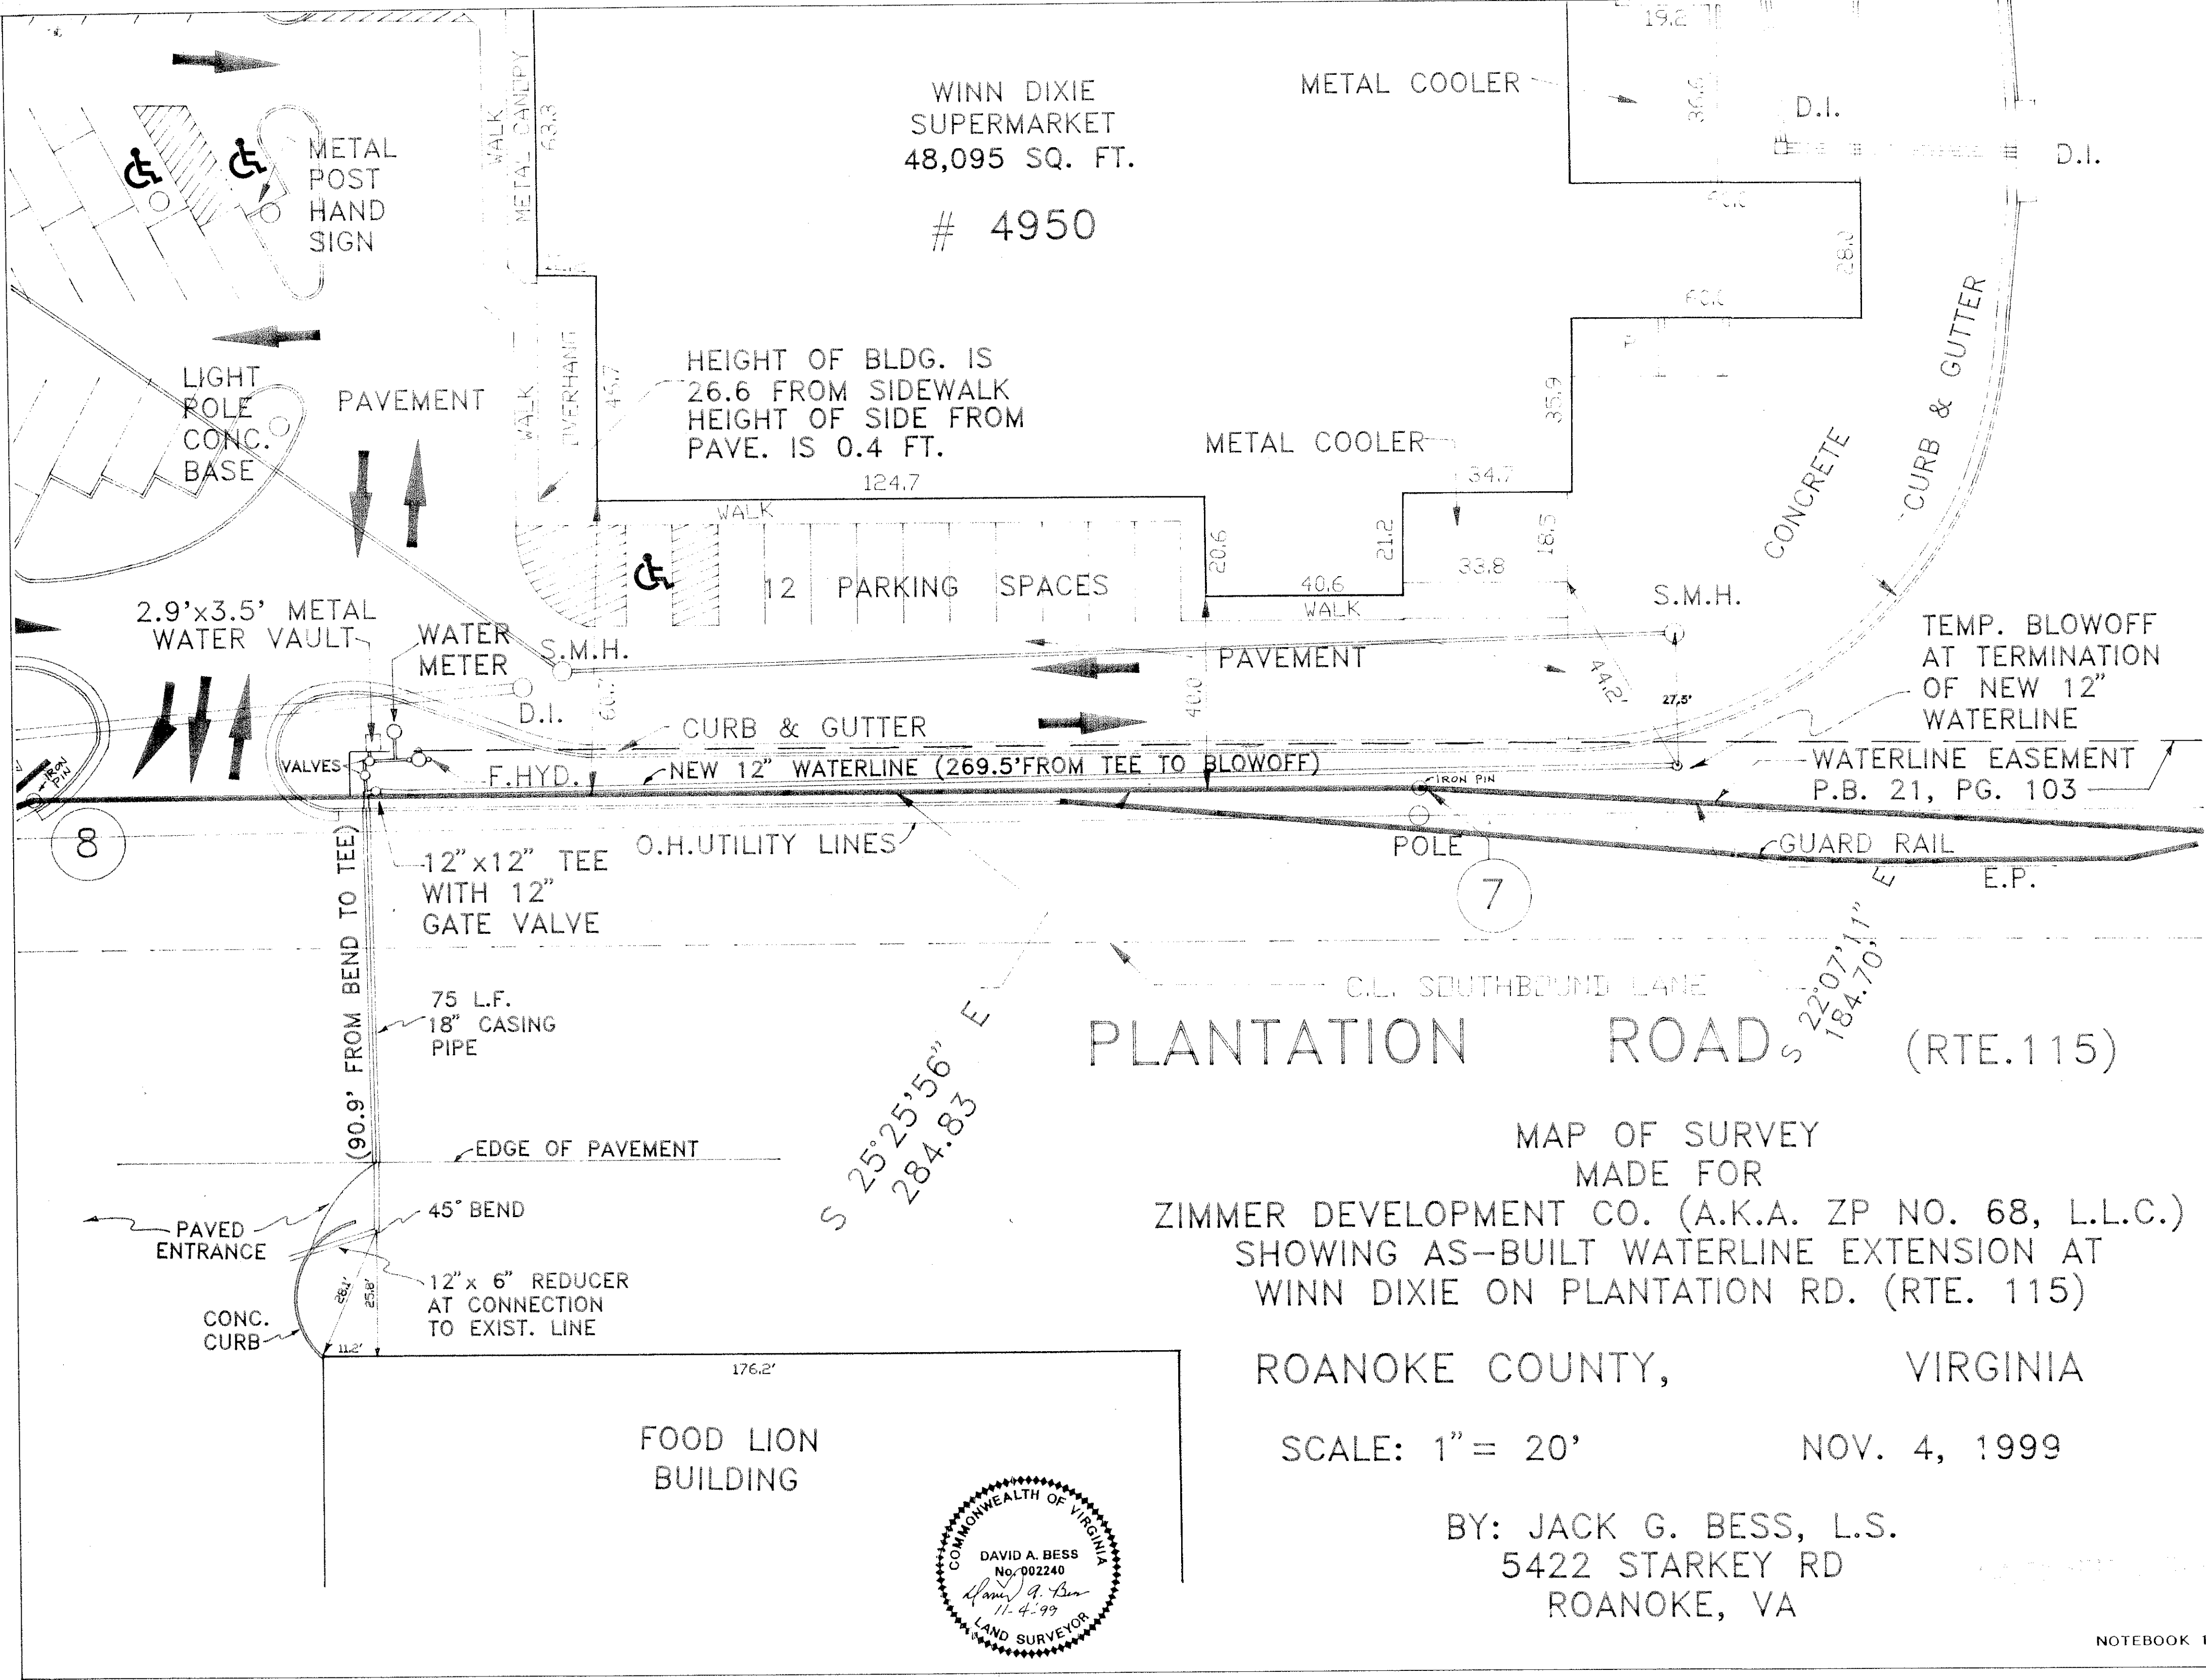

WINN DIXIE
SUPERMARKET
48,095 SQ. FT.

4950

HEIGHT OF BLDG. IS
26.6 FROM SIDEWALK
HEIGHT OF SIDE FROM
PAVE. IS 0.4 FT.

METAL COOLER

METAL COOLER

12 PARKING SPACES

PAVEMENT

CURB & GUTTER

NEW 12" WATERLINE (269.5' FROM TEE TO BLOWOFF)

WATERLINE EASEMENT
P.B. 21, PG. 103

12" x 12" TEE
WITH 12"
GATE VALVE

O.H. UTILITY LINES

75 L.F.
18" CASING
PIPE

EDGE OF PAVEMENT

45° BEND

12" x 6" REDUCER
AT CONNECTION
TO EXIST. LINE

FOOD LION
BUILDING

PLANTATION ROAD (RTE. 115)

MAP OF SURVEY
MADE FOR
ZIMMER DEVELOPMENT CO. (A.K.A. ZP NO. 68, L.L.C.)
SHOWING AS-BUILT WATERLINE EXTENSION AT
WINN DIXIE ON PLANTATION RD. (RTE. 115)

ROANOKE COUNTY, VIRGINIA

SCALE: 1" = 20' NOV. 4, 1999

BY: JACK G. BESS, L.S.
5422 STARKEY RD
ROANOKE, VA

