

NOTE:

THE CONNECTIONS TO THE EXISTING SEWER MANHOLE SHALL BE DONE BY THE ROANOKE COUNTY UTILITY DEPARTMENT. THE CONTRACTOR SHALL EXCAVATE TO THE BASE OF THE EXISTING MANHOLE, SHOR PER OSHA REQUIREMENTS, AND PROVIDE A CENTER MARK ON THE SIDE OF THE MANHOLE FOR THE TAP. THIS WORK SHOULD BE COORDINATED AT THE PRE-CONSTRUCTION MEETING.


LOW POINT ELEV = 1233.47
LOW POINT STA = 23+57.02
PVI STA = 24+00
PVI ELEV = 1221.57
A.D. = 19.64
K = 25.46
S.D. = 135
500.00' VC

PVI STA = 27+68.33
PVI ELEV = 1263.94
A.D. = -6.50
K = 16.92
S.D. = 157
100.00' VC

WISTERIA PLACE COURT

APPLE HARVEST DR.

CRUMPACKER DRIVE

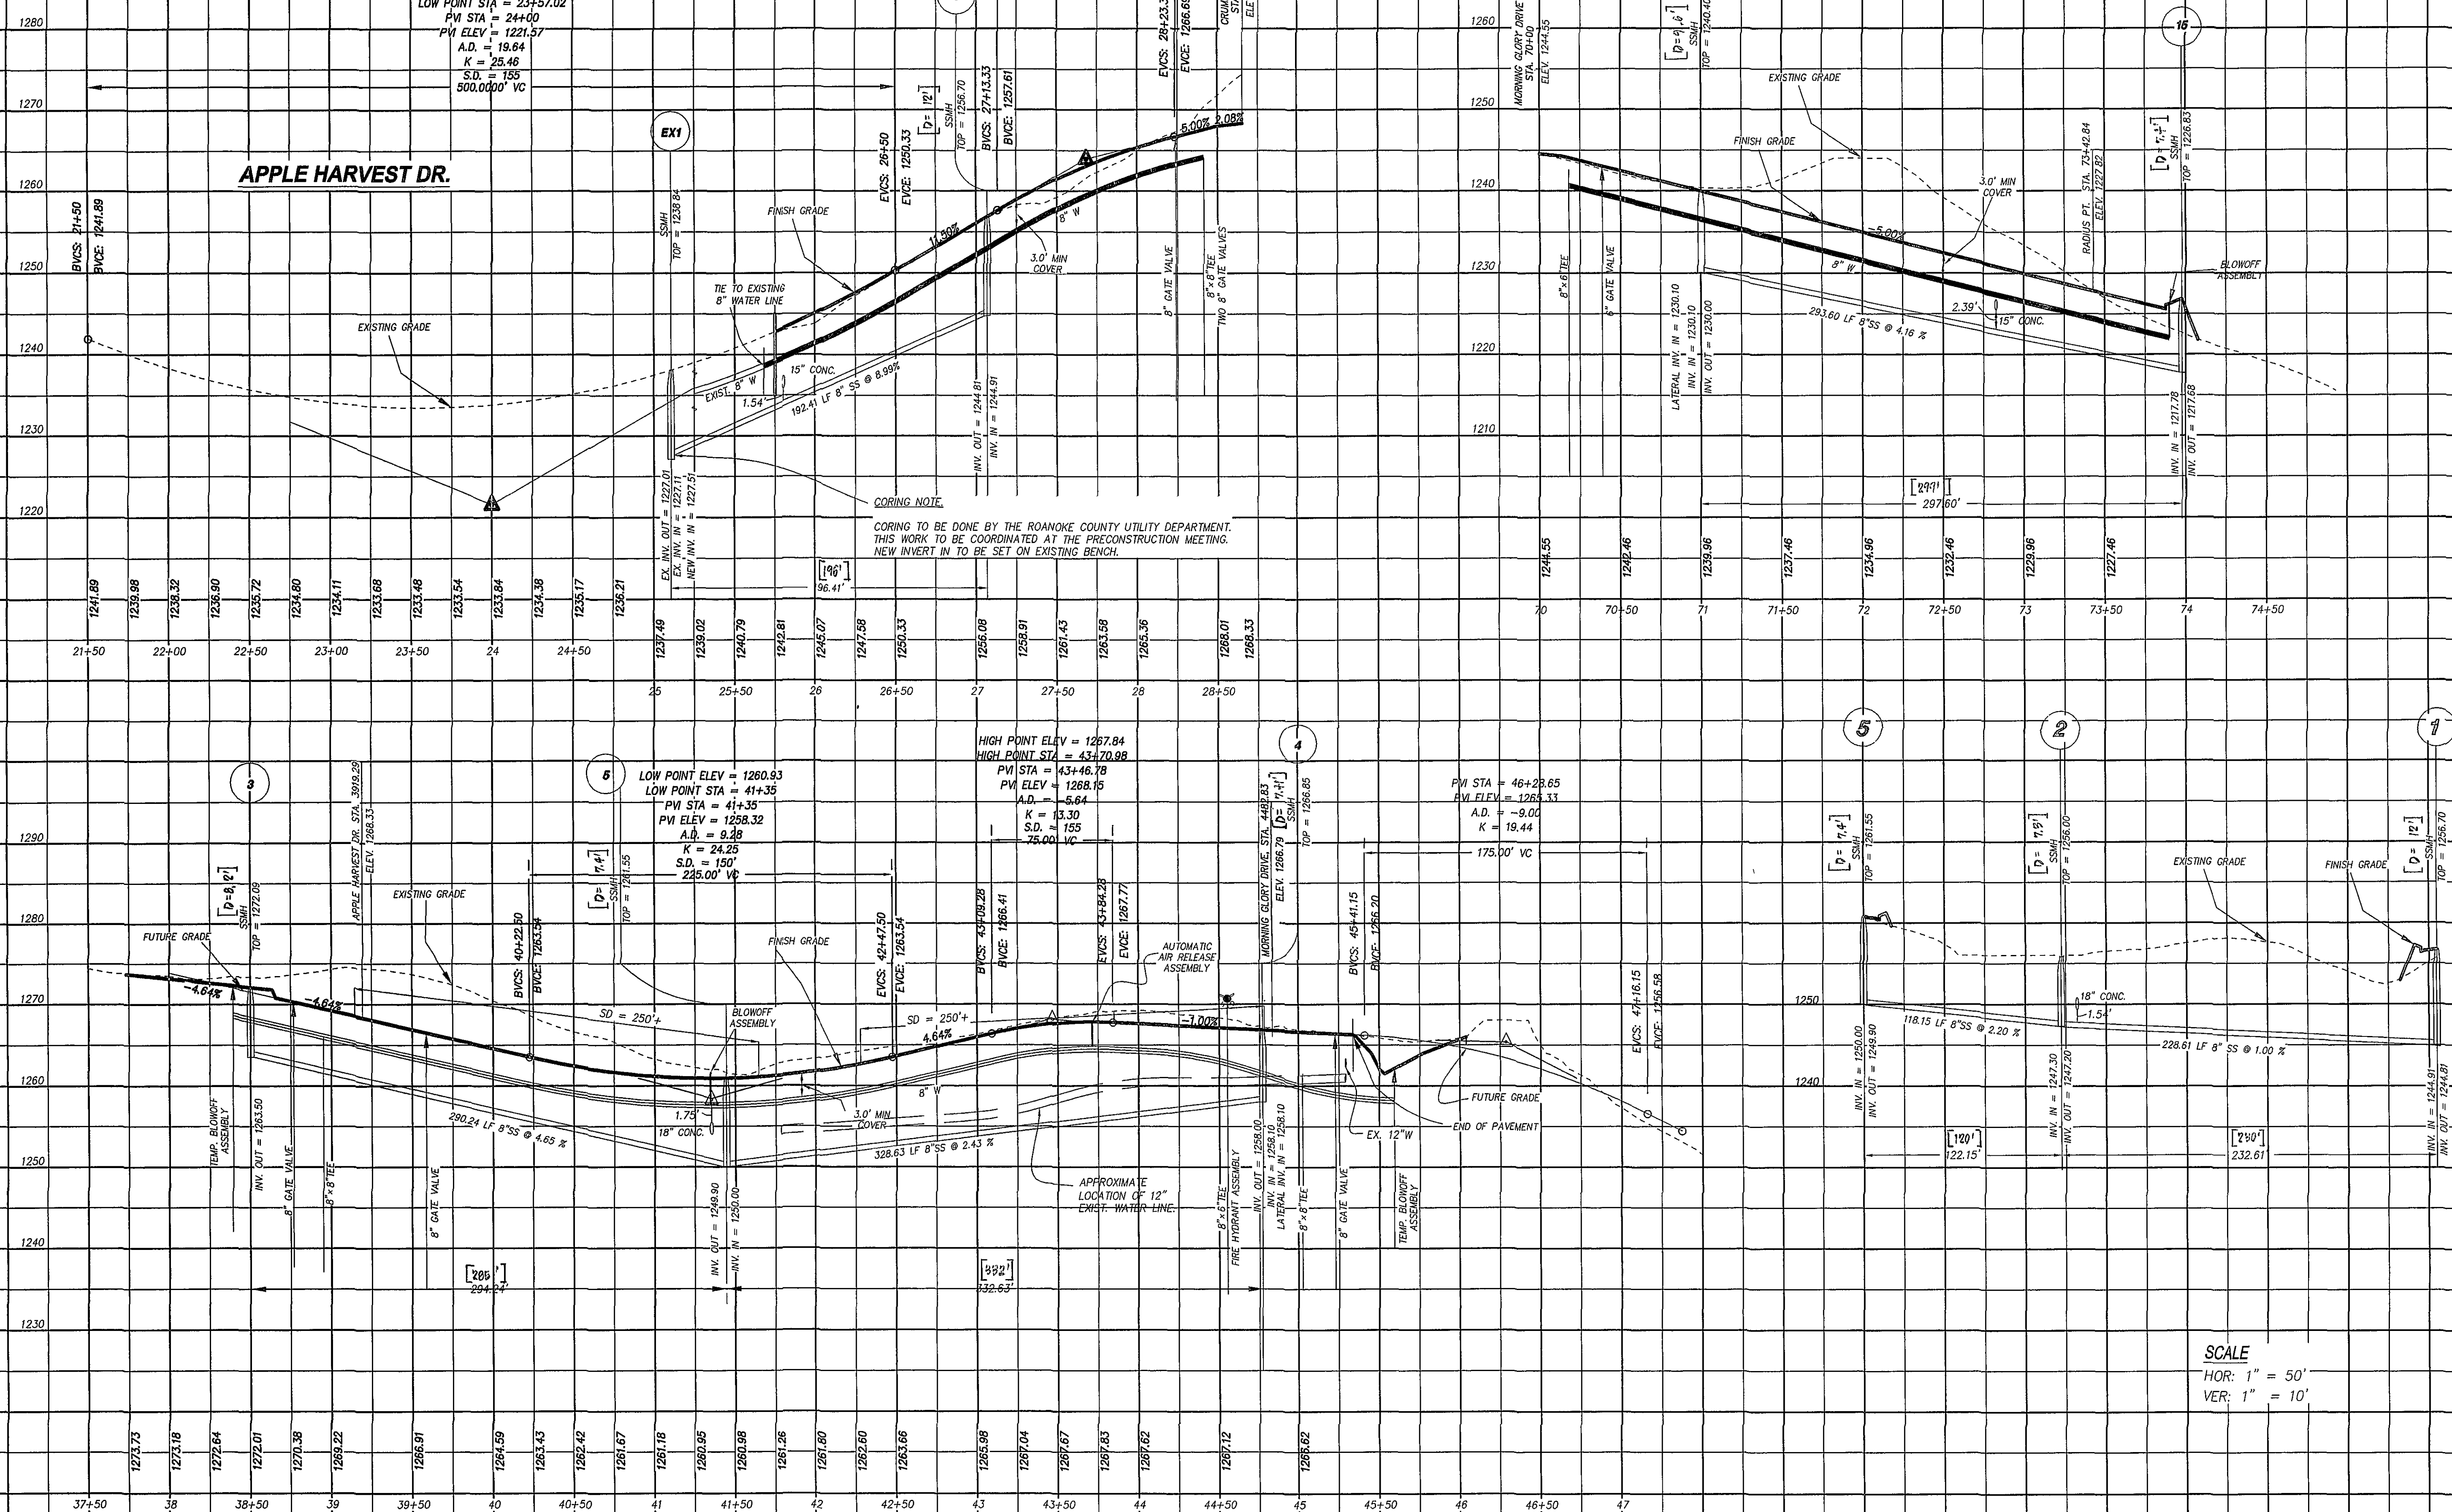

SCALE
HOR: 1" = 50'
VER: 1" = 10'

REVISIONS

NO.	DATE	DESCRIPTION
1	2/15/05	AS-BUILT #11174121 551612/
2	5/16/05	PROJECT SUBMISSION NAME & ROAD
3	9/16/2005	AS-BUILT FROM WMA
4		GPS FIELD WORK
5		

DATE: MAY 10, 2004

SCALE: AS SHOWN

COMMISSION NO: 2003-133


CADD FILE: P:\03\133\133\ENGIN\13300MP.DWG

SHEET 9 OF 13

SECTION No. 11
WISTERIA PLACE AT THE ORCHARDS
F & W COMMUNITY DEVELOPMENT CORP
HOLLIS MAGISTERIAL DISTRICT
ROANOKE COUNTY, VIRGINIA

ROAD AND
SANITARY SEWER
PROFILE

COMMONWEALTH OF VIRGINIA
THOMAS C. DALE
No. 033002
5-10-04
PROFESSIONAL ENGINEER

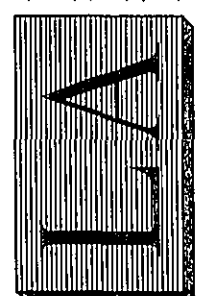

LUMSDEN ASSOCIATES, P.C.
ENGINEERS-SURVEYORS-PLANNERS
ROANOKE, VIRGINIA
4664 BRAMBLETON AVENUE
P.O. BOX 20669
ROANOKE, VIRGINIA 24018
PHONE: (540) 774-4111
FAX: (540) 772-9445
E-MAIL: MAIL@LUMSDENPC.COM