


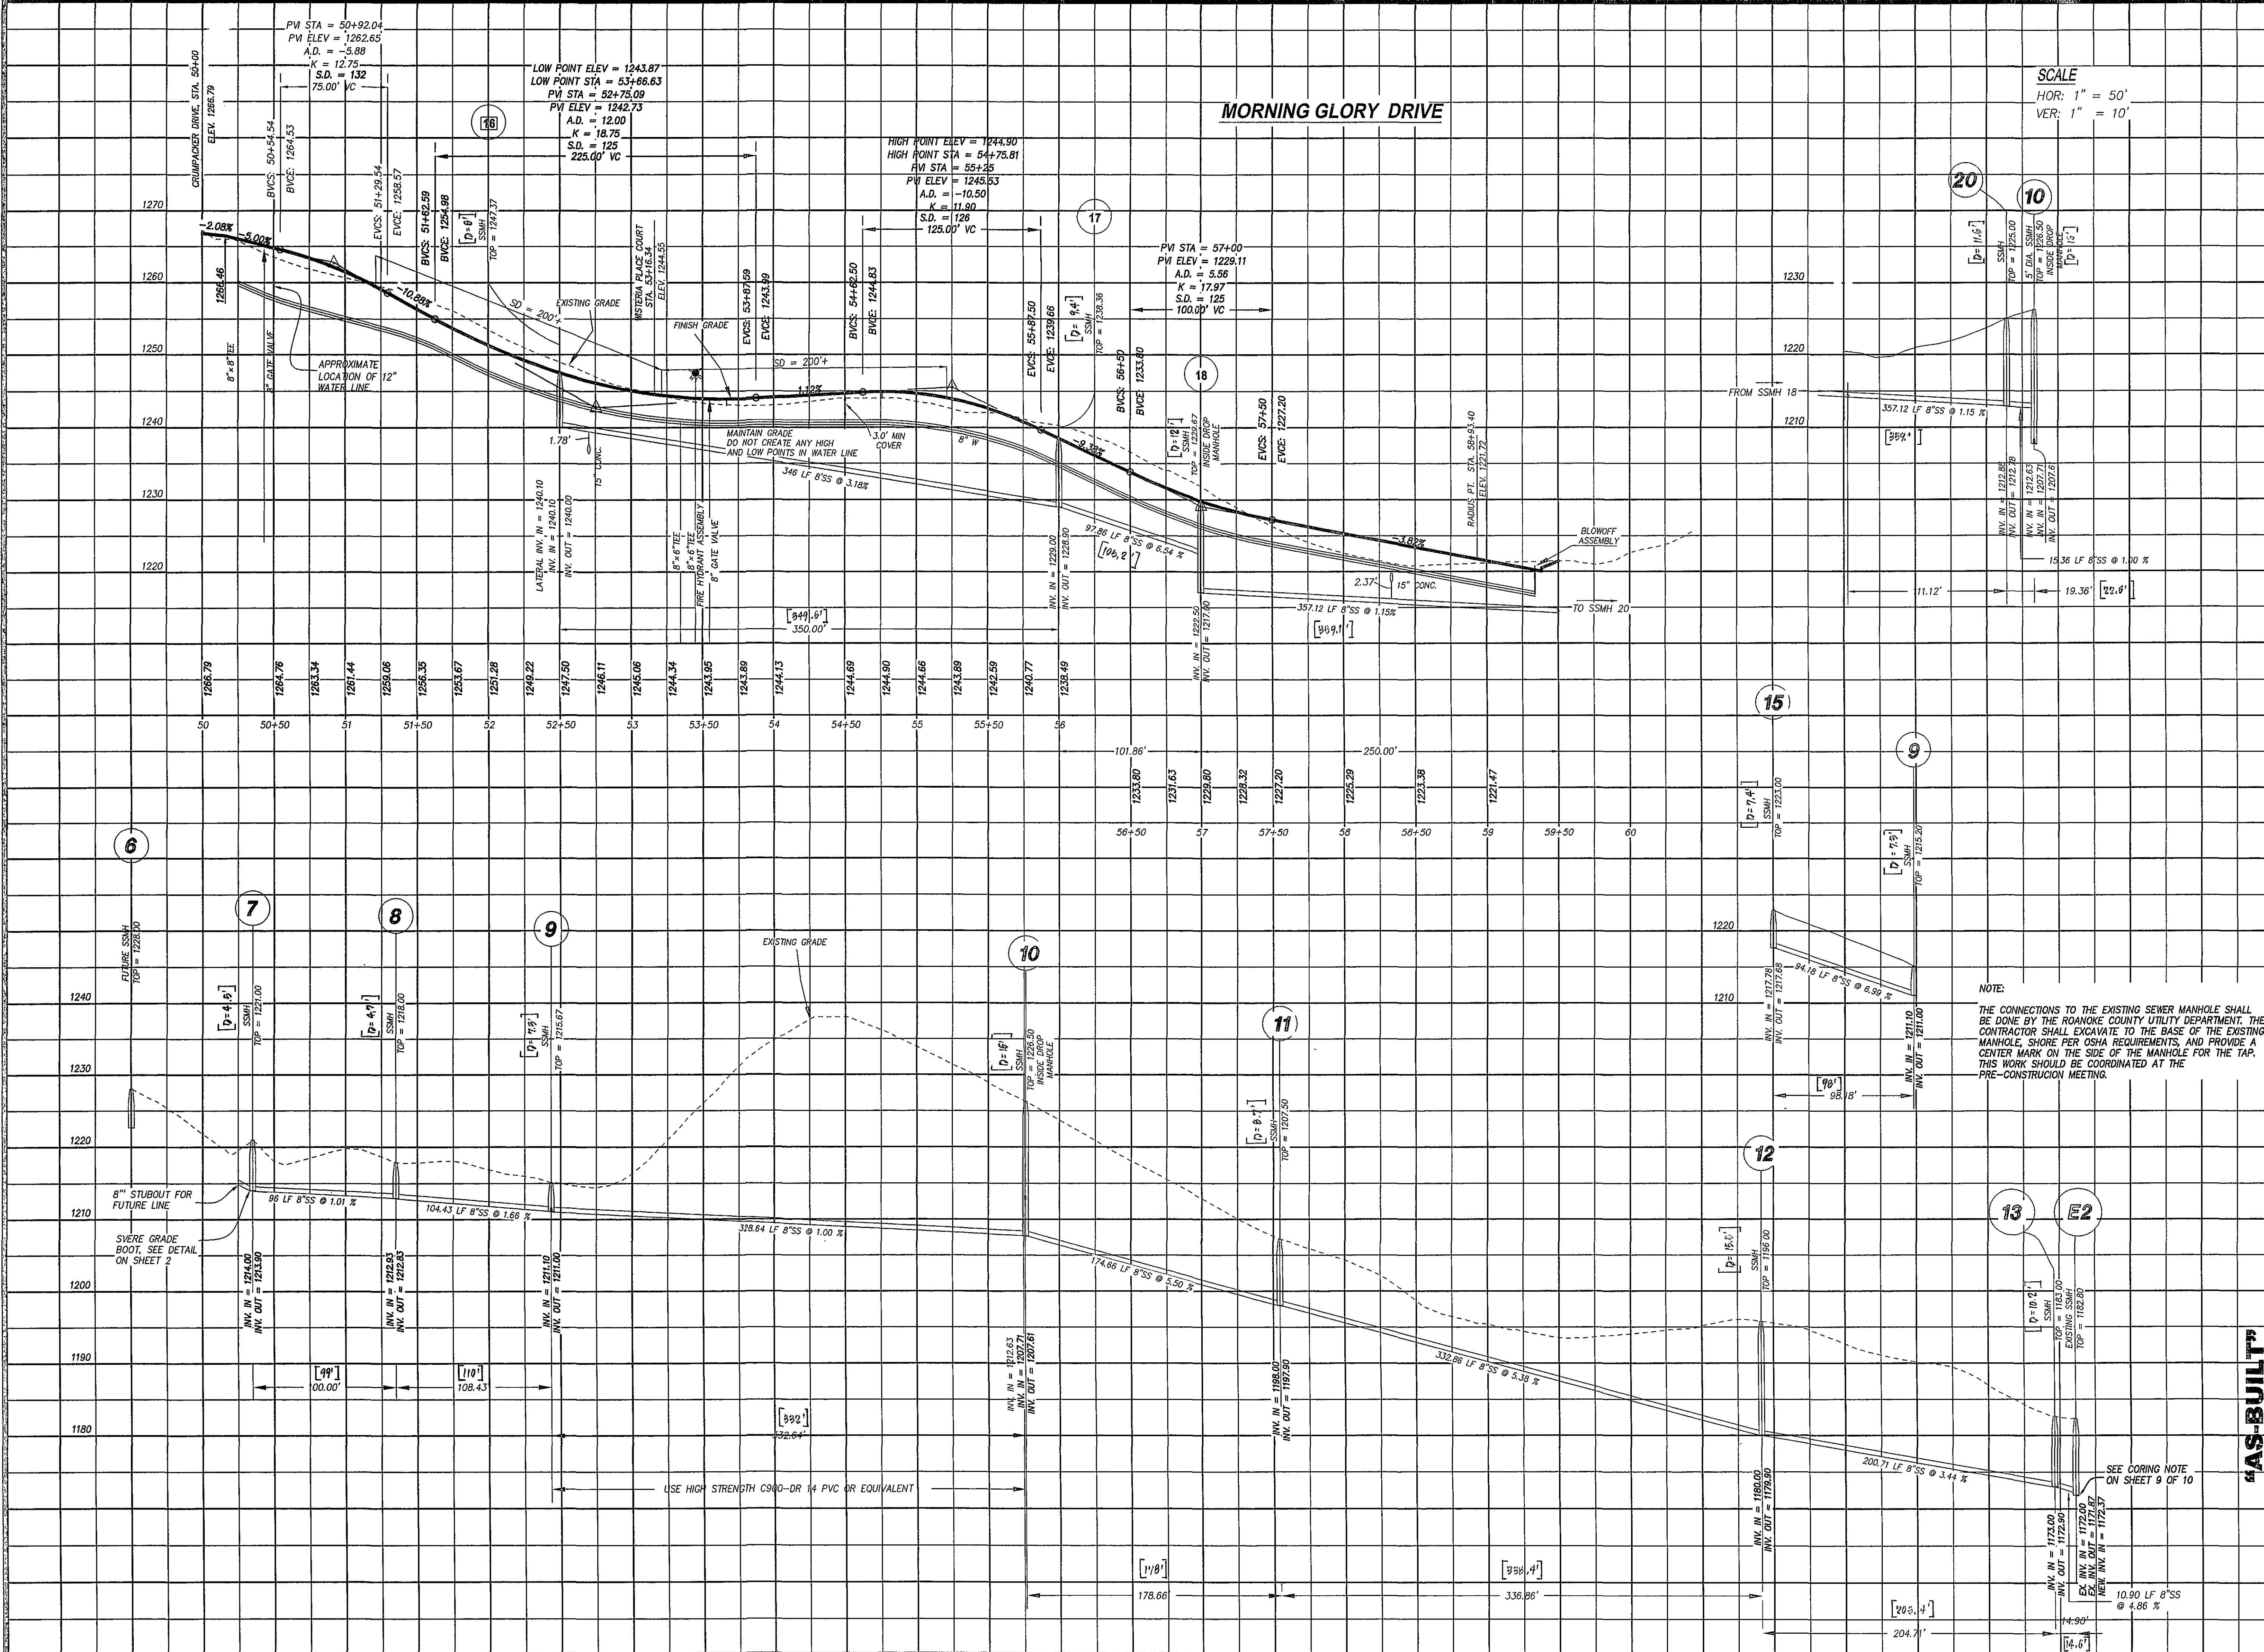

SCALE
HOR: 1" = 50'
VER: 1" = 10'

LUMSDEN ASSOCIATES, P.C.
ENGINEERS-SURVEYORS-PLANNERS
ROANOKE, VIRGINIA

THOMAS C. DALE
No. 033002
PROFESSIONAL ENGINEER

ROAD AND
SANITARY SEWER
PROFILE

SECTION No. 11
WISTERIA PLACE AT THE ORCHARDS
F & W COMMUNITY DEVELOPMENT CORP
HOLLINS MAGISTERIAL DISTRICT
ROANOKE COUNTY, VIRGINIA

"AS-BUILT"

NO.	DATE	DESCRIPTION
1	2/25/05	AS-BUILT 50'-14" T&E
2	5/10/05	REVISED SUBDIVISION NAME & ROAD
3	8/16/2005	AS-BUILTS FROM MWA GPS FIELDWORK
4		
5		

DATE: MAY 10, 2004
SCALE: AS SHOWN
COMMISSION NO.: 2003-133
CADD FILE: P:\12503\033033\ENGIN\13303COMP.DWG
SHEET 10 OF 13

PHONE: (540) 774-4411
FAX: (540) 772-9445
E-MAIL: MAIL@LUMSDENPC.COM

4664 BRAMBLETON AVENUE
P.O. BOX 20669
ROANOKE, VIRGINIA 24018